



LEGEND:

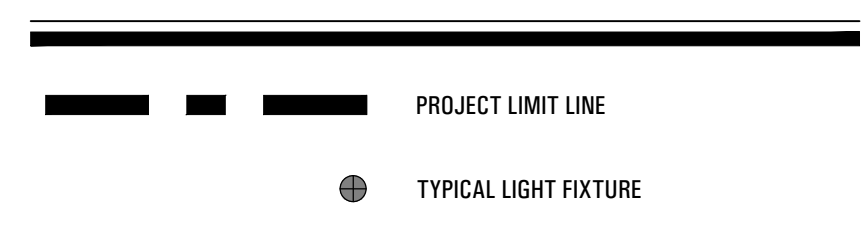

sheet location

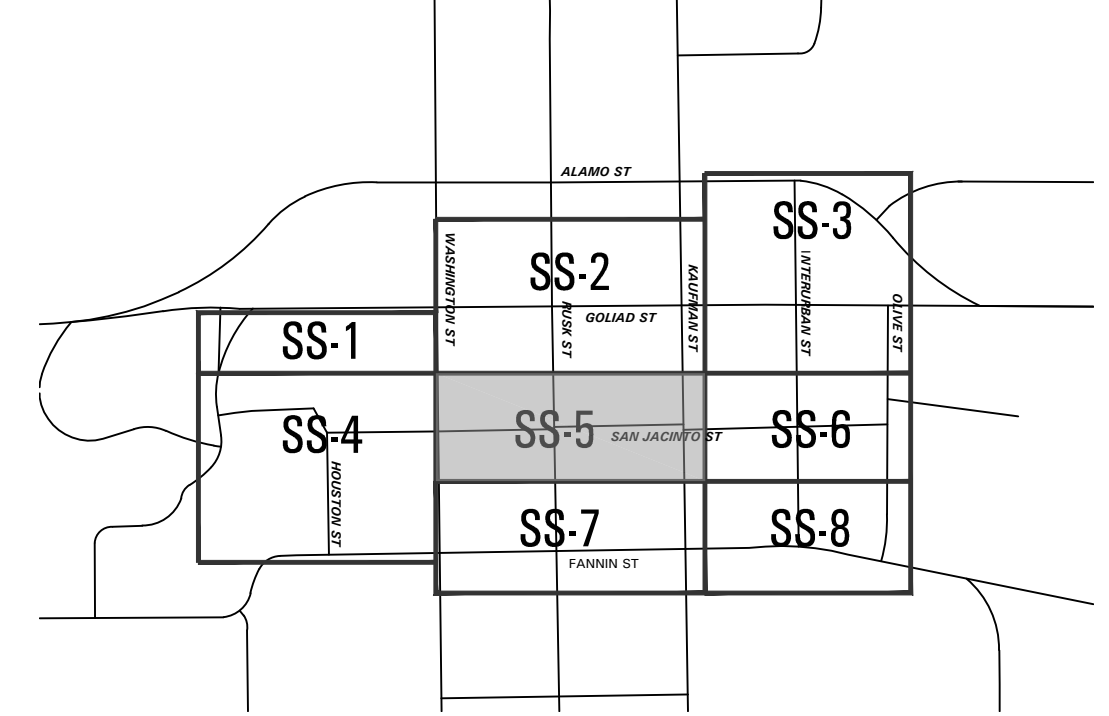

submittals / revisions

no.	date	detail
△	09/23/14	RFI #115
△	09/29/14	RFI #133
△	12/16/14	RFI #115
△	04/14/15	RFI #89

la terra studio, inc.
 12024
 Its project number
 02.26.2014
 date
 rac; bhm
 drawn by
 mtb
 checked by



02.26.2014
 sheet title
Subsurface Drainage Plan
 sheet number

SS-5
AS BUILT
 03/07/2016