
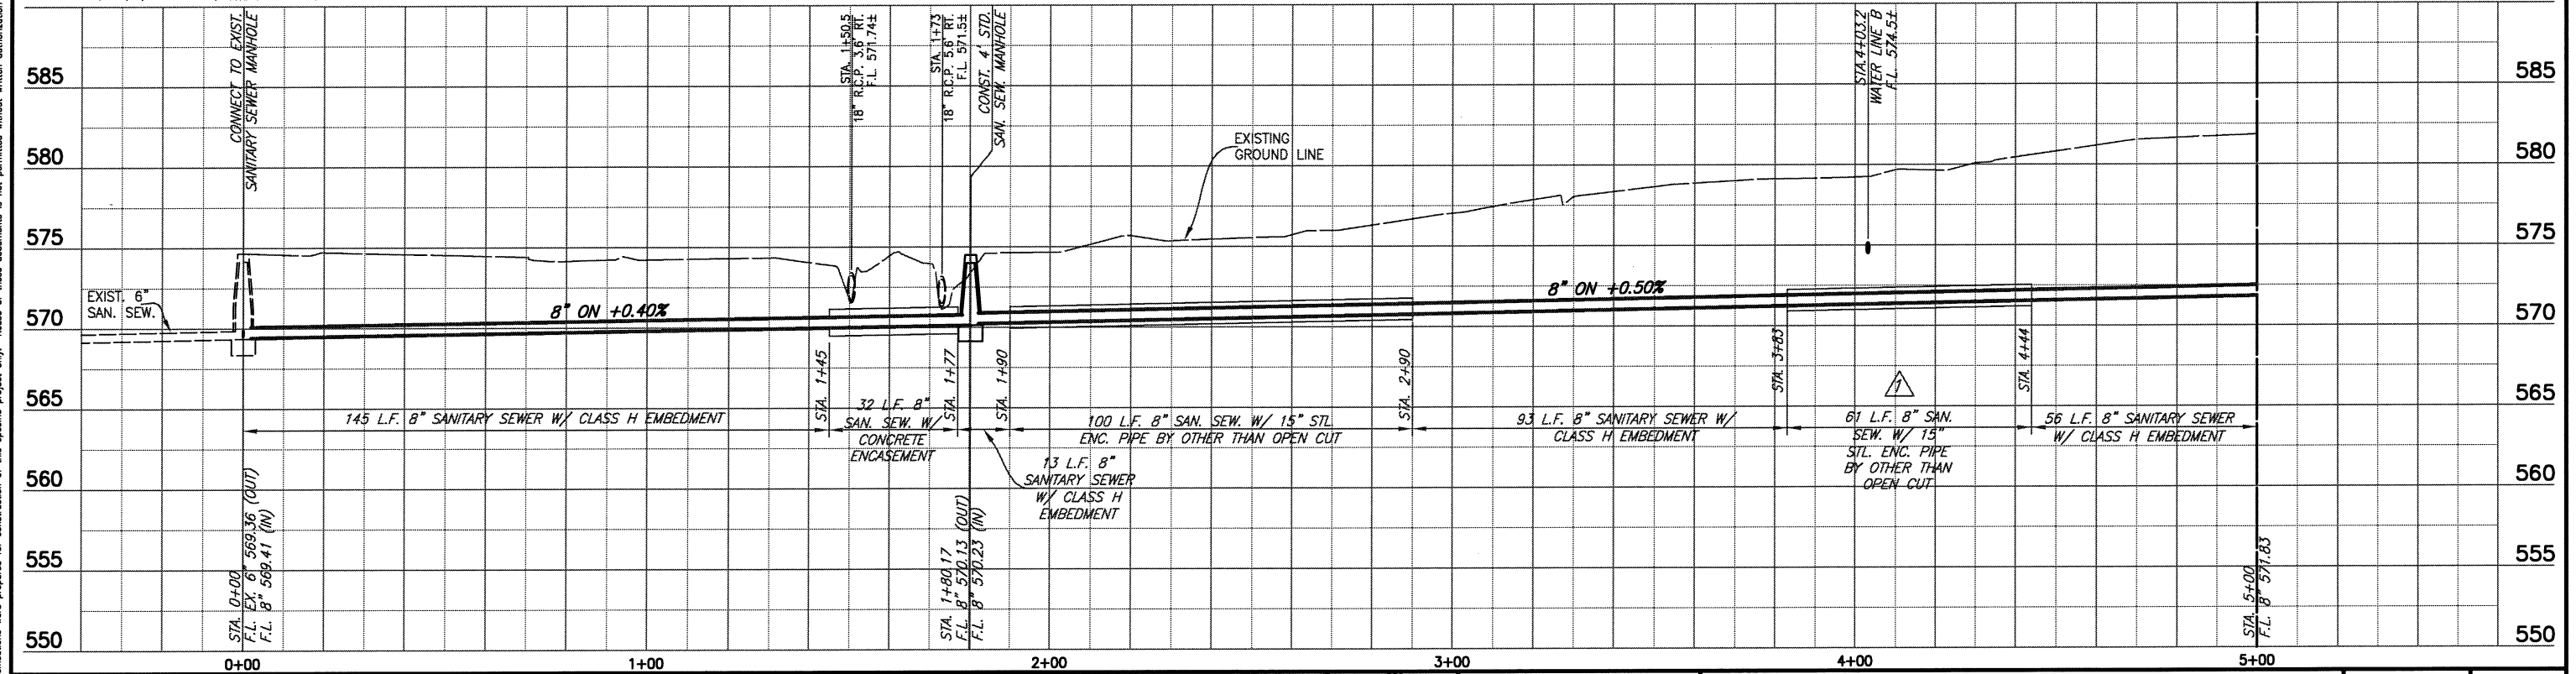


These plans and related specifications were prepared for construction of this specific project only. Reuse of these documents is not permitted without written authorization of Birkhoff, Hendricks, & Conway, L.L.P.

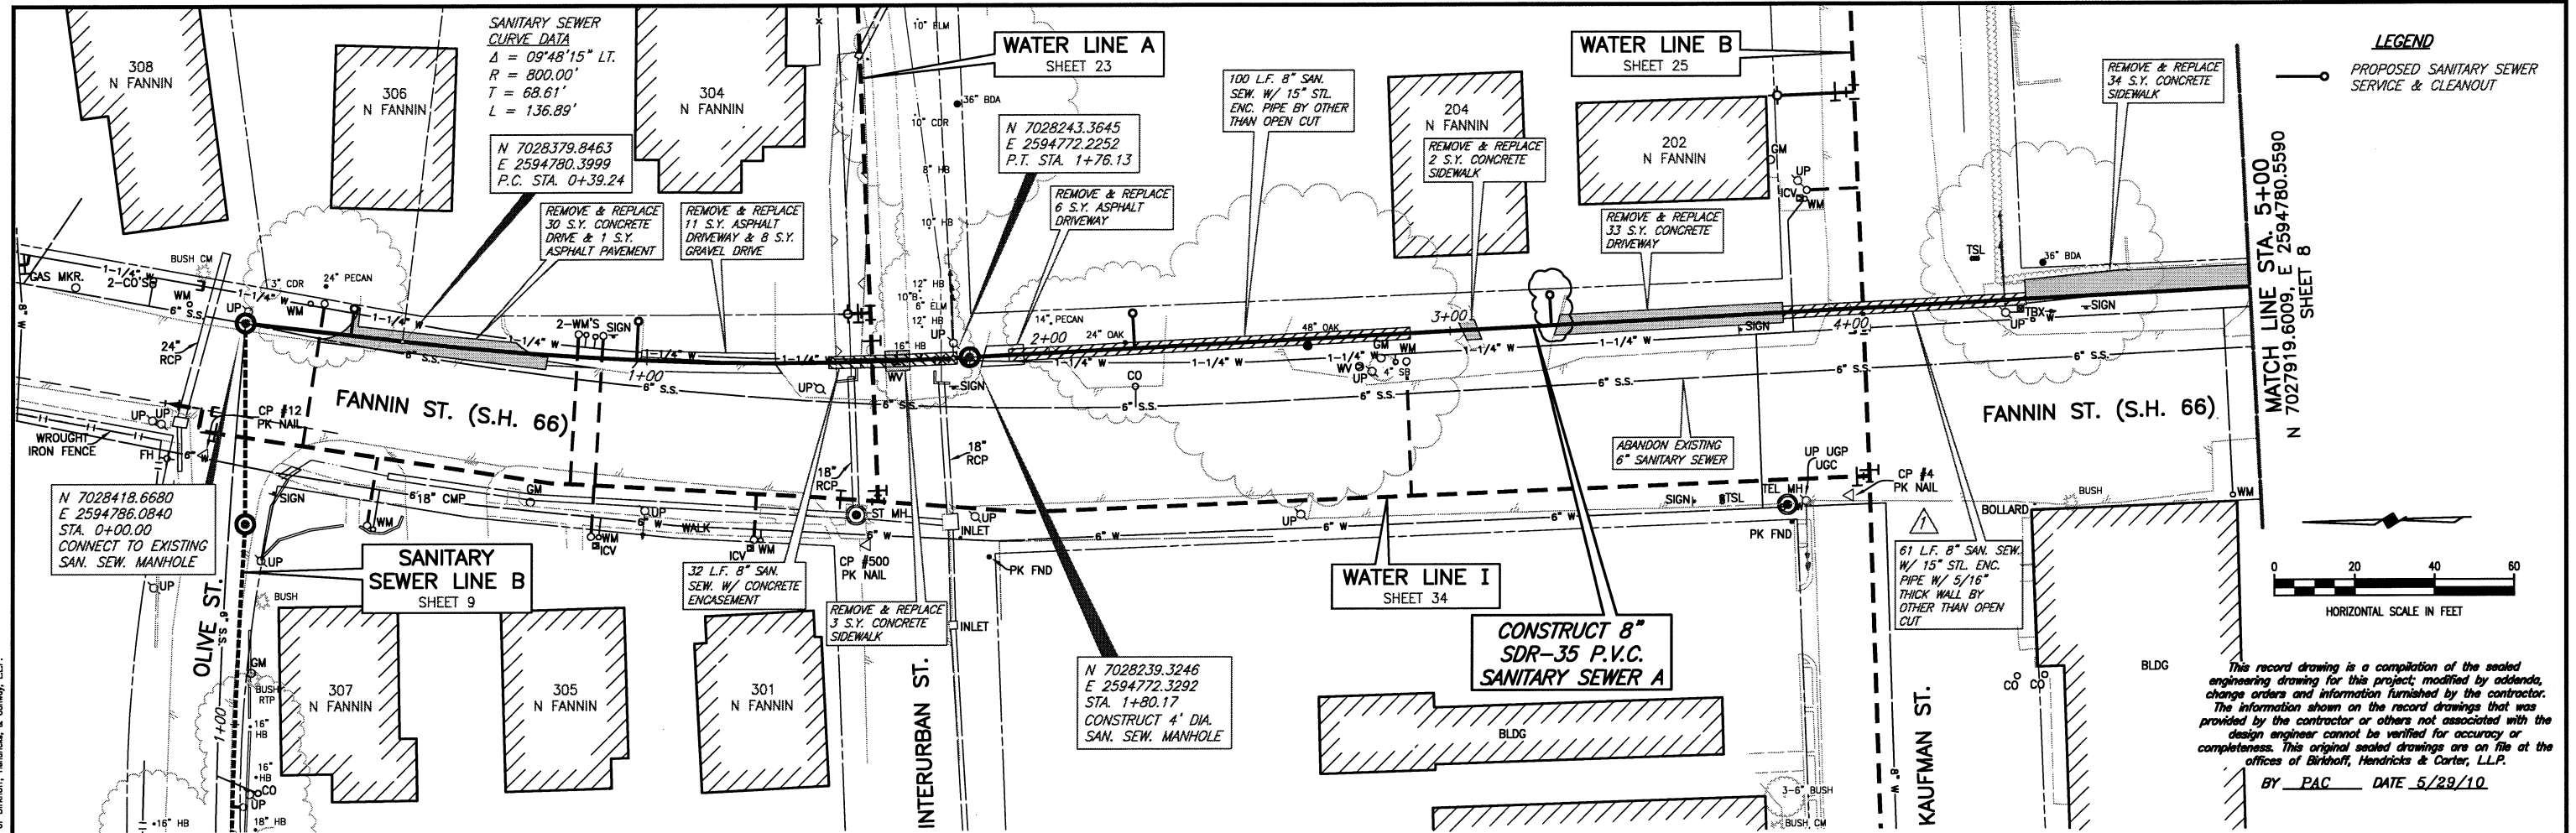

REVISION, 10-20-2008
 REVISED: DEC. 4, 2008

BIRKHOFF, HENDRICKS & CONWAY, L.L.P.
 PROFESSIONAL ENGINEERS
 11910 Greenville Ave., Suite 600
 Dallas, Texas
 (214) 361-7900

Ronald V. Conway
 12/4/08

CITY OF ROCKWALL, TEXAS
 DOWNTOWN AREA WATER AND SANITARY SEWER IMPROVEMENTS

SANITARY SEWER A - PLAN & PROFILE
 STA. 0+00 TO STA. 5+00

BHC PROJECT NO. 2007-148
 OCTOBER 2008

SHEET NO. **7**