


**LEGEND**  
 —○— PROPOSED SANITARY SEWER SERVICE & CLEANOUT

This record drawing is a compilation of the sealed engineering drawing for this project, modified by addenda, change orders and information furnished by the contractor. The information shown on the record drawings that was provided by the contractor or others not associated with the design engineer cannot be verified for accuracy or completeness. This original sealed drawings are on file at the offices of Birkhoff, Hendricks & Conway, L.L.P.  
 BY PAC DATE 5/29/10

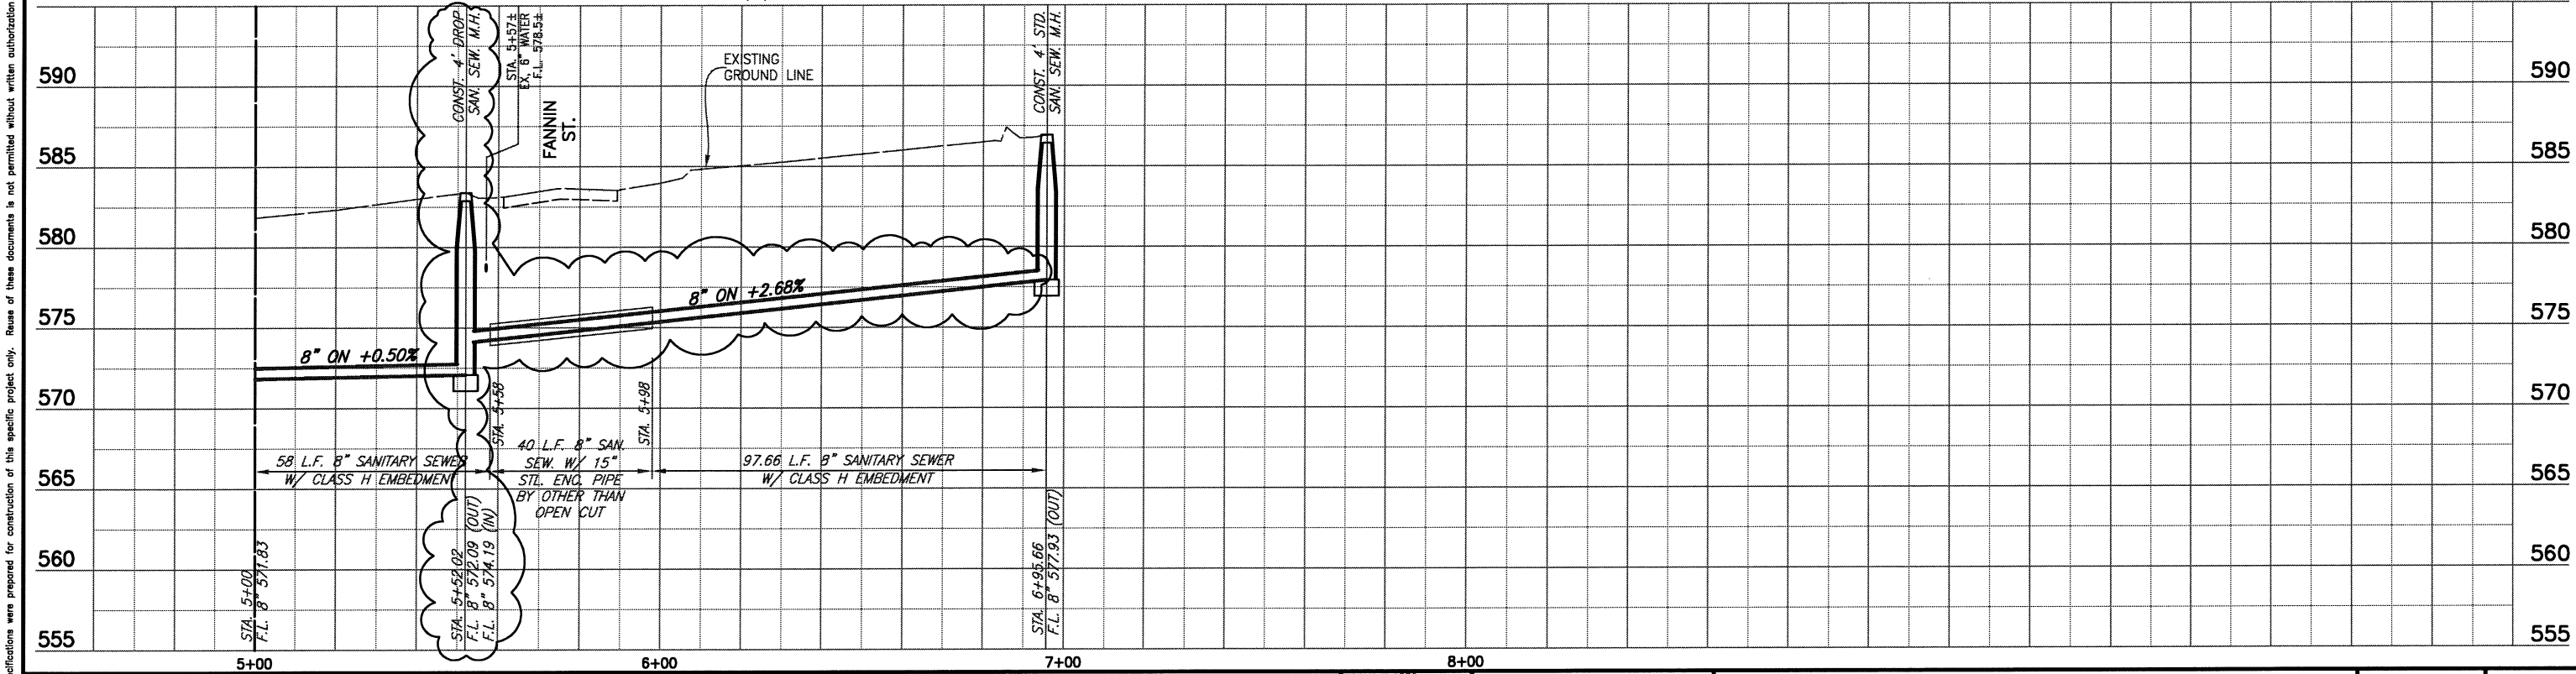

REVISED NOV. 24, 2008

**BIRKHOFF, HENDRICKS & CONWAY, L.L.P.**  
 PROFESSIONAL ENGINEERS  
 11910 Greenville Ave., Suite 600  
 Dallas, Texas  
 (214) 361-7900



*Ronald V. Conway*  
 12/4/08

**CITY OF ROCKWALL, TEXAS**  
 DOWNTOWN AREA WATER AND SANITARY SEWER IMPROVEMENTS  
**SANITARY SEWER A - PLAN & PROFILE**  
 STA. 5+00 TO STA. 6+95.66

BHC PROJECT NO. 2007-148  
 OCTOBER 2008  
 SHEET NO. **8**