

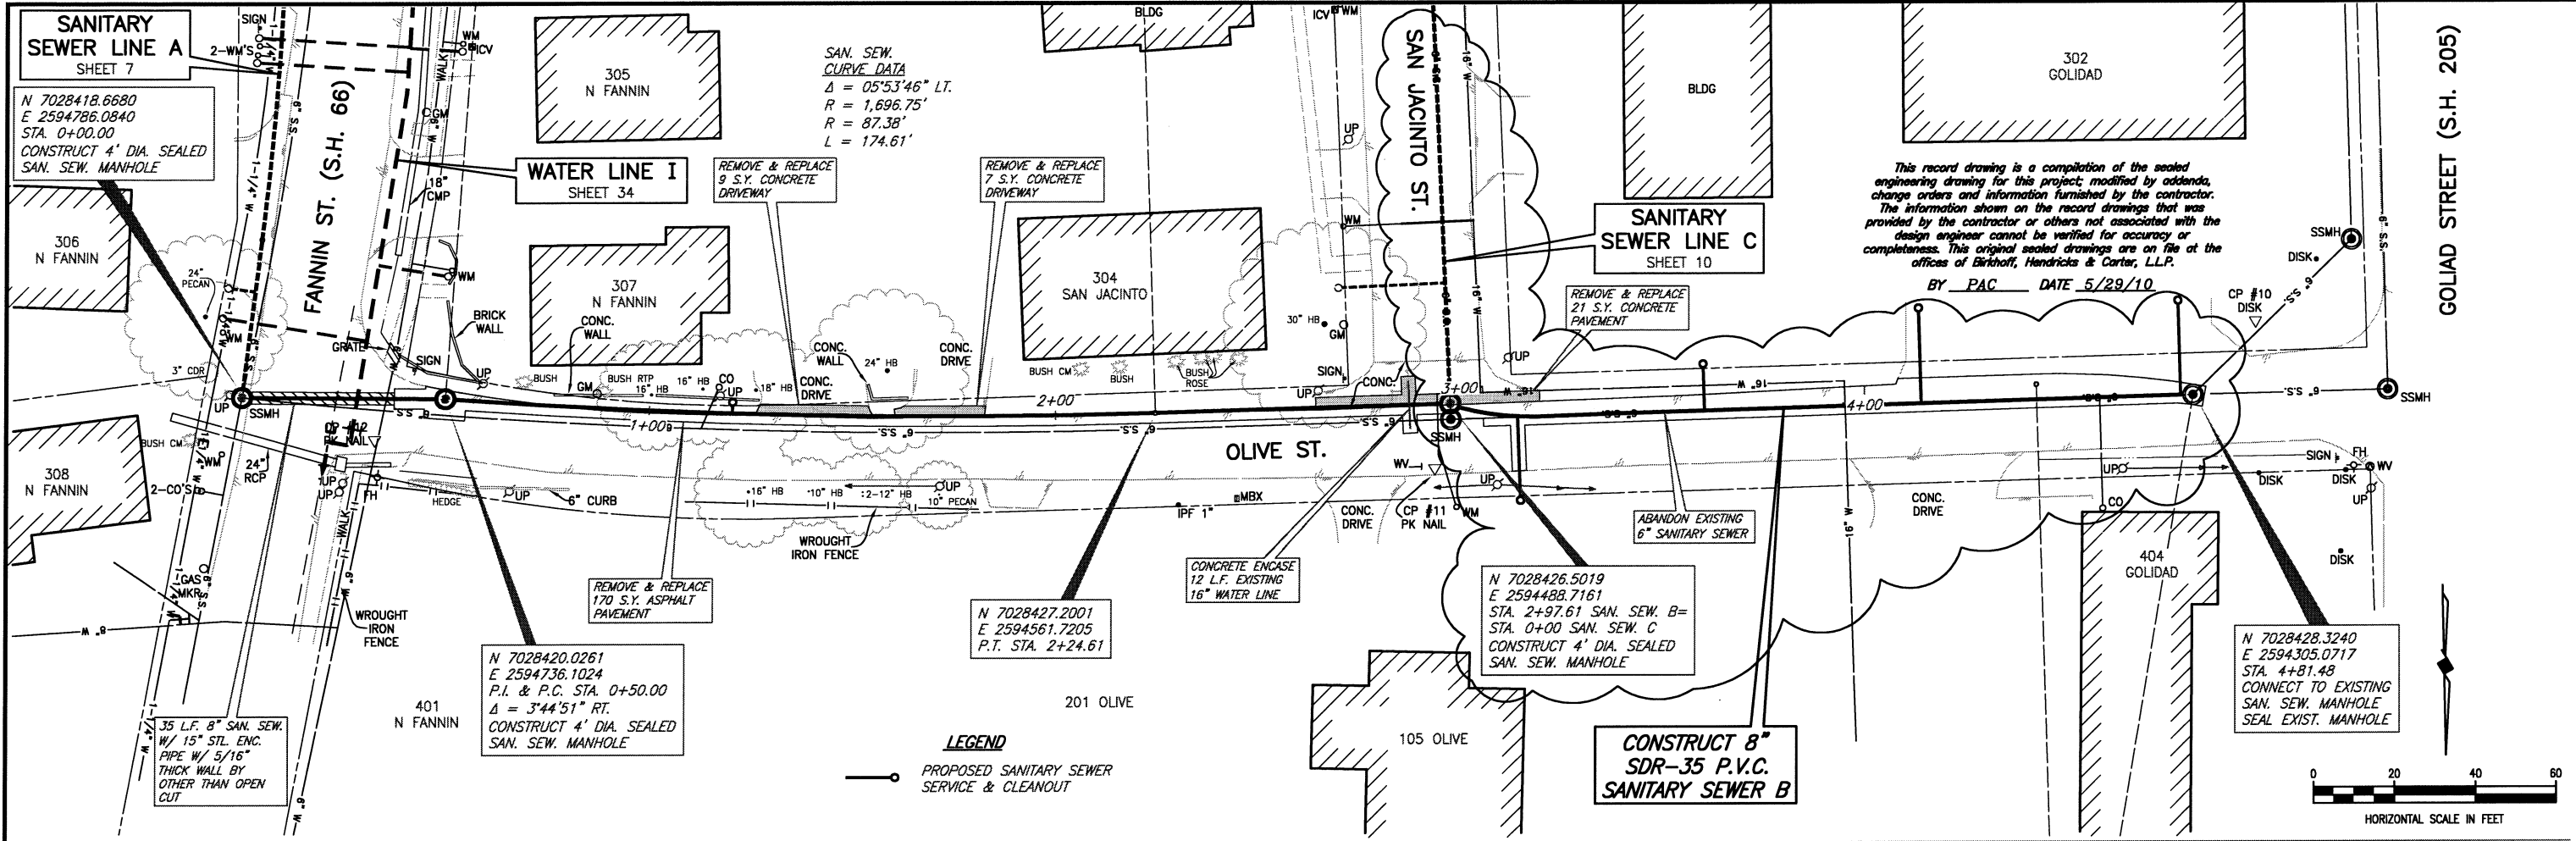


These plans and related specifications were prepared for construction of this specific project only. Reuse of these documents is not permitted without written authorization of Birkhoff, Hendricks & Conway, L.L.P.

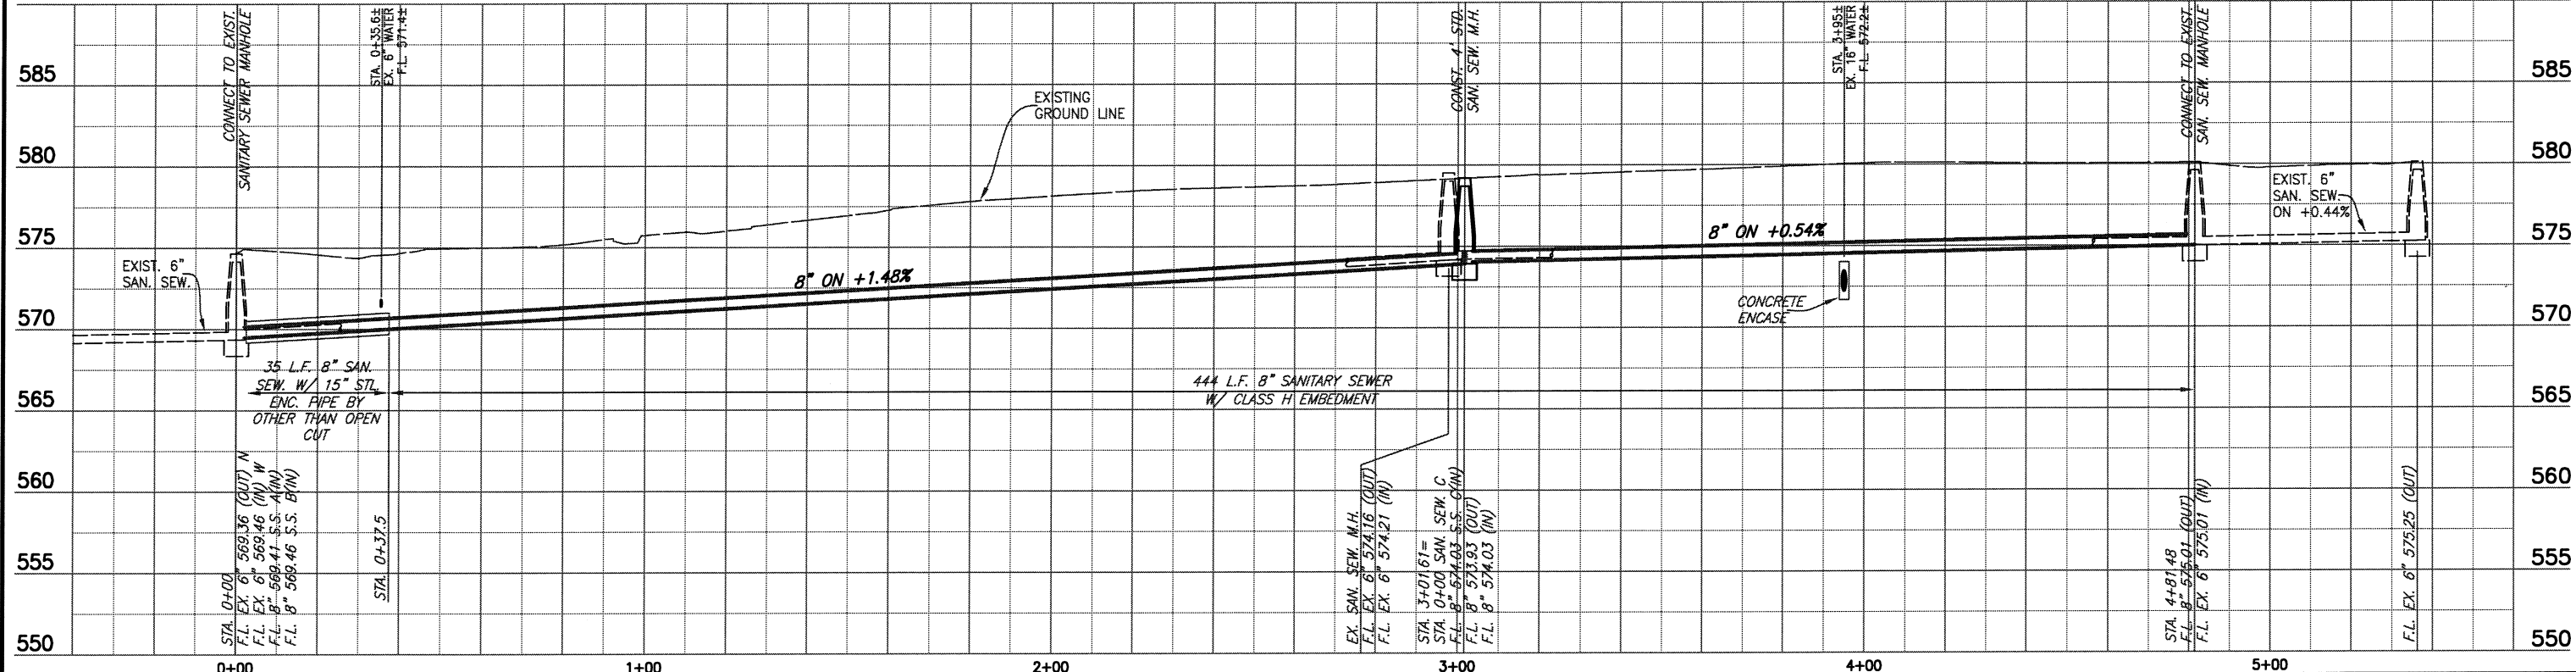

This record drawing is a compilation of the sealed engineering drawing for this project; modified by addenda, change orders and information furnished by the contractor. The information shown on the record drawings that was provided by the contractor or others not associated with the design engineer cannot be verified for accuracy or completeness. This original sealed drawing is on file at the offices of Birkhoff, Hendricks & Conway, L.L.P.
BY PAC DATE 5/29/10

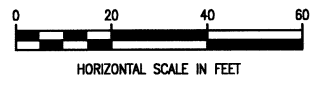

REVISED: NOV. 24, 2008
REVISED: DEC. 4, 2008

BIRKHOFF, HENDRICKS & CONWAY, L.L.P.
PROFESSIONAL ENGINEERS
11910 Greenville Ave., Suite 600
Dallas, Texas
(214) 361-7900

STATE OF TEXAS
RONALD V. CONWAY
37891
PROFESSIONAL ENGINEER

Ronald V. Conway
12/4/08

CITY OF ROCKWALL, TEXAS
DOWNTOWN AREA WATER AND SANITARY SEWER IMPROVEMENTS
SANITARY SEWER B - PLAN & PROFILE
STA. 0+00 TO STA. 4+81.48

BHC PROJECT NO. 2007-148
OCTOBER 2008

SHEET NO. **9**