
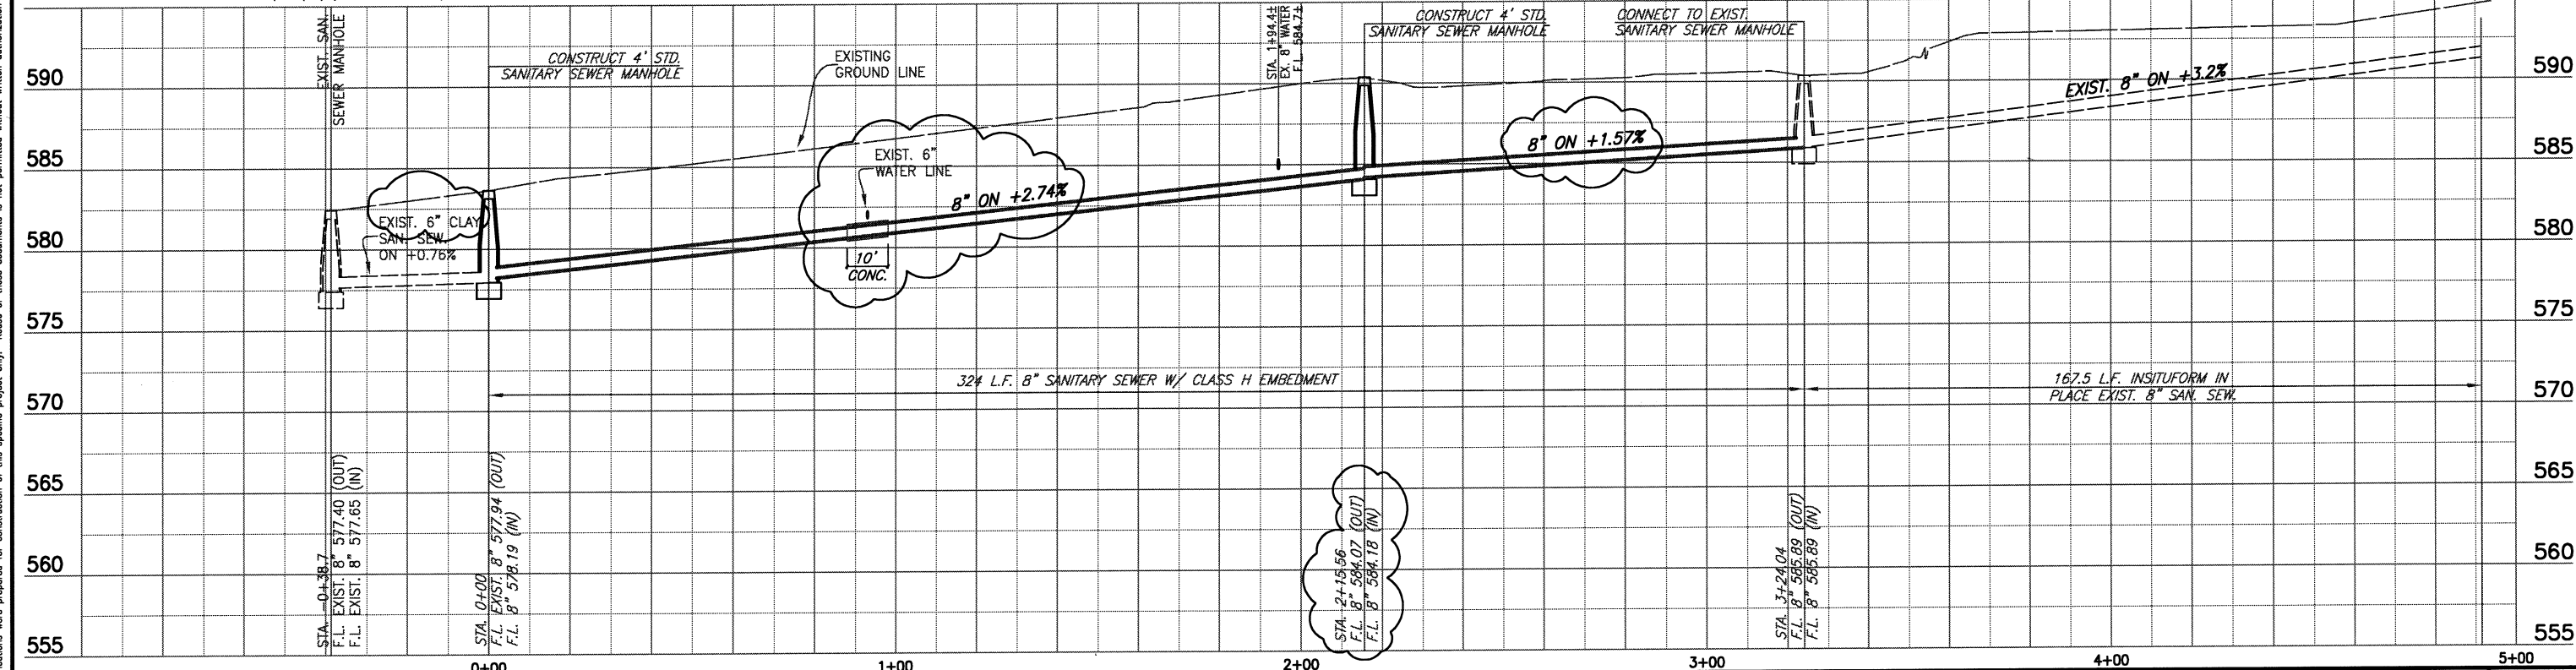


These plans and related specifications were prepared for construction of this specific project only. Reuse of these documents is not permitted without written authorization of Birkhoff, Hendricks, & Conway, L.L.P.

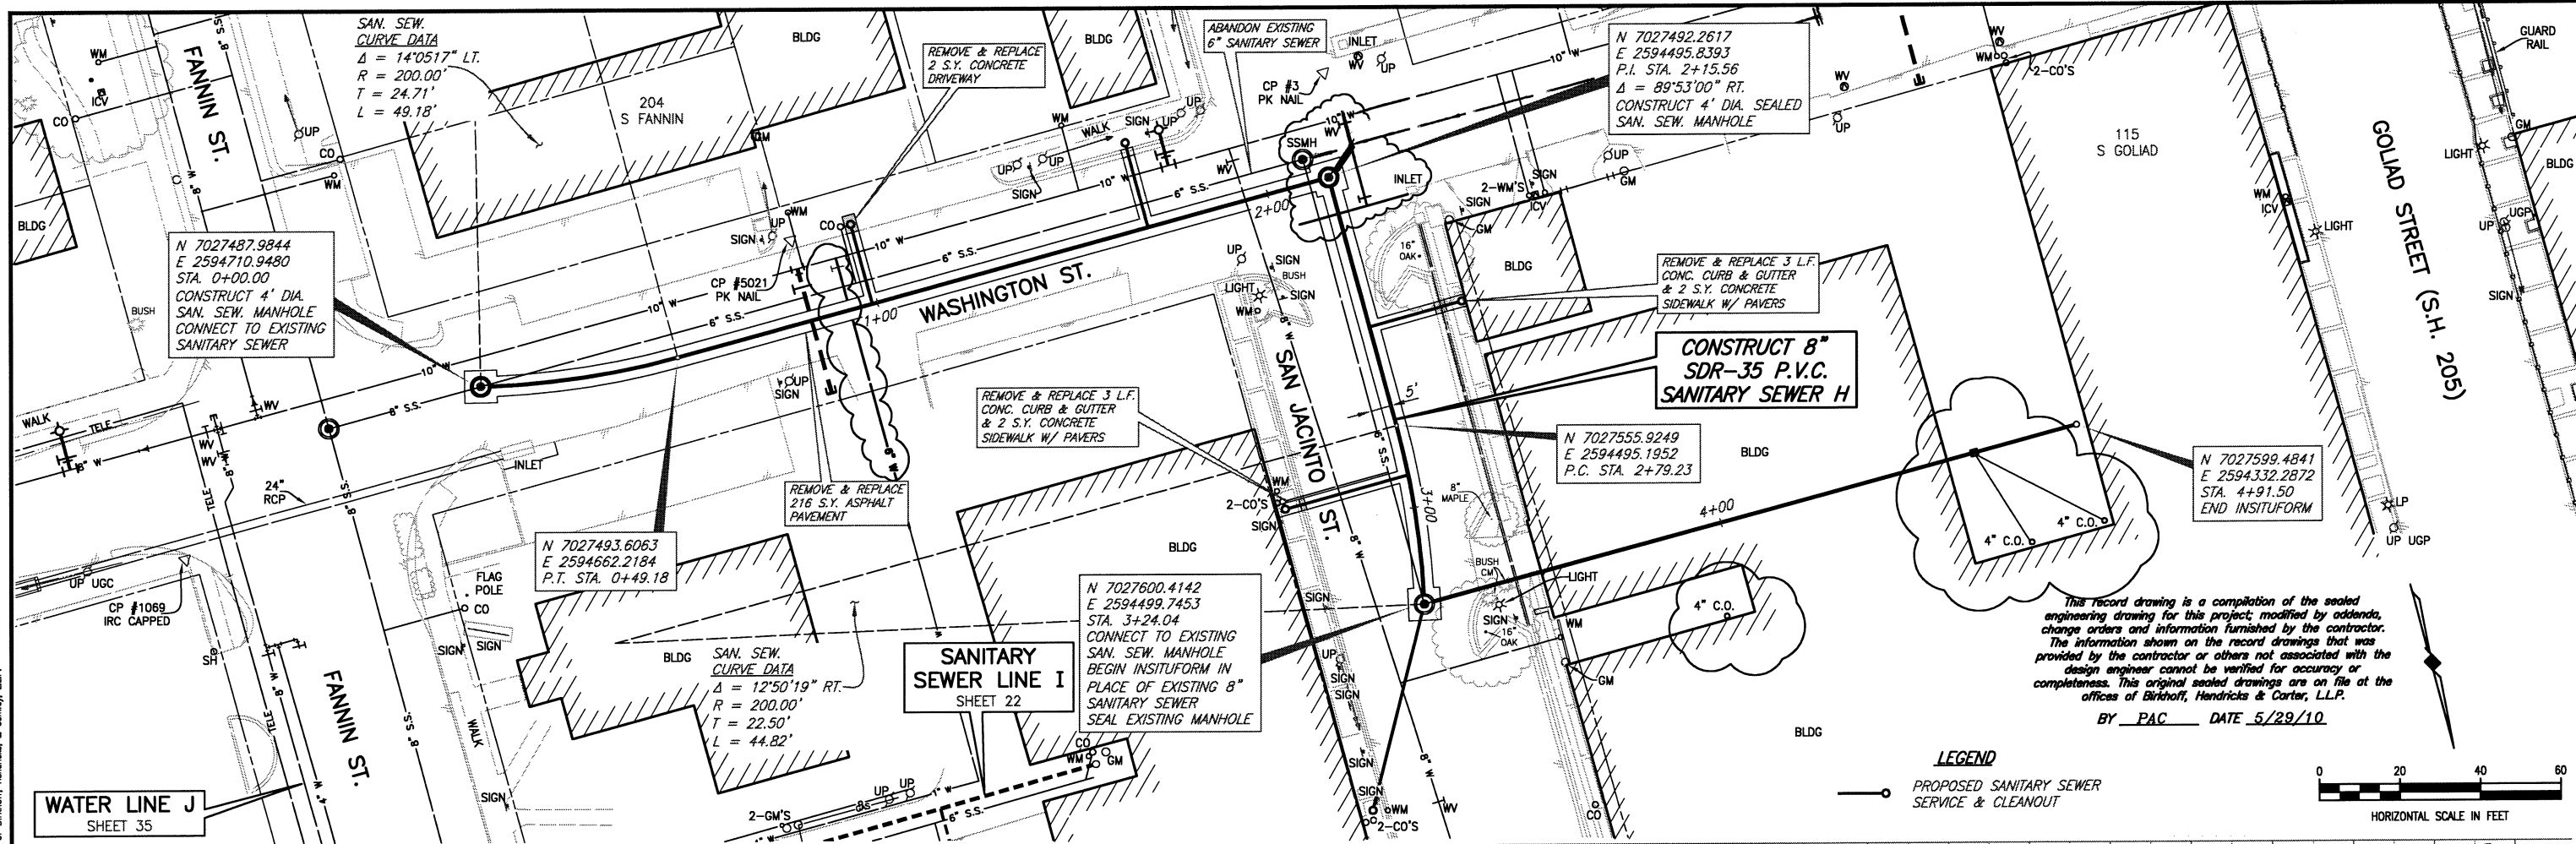

REVISED: NOV. 24, 2008	<b>BIRKHOFF, HENDRICKS &amp; CONWAY, L.L.P.</b> PROFESSIONAL ENGINEERS 11910 Greenville Ave., Suite 600 Dallas, Texas (214) 361-7900	 <i>Ronald V. Conway</i> 12/4/08	<b>CITY OF ROCKWALL, TEXAS</b> DOWNTOWN AREA WATER AND SANITARY SEWER IMPROVEMENTS <b>SANITARY SEWER H - PLAN &amp; PROFILE</b> STA. 0+00 TO STA. 4+05	BHC PROJECT NO. 2007-148	SHEET NO. <b>21</b>
				OCTOBER 2008	