


LEGEND
 PROPOSED WATER SERVICE W/
 WATER METER & METER BOX

N 7028024.0465
 E 2595251.5649
 P.I. STA. 11+09.26
 $\Delta = 45^{\circ}00'00''$ RT.
 FURNISH & INSTALL:
 1-8" 45' BEND

N 7028024.5508
 E 2595282.7287
 P.I. STA. 11+43.94
 $\Delta = 45^{\circ}00'00''$ RT.
 FURNISH & INSTALL:
 1-8" 45' BEND

N 7028024.9676
 E 2595308.4887
 STA. 11+69.71 W.L. B=
 STA. 1+44.27 W.L. E
 FURNISH & INSTALL:
 1-8"x8" CROSS

**CONSTRUCT 8" P.V.C.
 WATER LINE B**

N 7028035.6993
 E 2595579.1135
 STA. 3+13.56
 CONNECT TO EXISTING
 8" WATER LINE
 FURNISH & INSTALL:
 1-8"x8" TAPPING
 SLEEVE & VALVE

N 7028019.8673
 E 2595255.8816
 P.I. STA. 11+15.26
 $\Delta = 45^{\circ}00'00''$ LT.
 FURNISH & INSTALL:
 1-8" 45' BEND

N 7028020.2341
 E 2595278.5495
 P.I. STA. 11+37.93
 $\Delta = 45^{\circ}00'00''$ LT.
 FURNISH & INSTALL:
 1-8" 45' BEND


SHEET 26
 N 7028023.8967, E 2595242.3110
 MATCH LINE STA. 11+00

WATER LINE E
 SHEET 30


WATER LINE E
 SHEET 30

**SANITARY
 SEWER LINE D**
 SHEET 11 & 12

This record drawing is a compilation of the sealed engineering drawing for this project, modified by addenda, change orders and information furnished by the contractor. The information shown on the record drawings that was provided by the contractor or others not associated with the design engineer cannot be verified for accuracy or completeness. This original sealed drawings are on file at the offices of Birkhoff, Hendricks & Conway, L.L.P.
 BY PAC DATE 5/29/10

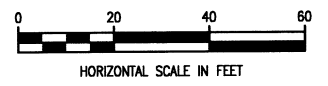

These plans and related specifications were prepared for construction of this specific project only. Reuse of these documents is not permitted without written authorization of Birkhoff, Hendricks, & Conway, L.L.P.

REVISED: NOV. 24, 2008	BIRKHOFF, HENDRICKS & CONWAY, L.L.P. PROFESSIONAL ENGINEERS 11910 Greenville Ave., Suite 600 Dallas, Texas (214) 361-7900	 <i>Ronald V. Conway</i> 12/4/08	CITY OF ROCKWALL, TEXAS DOWNTOWN AREA WATER AND SANITARY SEWER IMPROVEMENTS	BHC PROJECT NO. 2007-148	SHEET NO.
			WATER LINE B - PLAN STA. 11+00 TO STA. 14+36.93	OCTOBER 2008	27