

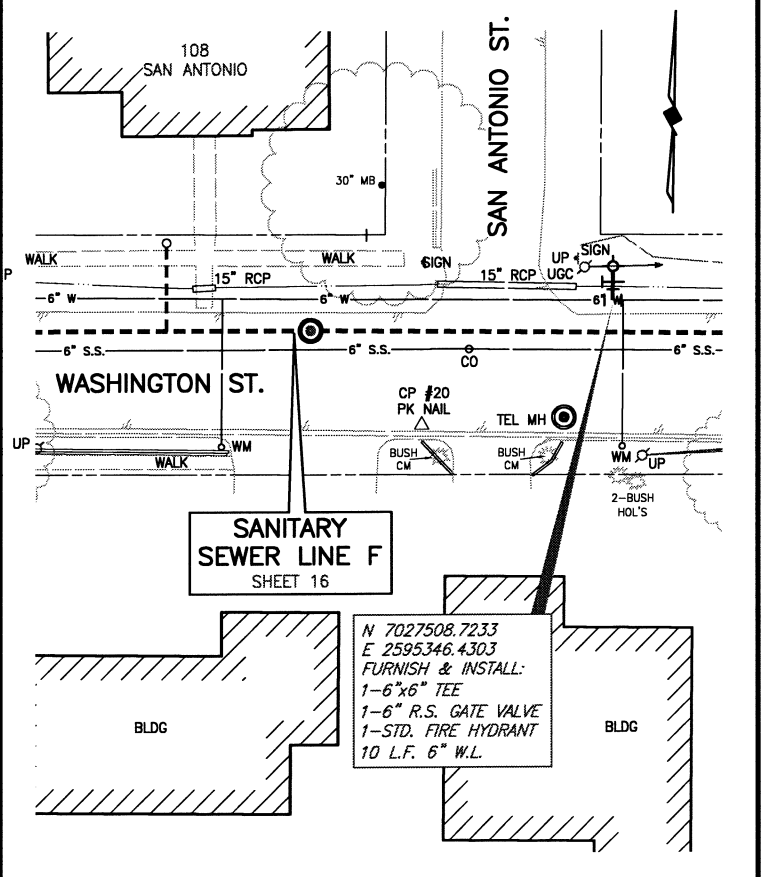
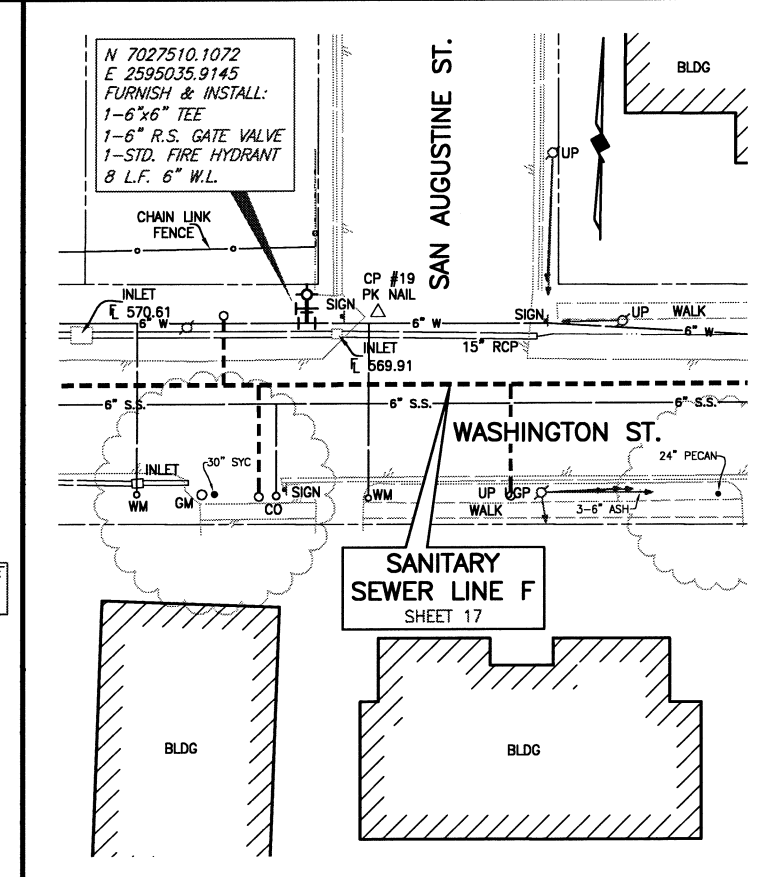
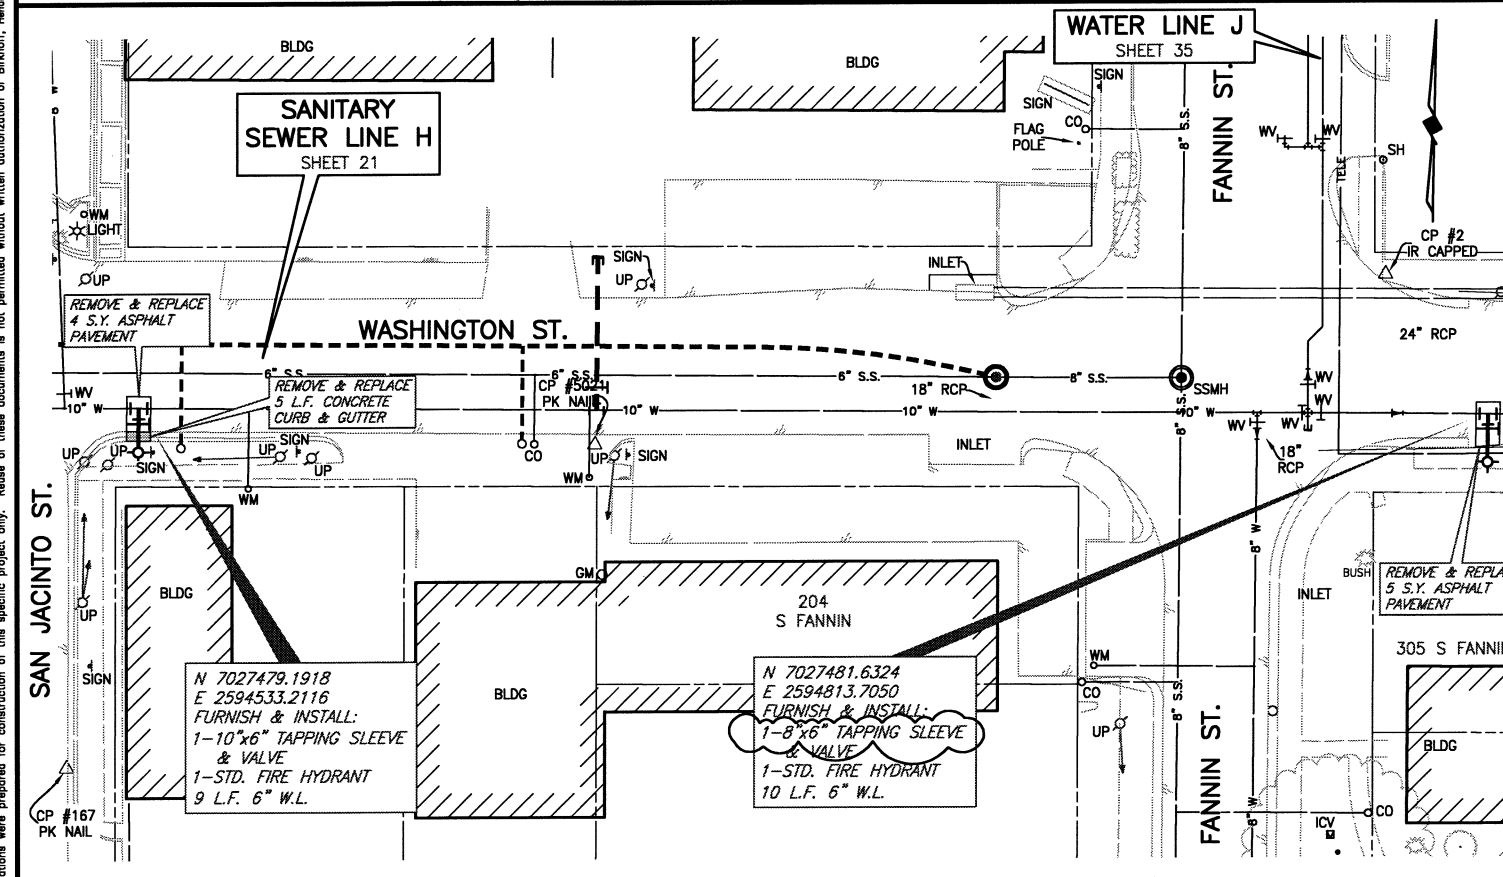
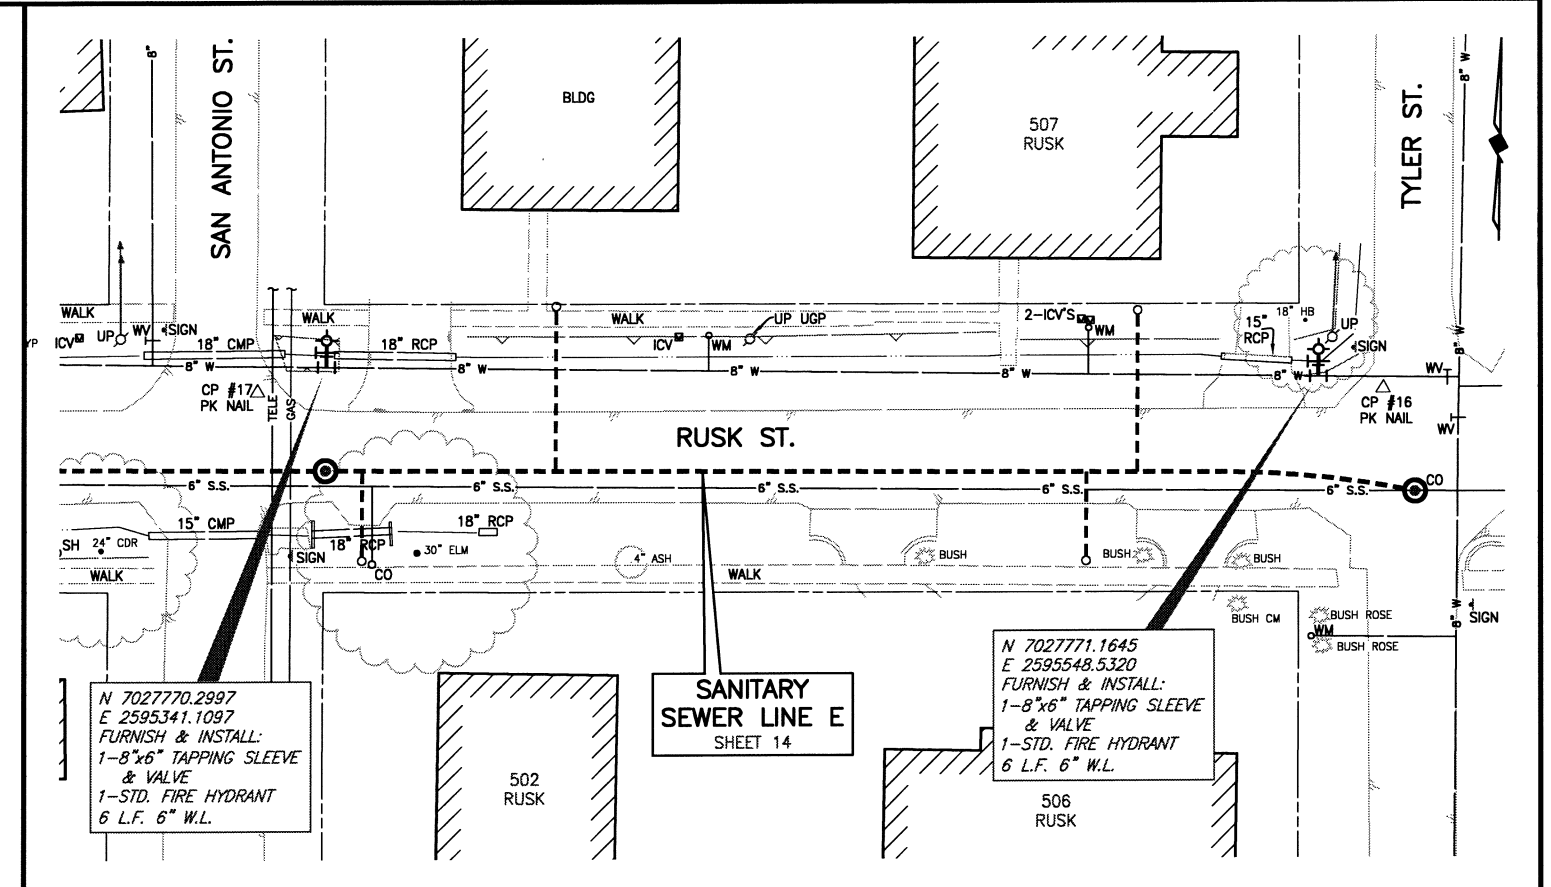
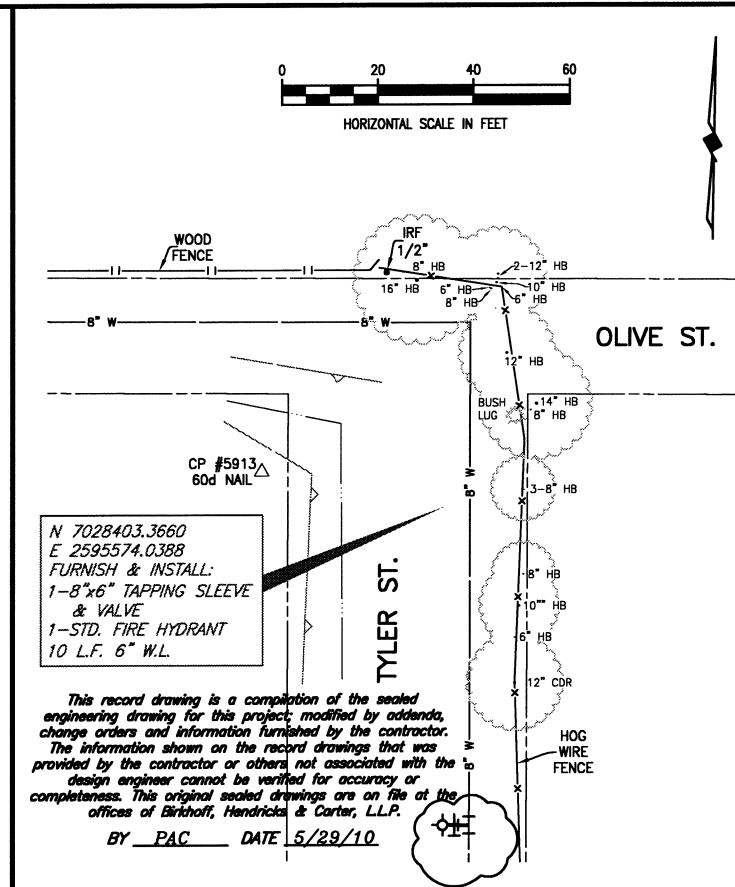


These plans and related specifications were prepared for construction of this specific project only. Reuse of these documents is not permitted without written authorization of Birkhoff, Hendricks, & Conway, L.L.P.

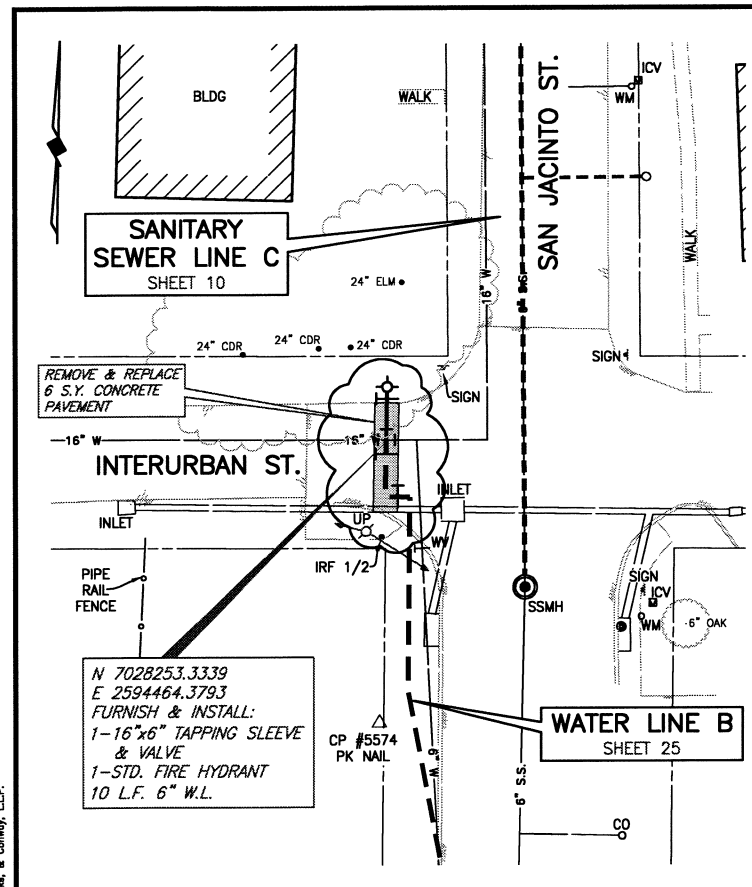

**BIRKHOFF, HENDRICKS & CONWAY, L.L.P.**  
PROFESSIONAL ENGINEERS  
11910 Greenville Ave., Suite 600  
Dallas, Texas  
(214) 361-7900

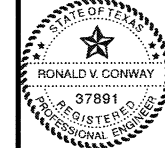

*Ronald V. Conway*  
10/13/08

**CITY OF ROCKWALL, TEXAS**  
DOWNTOWN AREA WATER AND SANITARY SEWER IMPROVEMENTS  
**FIRE HYDRANT INSTALLATION PLAN**

BHC PROJECT NO. 2007-148  
OCTOBER 2008  
SHEET NO. **38**