

**LEGEND**

—○— PROPOSED WATER SERVICE W/  
WATER METER & METER BOX

N 7028024.0465  
E 2595251.5649  
P.I. STA. 11+09.26  
Δ = 45°00'00" RT.  
FURNISH & INSTALL:  
1-8" 45° BEND

N 7028024.5508  
E 2595282.7287  
P.I. STA. 11+43.94  
Δ = 45°00'00" RT.  
FURNISH & INSTALL:  
1-8" 45° BEND

N 7028024.9676  
E 2595308.4887  
STA. 11+69.71 W.L. B=  
STA. 11+44.27 W.L. E  
FURNISH & INSTALL:  
1-8"x8" CROSS

**CONSTRUCT 8" P.V.C.  
WATER LINE B**

N 7028029.1432  
E 2595566.5305  
P.I. STA. 14+27.78  
Δ = 45° LT.  
FURNISH & INSTALL:  
1-8" 45° BEND

N 7028035.6121  
E 2595572.7934  
P.I. STA. 14+36.79  
Δ = 45° RT.  
FURNISH & INSTALL:  
1-8" 45° BEND

N 7028035.6993  
E 2595579.1135  
STA. 14+43.11  
CONNECT TO EXISTING  
8" WATER LINE  
FURNISH & INSTALL:  
1-8"x8" TAPPING  
SLEEVE & VALVE

N 7028019.8673  
E 2595255.8816  
P.I. STA. 11+15.26  
Δ = 45°00'00" LT.  
FURNISH & INSTALL:  
1-8" 45° BEND

N 7028020.2341  
E 2595278.5495  
P.I. STA. 11+37.93  
Δ = 45°00'00" LT.  
FURNISH & INSTALL:  
1-8" 45° BEND


SHEET 26  
N 7028023.8967, E 2595242.3110  
MATCH LINE STA. 11+00

**WATER LINE E**  
SHEET 30

**WATER LINE E**  
SHEET 30

**SANITARY  
SEWER LINE D**  
SHEET 11 & 12


This record drawing is a compilation of the sealed engineering drawing for this project, modified by addenda, change orders and information furnished by the contractor. The information shown on the record drawings that was provided by the contractor or others not associated with the design engineer cannot be verified for accuracy or completeness. This original sealed drawings are on file at the offices of Birkhoff, Hendricks & Carter, L.L.P.  
BY PAC DATE 5/29/10

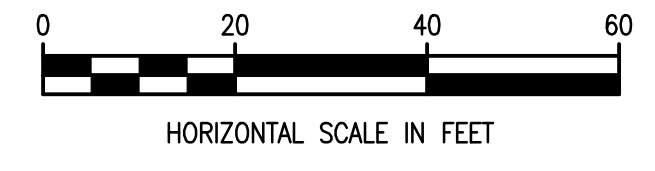

These plans and related specifications were prepared for construction of this specific project only. Reuse of these documents is not permitted without written authorization of Birkhoff, Hendricks, & Conway, L.L.P.

REVISED: NOV. 24, 2008

**BIRKHOFF, HENDRICKS & CONWAY, L.L.P.**  
PROFESSIONAL ENGINEERS  
11910 Greenville Ave., Suite 600  
Dallas, Texas  
(214) 361-7900

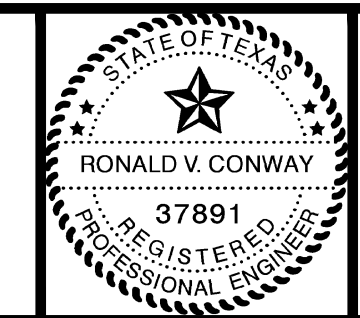

*Ronald V. Conway*  
12/4/08

**CITY OF ROCKWALL, TEXAS**  
DOWNTOWN AREA WATER AND SANITARY SEWER IMPROVEMENTS  
**WATER LINE B - PLAN**  
STA. 11+00 TO STA. 14+36.93

BHC  
PROJECT NO.  
2007-148  
OCTOBER 2008

SHEET NO.  
**27**