

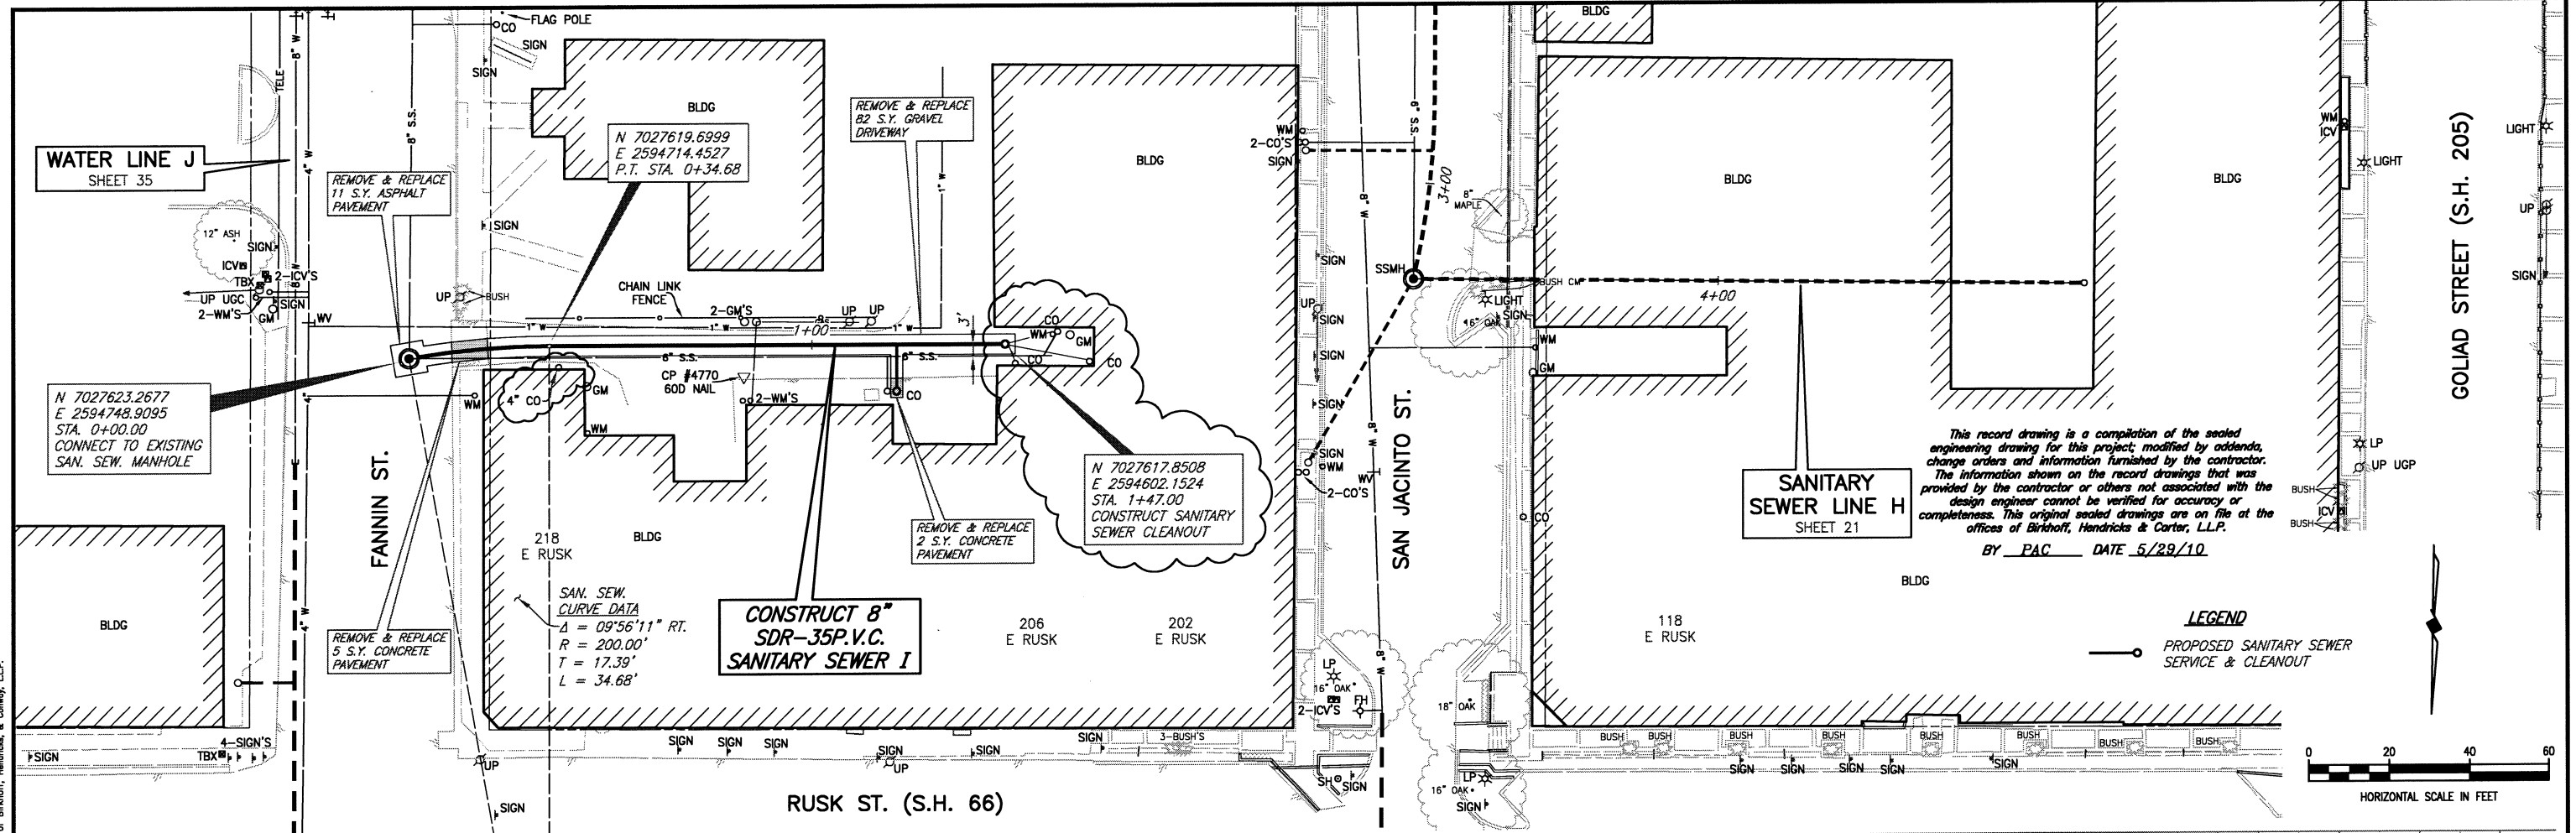


These plans and related specifications were prepared for construction of this specific project only. Reuse of these documents is not permitted without written authorization of Birkhoff, Hendricks & Conway, L.L.P.

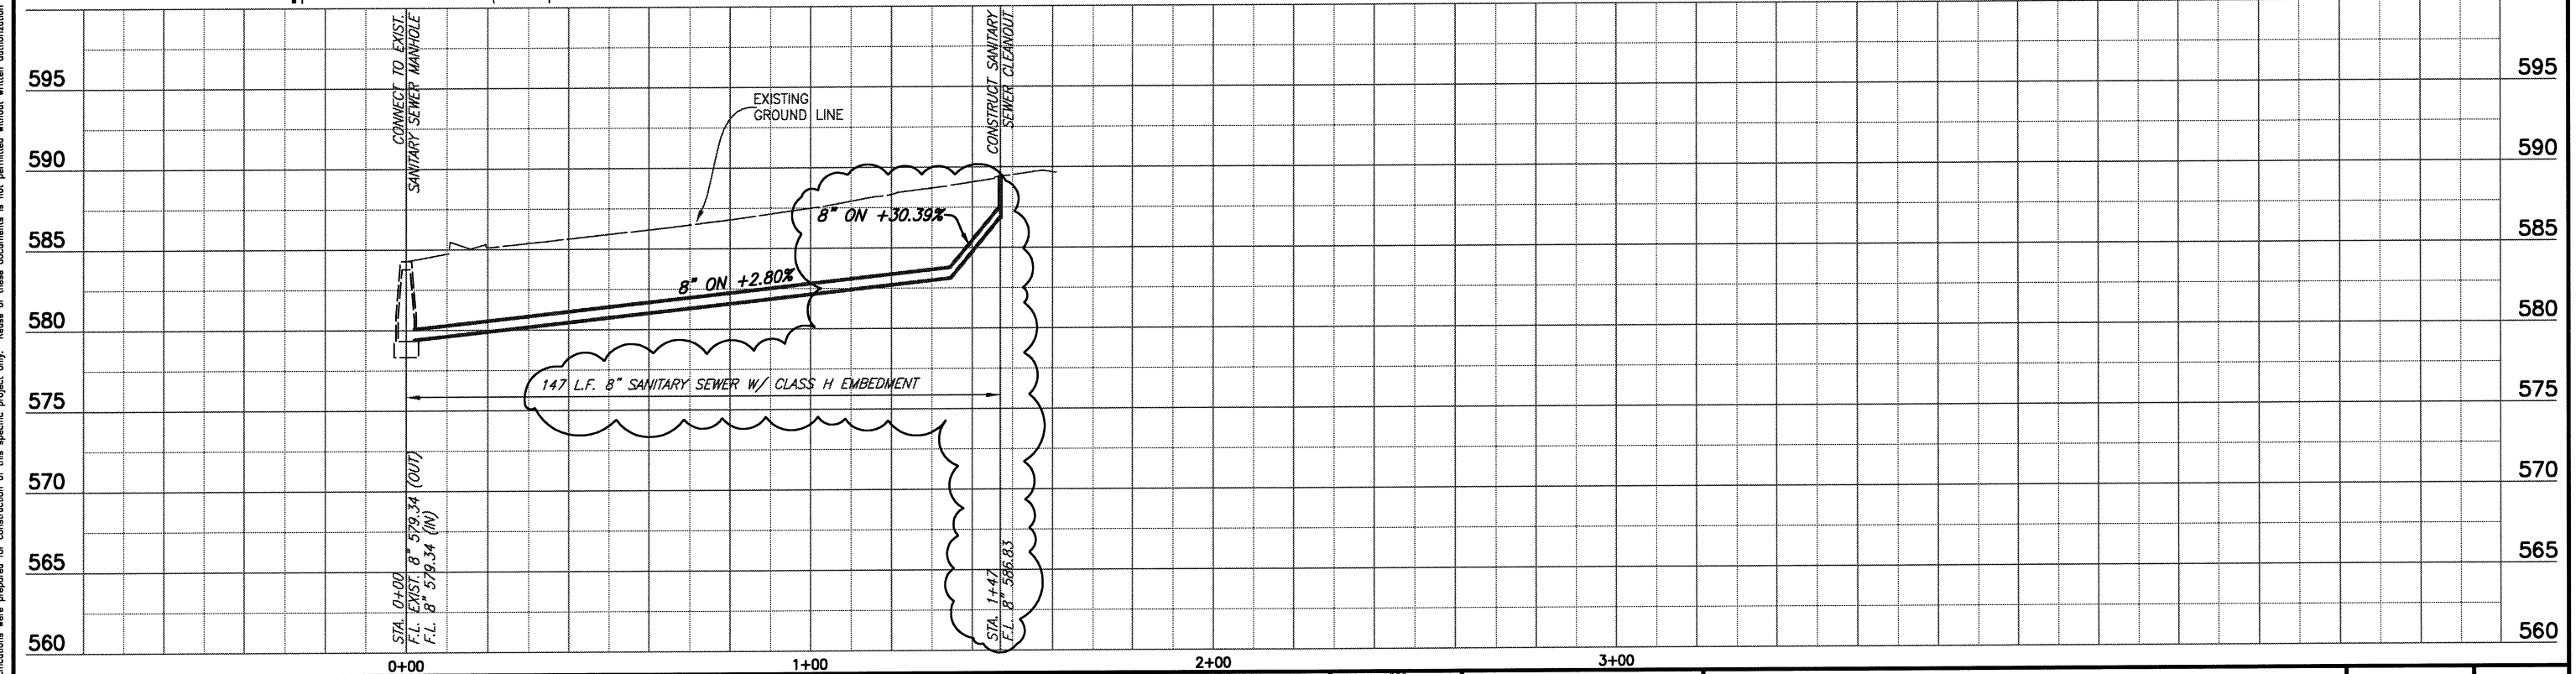

This record drawing is a compilation of the sealed engineering drawing for this project; modified by addenda, change orders and information furnished by the contractor. The information shown on the record drawings that was provided by the contractor or others not associated with the design engineer cannot be verified for accuracy or completeness. This original sealed drawings are on file at the offices of Birkhoff, Hendricks & Carter, L.L.P.
 BY PAC DATE 5/29/10

LEGEND
 ○ PROPOSED SANITARY SEWER SERVICE & CLEANOUT

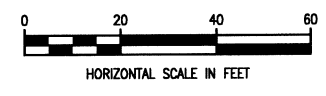

REVISED: NOV. 24, 2008 	BIRKHOFF, HENDRICKS & CONWAY, L.L.P. PROFESSIONAL ENGINEERS 11910 Greenville Ave., Suite 600 Dallas, Texas (214) 361-7900	 <i>Ronald V. Conway</i> 12/4/08	CITY OF ROCKWALL, TEXAS DOWNTOWN AREA WATER AND SANITARY SEWER IMPROVEMENTS SANITARY SEWER I - PLAN & PROFILE STA. 0+00 TO STA. 1+60.92	BHC PROJECT NO. 2007-148 OCTOBER 2008	SHEET NO. 22
--------------------------------	--	--	--	--	----------------------------