



These plans and related specifications were prepared for construction of this specific project only. Reuse of these documents is not permitted without written authorization of Birkhoff, Hendricks, & Conway, L.L.P.

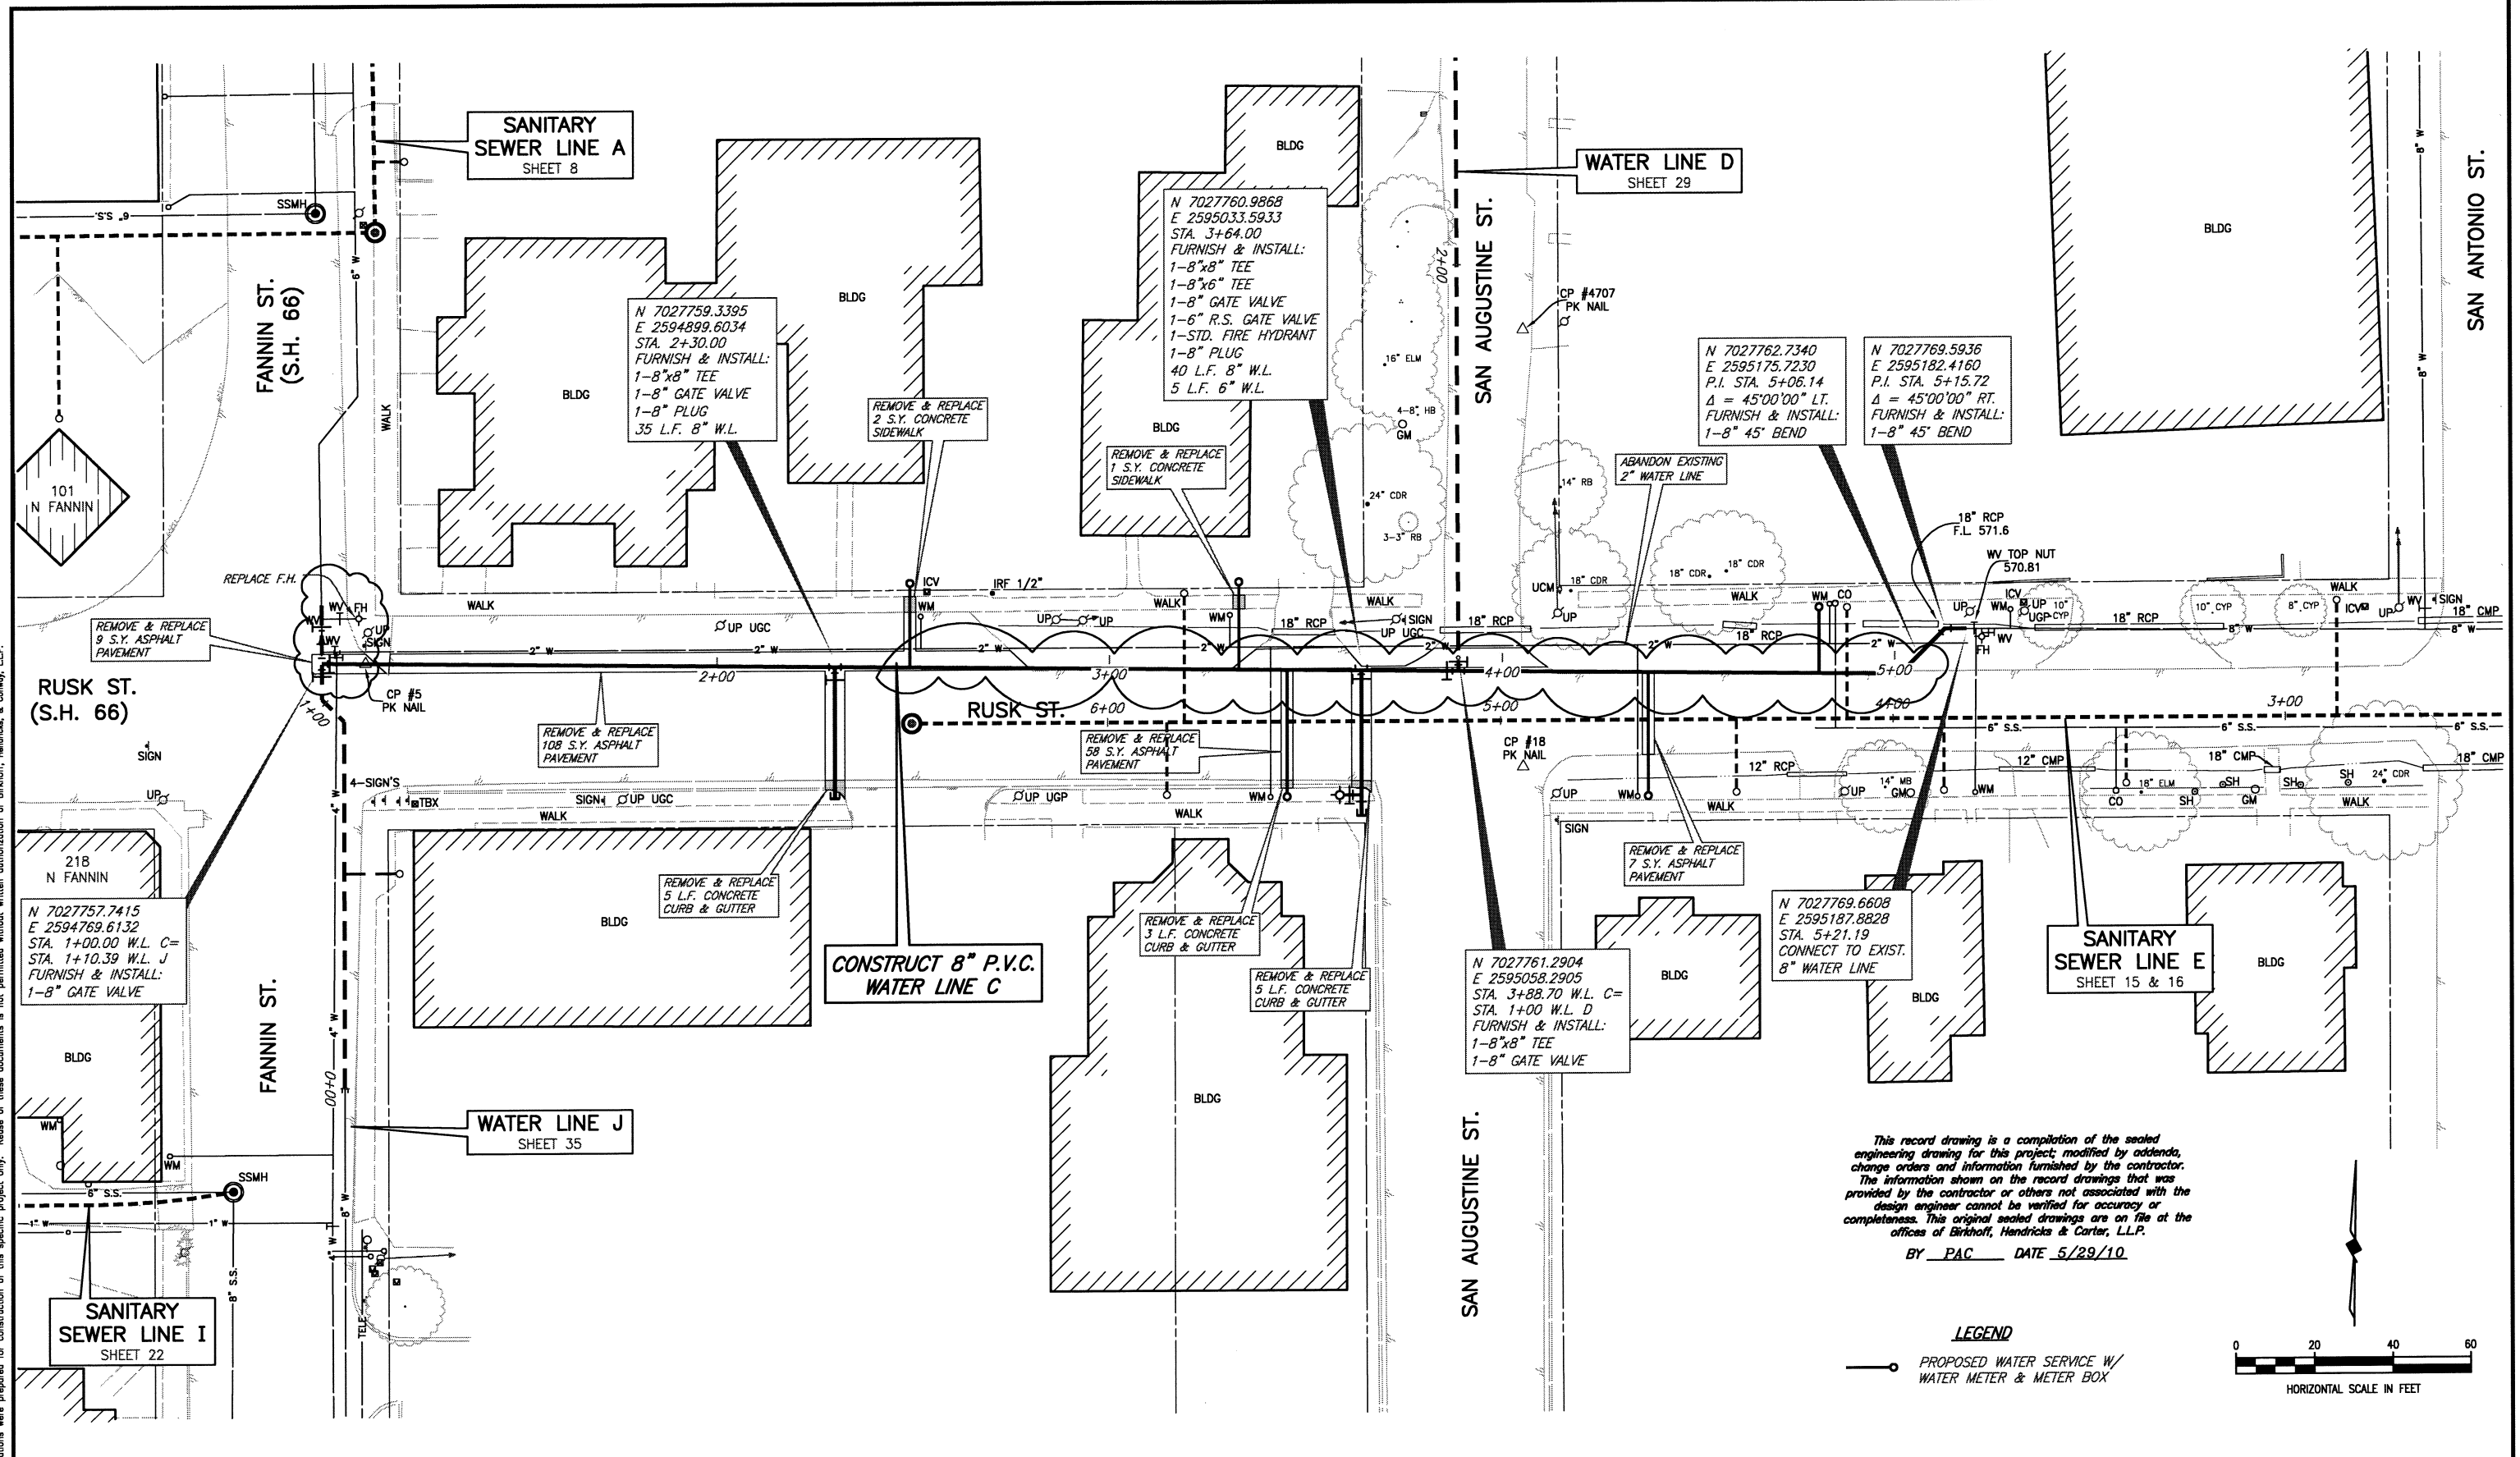

This record drawing is a compilation of the sealed engineering drawing for this project; modified by addenda, change orders and information furnished by the contractor. The information shown on the record drawings that was provided by the contractor or others not associated with the design engineer cannot be verified for accuracy or completeness. This original sealed drawings are on file at the offices of Birkhoff, Hendricks & Conway, L.L.P.
 BY PAC DATE 5/29/10

LEGEND
 —○— PROPOSED WATER SERVICE W/
 WATER METER & METER BOX

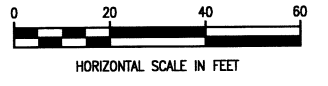

| |
|------------------------|
| REVISED: NOV. 24, 2008 |
| |
| |
| |

BIRKHOFF, HENDRICKS & CONWAY, L.L.P.
 PROFESSIONAL ENGINEERS
 11910 Greenville Ave., Suite 600
 Dallas, Texas
 (214) 361-7900



Ronald V. Conway
 12/4/08

CITY OF ROCKWALL, TEXAS
 DOWNTOWN AREA WATER AND SANITARY SEWER IMPROVEMENTS
WATER LINE C - PLAN & PROFILE
 STA. 1+00 TO STA. 5+21.19

BHC
 PROJECT NO.
 2007-148
 OCTOBER 2008

SHEET NO.
28