


LEGEND


| | |
|---------|--|
| XXX.XX | EXIST TOP OF PAVEMENT ELEV |
| XXX.XX | EXIST TOP OF PAVEMENT ELEV (THROCKMORTON ST PLANS) |
| XXX.XX | PROP TOP OF PAVEMENT ELEV |
| VG= XX% | VERTICAL GRADE |
| XXX | CONTOUR ELEV |
| X.XX% | CROSS-SLOPE |

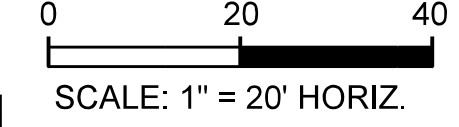

CALL BEFORE YOU DIG!
TEXAS ONE CALL PARTICIPANTS REQUEST 48 HOURS NOTICE BEFORE YOU DIG, DRILL, OR BLAST - STOP CALL

Texas One Call System
1-800-DIG-TESS

UTILITY LOCATION NOTE:
The location of existing utilities shown on these plans are approximate and based on existing plans and data furnished by utility companies. It is the responsibility of the contractor to verify the location and depth of all existing utilities that may conflict with construction. Call 1-800-344-8377 two working days prior to construction for on site locations. Any damage to existing utilities shall be repaired at contractor's expense, at no additional cost.

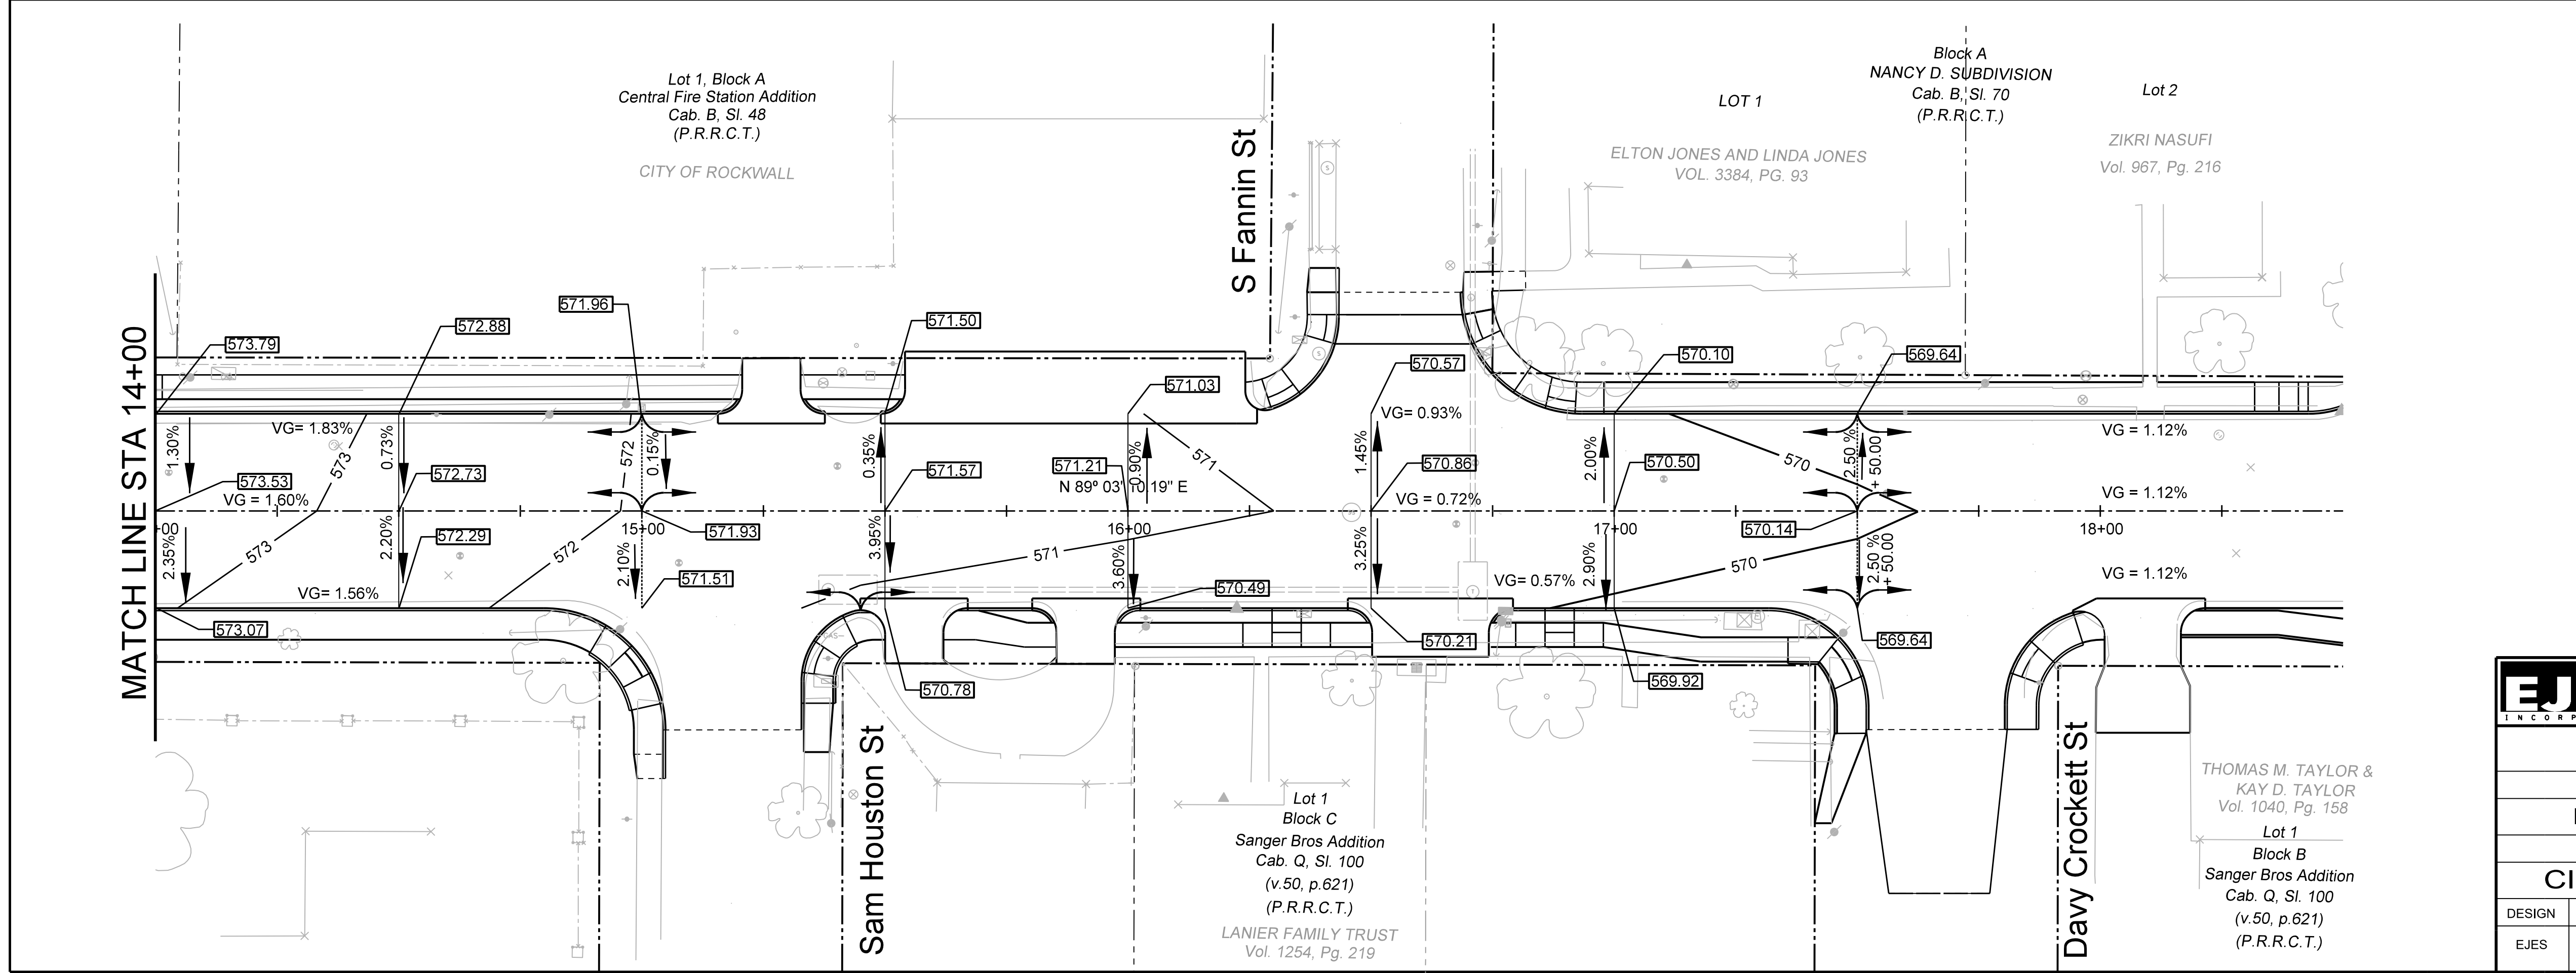

RECORD DRAWING
THIS DRAWING IS A COMPLETION OF A COPY OF THE SEALED ENGINEERING DRAWING FOR THIS PROJECT, MODIFIED BY ADDENDA, CHANGE ORDERS AND INFORMATION FURNISHED BY THE CONTRACTOR. THE INFORMATION SHOWN ON THE RECORD DRAWING THAT WAS PROVIDED BY THE CONTRACTOR OR OTHERS NOT ASSOCIATED WITH THE DESIGN ENGINEER CANNOT BE VERIFIED FOR ACCURACY OR COMPLETENESS. THE ORIGINAL SEALED DRAWINGS ARE ON FILE AT THE OFFICE OF EJES, INC., TYPE FIRM REGISTRATION NO. 2488

James Allen, P.E., TX License No. 65929
Date: JULY 28, 2019



EJES INCORPORATED
12655 N Central Expy, Suite # 500, Dallas, Texas 75243.
Tel # 214-343-1210, Fax # 214-343-3885
FIRM REGISTRATION No: F-2488

GRADING PLAN
E. BOYDSTUN AVE.
FROM S. GOLIAD ST TO S. CLARK ST
PUBLIC WORKS DEPARTMENT
CITY OF ROCKWALL, TEXAS

| DESIGN | DRAWN | DATE | SCALE | NOTES | FILE | SHEET NO. |
|--------|-------|----------|----------|-------|------|-----------|
| EJES | EJES | MAY 2017 | 1"=20' H | | | 16 |