


- NOTE:
- SEE CITY OF ROCKWALL 2016 STANDARD OF DESIGN AND CONSTRUCTION SECTION 2.16 AND STANDARD DRAWING R-2300 FOR STREET AND REGULATORY SIGNAGE SPECIFICATIONS
 - PAVEMENT MARKINGS SHALL BE THERMOPLASTIC.
 - REMOVE ALL CONFLICTING PAVEMENT MARKINGS ON GOLIAD.

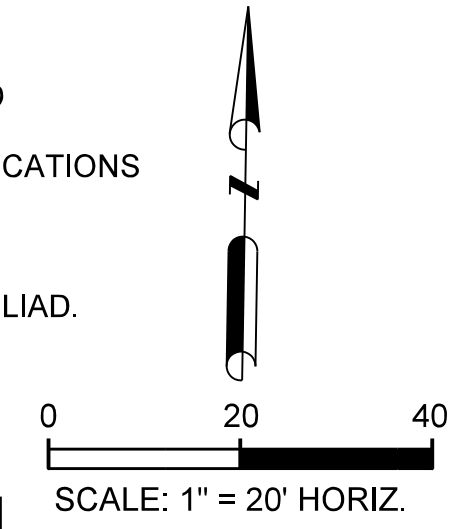


- LEGEND
- (A) 4" PAV MRK (SLD) DBL (Y)
 - (B) 8" PAV MRK (SLD) (W)
 - (C) 24" PAV MRK (SLD) (W)
 - (D) 8" PAV MRK (SLD) (Y)
 - (E) TY II I-C RAISED PAVEMENT MAKERS
 - (F) TY II A-A RAISED PAVEMENT MAKERS
 - (G) 12" PAV MRK (SLD) (W)
 - (H) PAV MRK SYMBOL (W)
 - (I) EXIST PAV MRK
- PROPOSED SIGNS
 - EXISTING SIGNS
 - SALVAGE EXISTING SIGN
- TRAFFIC FLOW DIRECTION

CALL BEFORE YOU DIG!
 TEXAS ONE CALL PARTICIPANTS REQUEST
 48 HOURS NOTICE BEFORE YOU DIG, DRILL,
 OR BLAST - STOP CALL


Texas One Call System
 1-800-DIG-TESS

UTILITY LOCATION NOTE:
 The location of existing utilities shown on these plans are approximate and based on existing plans and data furnished by utility companies. It is the responsibility of the contractor to verify the location and depth of all existing utilities that may conflict with construction. Call 1-800-344-8377 two working days prior to construction for on site locations. Any damage to existing utilities shall be repaired at contractor's expense, at no additional cost.

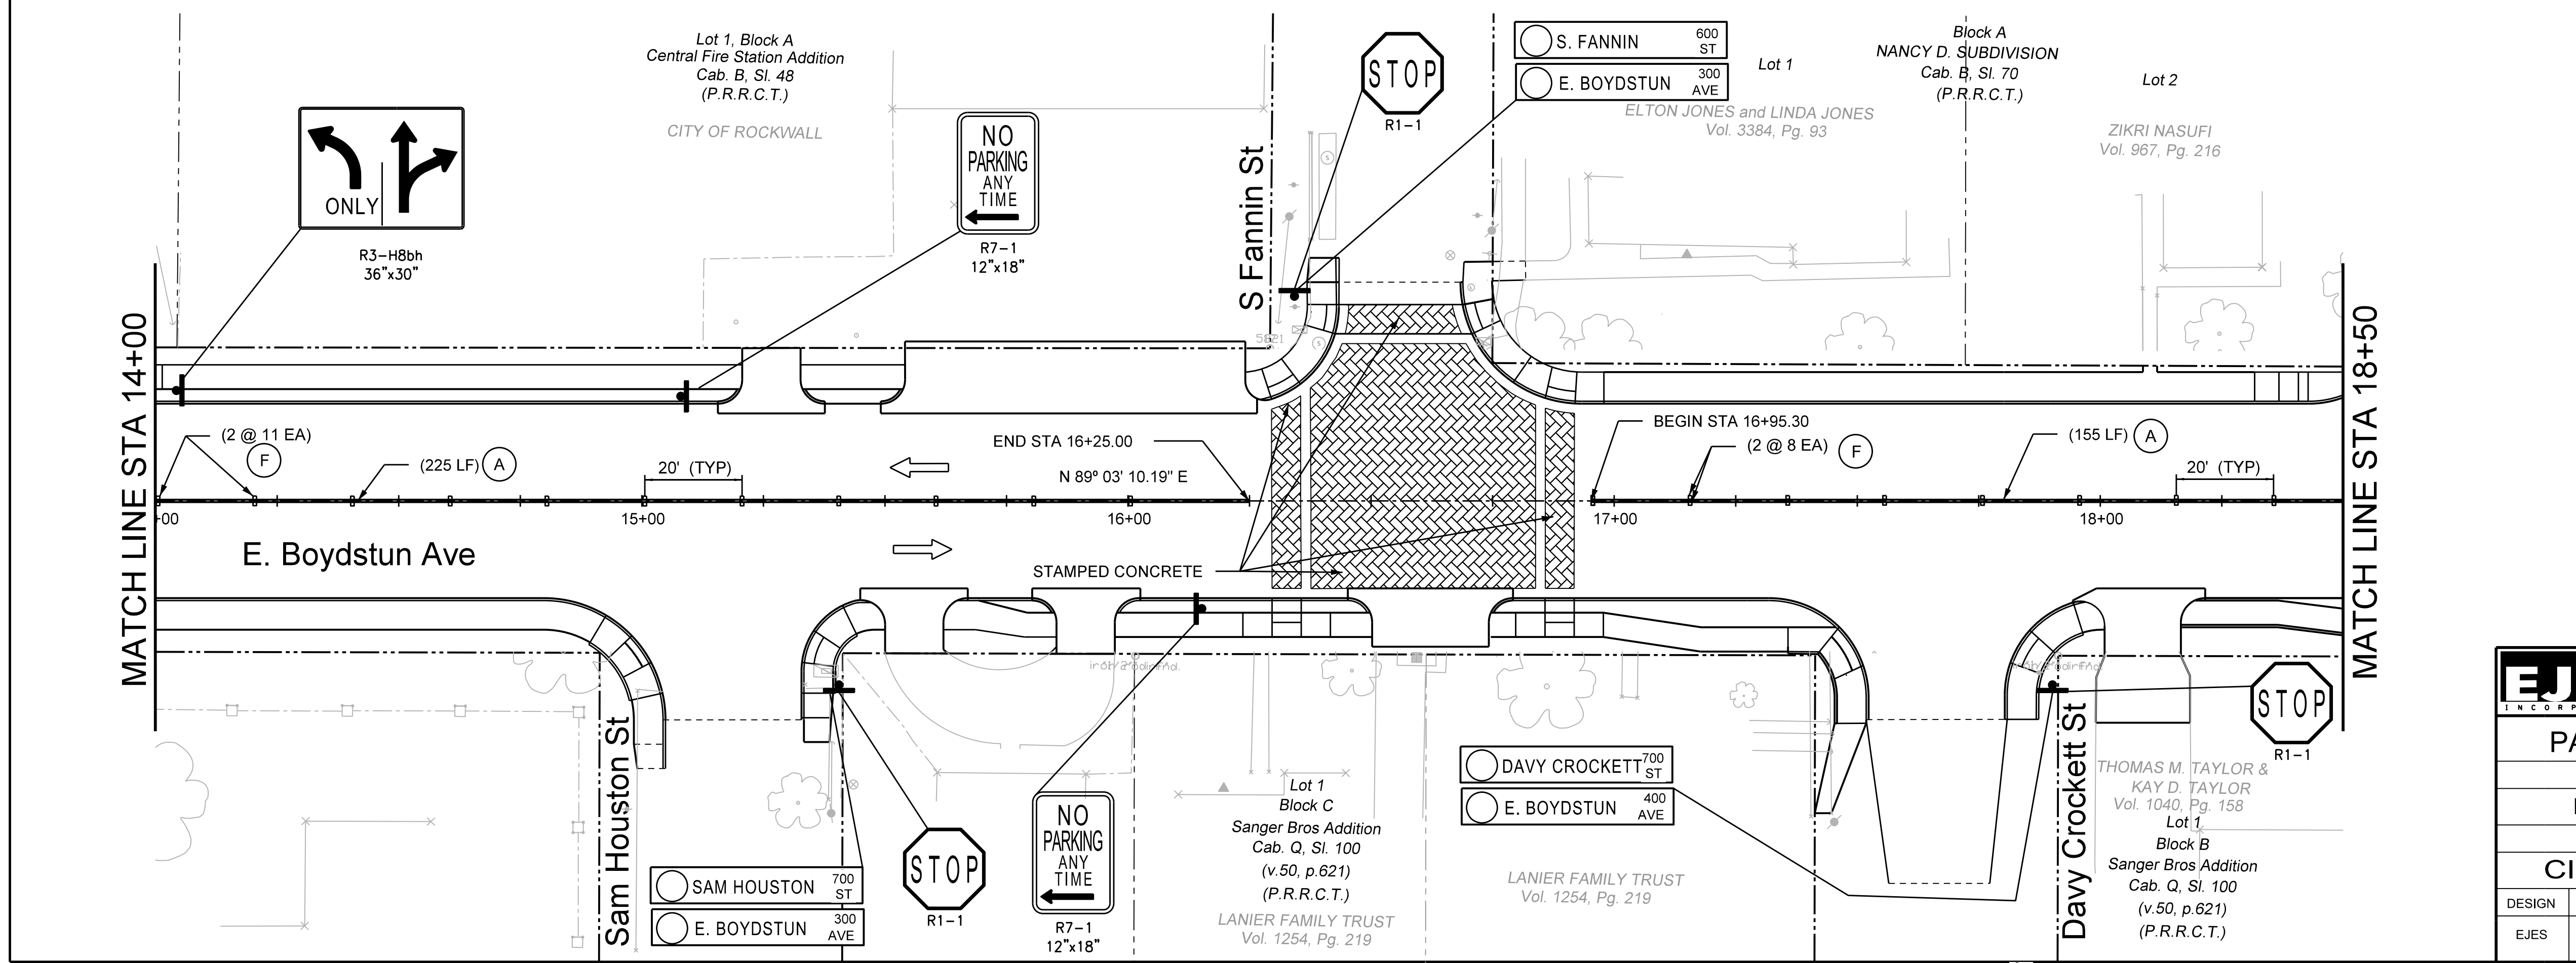

RECORD DRAWING
 THIS DRAWING IS A COMPILED COPY OF THE SEALED ENGINEERING DRAWING FOR THIS PROJECT, MODIFIED BY ADDENDA, CHANGE ORDERS AND INFORMATION FURNISHED BY THE CONTRACTOR. THE INFORMATION SHOWN ON THE RECORD DRAWING THAT WAS PROVIDED BY THE CONTRACTOR OR OTHERS NOT ASSOCIATED WITH THE DESIGN ENGINEER CANNOT BE VERIFIED FOR ACCURACY OR COMPLETENESS. THE ORIGINAL SEALED DRAWINGS ARE ON FILE AT THE OFFICE OF EJES, INC., TYPE FIRM REGISTRATION No. 2488

James Allen, P.E. TX License No. 65929 Date: JULY 28, 2019

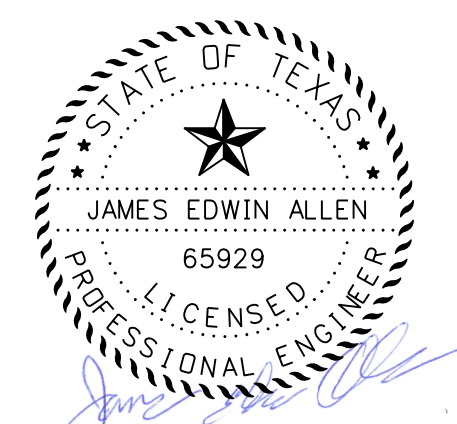

EJES INCORPORATED
 12655 N Central Expy, Suite # 500, Dallas, Texas 75243.
 Tel # 214-343-1210, Fax # 214-343-3885
 FIRM REGISTRATION No: F-2488

PAVEMENT MARKINGS / SIGNS						
E. BOYDSTUN AVE.						
FROM S. GOLIAD ST TO S. CLARK ST						
PUBLIC WORKS DEPARTMENT						
CITY OF ROCKWALL, TEXAS						
DESIGN	DRAWN	DATE	SCALE	NOTES	FILE	SHEET NO.
EJES	EJES	MAY 2017	1"=20' H			17