

NOTE:

1. WHEN CONSTRUCTING WASTEWATER LINE AT INTERSECTIONS, INSTALL TRAFFIC CONTROL AS SHOWN IN STANDARD TCP(1-2b) AND AS DIRECTED BY THE ENGINEER.

## TCP LEGEND

CONSTRUCTION THIS STAGE



UTILITY CONSTRUCTION

24" WK ZN NON REMOVABLE (SLD) (W)

24" WK ZN REMOVABLE (SLD) (W)

**EXIST PAV MRKS** 

ARROW BOARD

SIGN

→ VERTICAL PANEL (30' C-C)

TYPE III BARRICADE

PLASTIC DRUMS

TRAFFIC FLOW DIRECTION

CALL BEFORE YOU DIG! TEXAS ONE CALL PARTICIPANTS REQUEST 48 HOURS NOTICE BEFORE YOU DIG, DRILL, OR BLAST - STOP CALL




**UTILITY LOCATION NOTE:** The location of existing utilities shown on these plans are approximate and based on existing plans are approximate and based on existing plans and data furnished by utility companies. It is the responsibility of the contractor to verify the location and depth of all existing utilities that may conflict with construction. Call 1-800-344-8377 two working days prior to construction for on site locations. Any damage to existing utilities shall be repaired at contractor's expense, at no additional cost.

## BENCHMARKS

RECORD DRAWING THIS DRAWING IS A COMPILATION OF A COPY OF THE SEALED ENGINEETING DRAWING FOR THIS PROJECT, MODIFIED BY ADDENDA, CHANGE ORDERS AND INFORMATION FURNISHED BY THE CONTRACTOR. THE INFORMATION SHOWN ON THE RECORD DRAWING THAT WAS PROVIDED BY THE CONTRACTOR OR OTHERS NOT ASSOCIATED WITH THE DESIGN ENGINEER CANNOT BE VERIFIED FOR ACCUACY OR COMPLETENESS. THE ORIGINAL SEALED DWAWINGS ARE ON FILE AT THE OFFICE OF EJES. INC., TBPE FIRM REGISTRATION No. 2488 JULY 26, 2019

James Allen, P.E., TX License No. 65929

Date

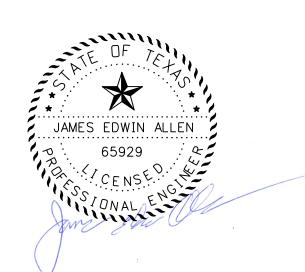

12655 N Central Expy, Suite # 500, Dallas, Texas 75243. Tel # 214-343-1210, Fax # 214-343-3885
FIRM REGISTRATION No: F-2488

TCP STAGE 1 PHASE 1

E. BOYDSTUN AVE.

FROM S. GOLIAD ST TO S. CLARK ST

PUBLIC WORKS DEPARTMENT

CITY OF ROCKWALL, TEXAS DESIGN DRAWN DATE SCALE NOTES FILE SHEET NO. MAY 2017 EJES 29 EJES

1"=20' H