



DRAINAGE EASEMENT
INSTRUMENT No. 20170000012000





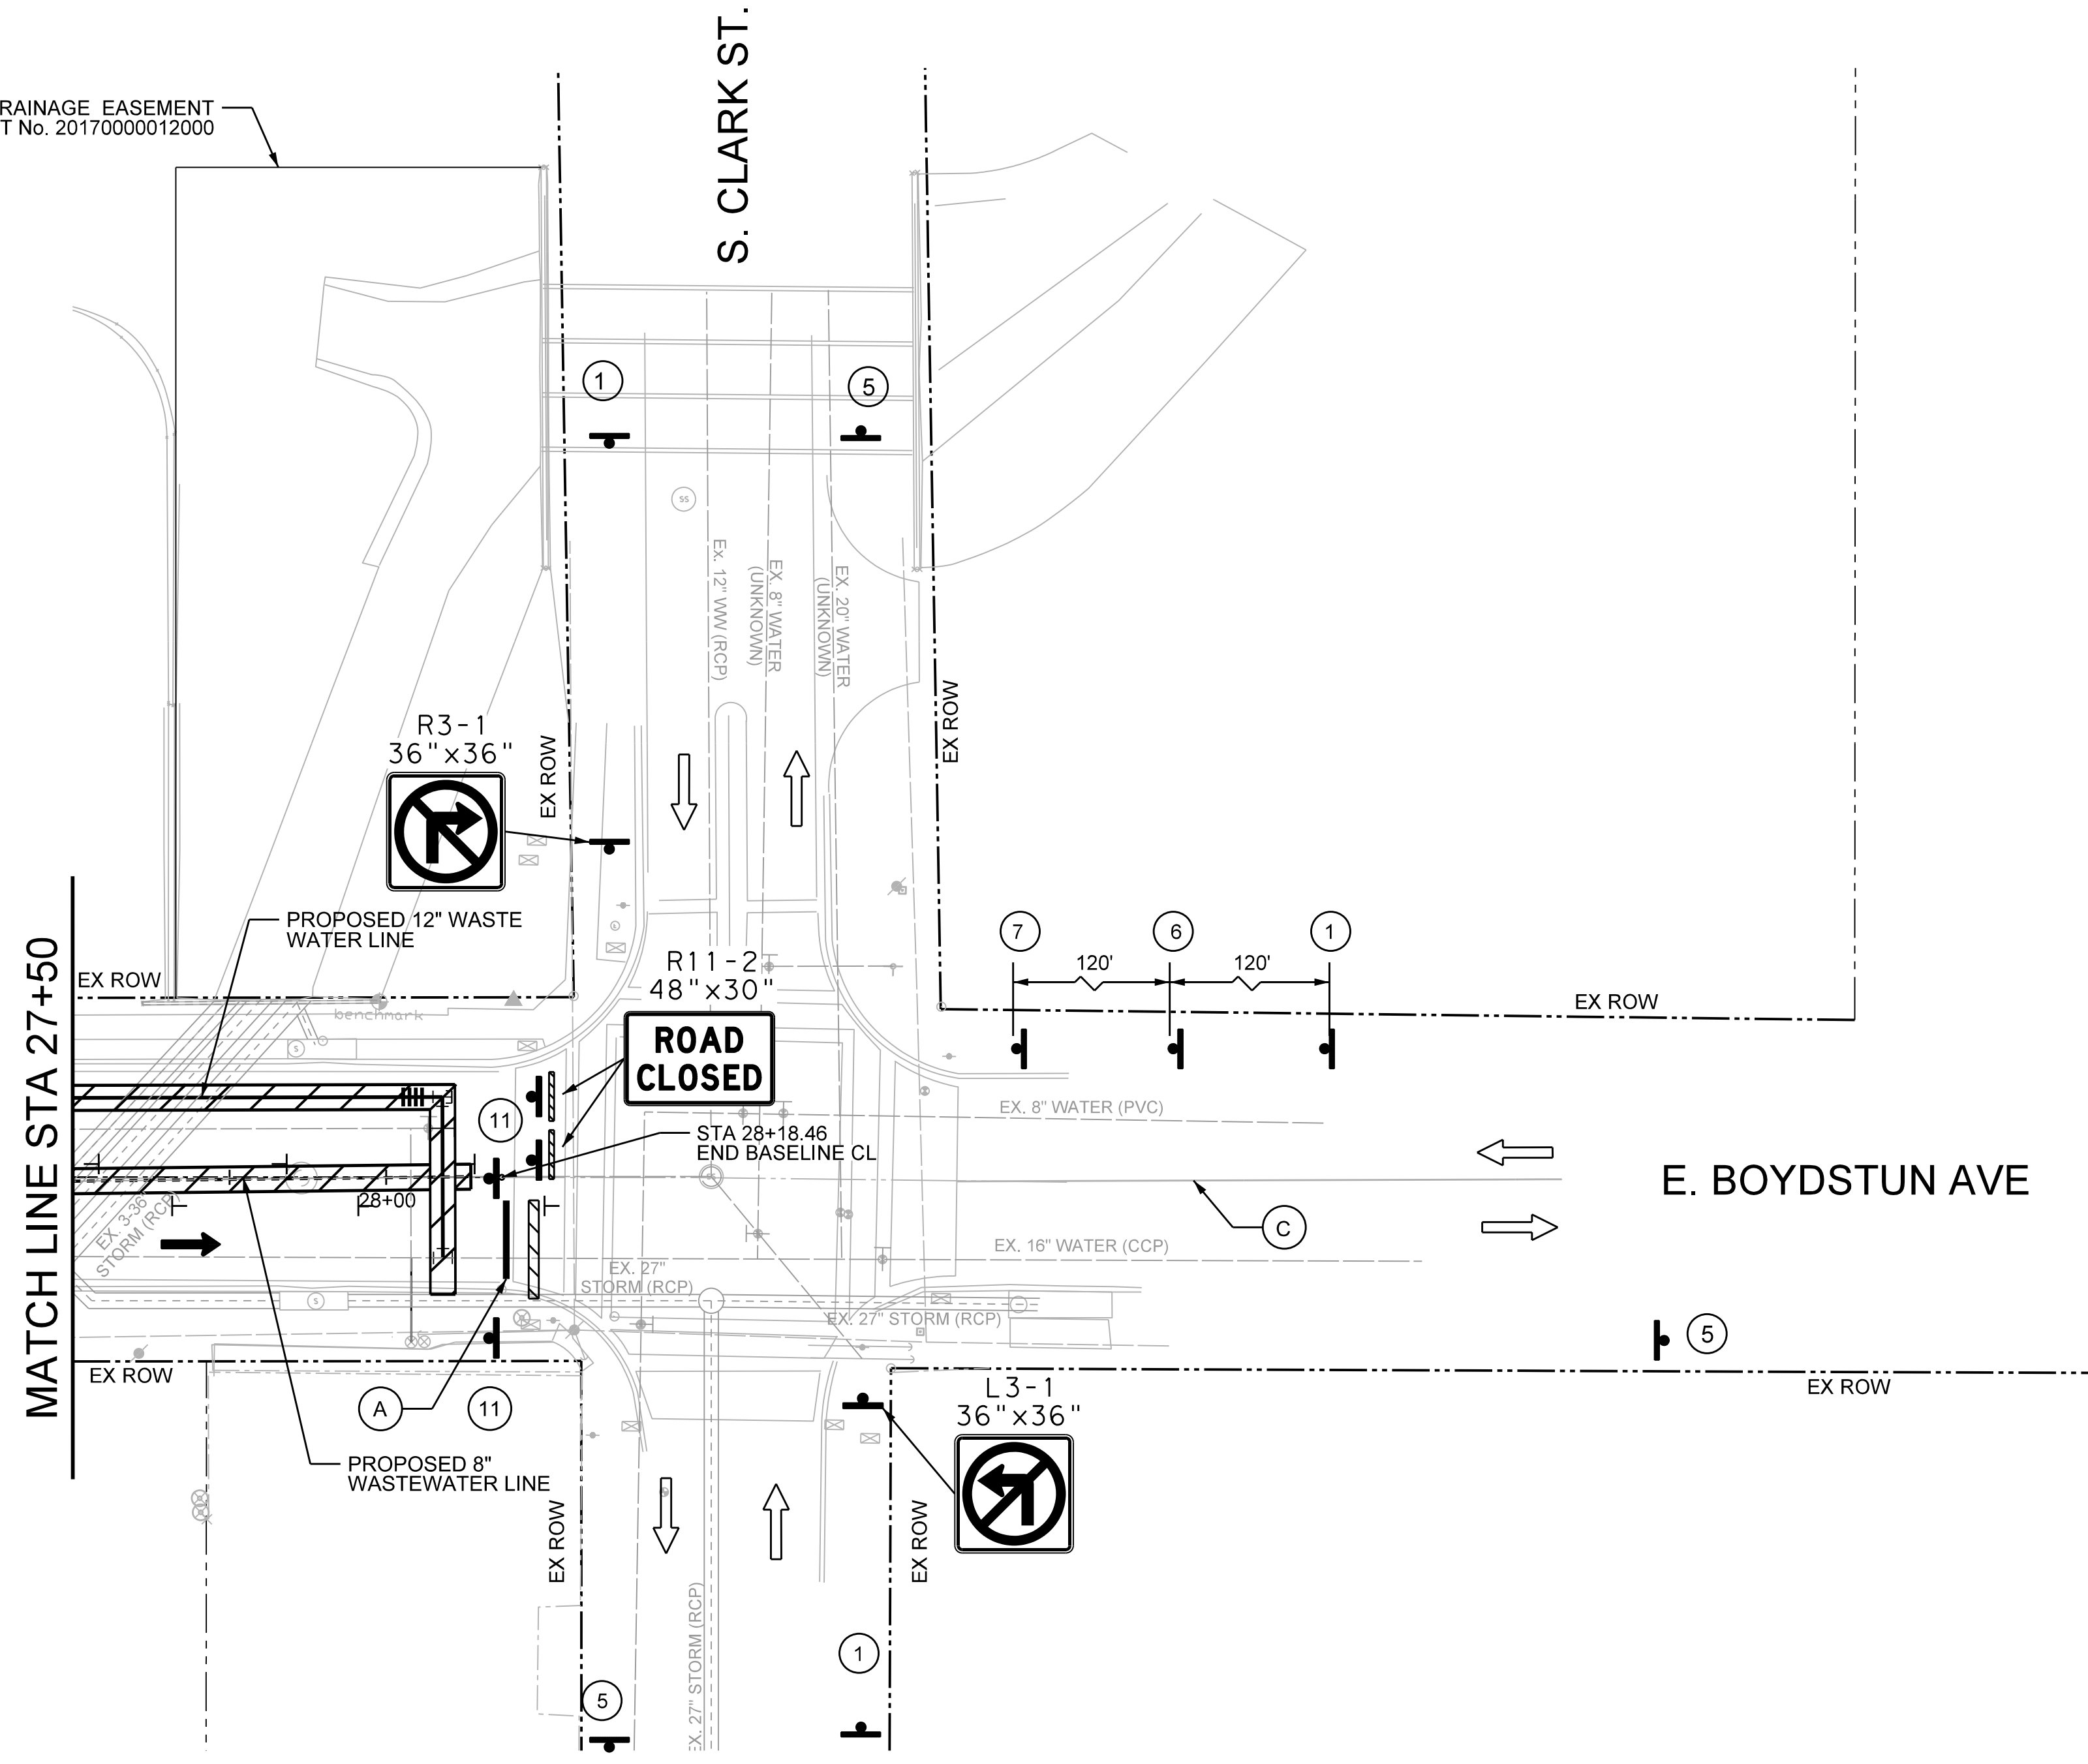



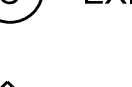

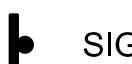


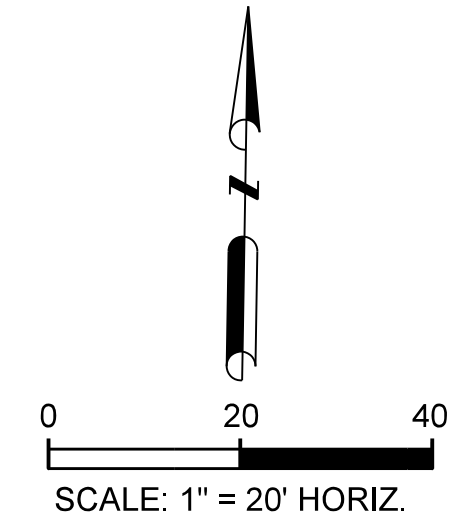
MATCH LINE STA 27+50

NOTE:

1. WHEN CONSTRUCTING WATER LINE AT INTERSECTIONS, INSTALL TRAFFIC CONTROL AS SHOWN IN STANDARD TCP(1-2b) AND AS DIRECTED BY THE ENGINEER.

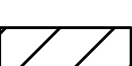


TCP LEGEND

-  CONSTRUCTION THIS STAGE
-  CONSTRUCTION PREVIOUS STAGE
-  UTILITY CONSTRUCTION
-  24" WK ZN NON REMOVABLE (SLD) (W)
-  24" WK ZN REMOVABLE (SLD) (W)
-  EXIST PAV MRKS
-  ARROW BOARD
-  SIGN
-  VERTICAL PANEL (30' C-C)
-  TYPE III BARRICADE
-  PLASTIC DRUMS
-  TRAFFIC FLOW DIRECTION

NOTE
TCP PLAN FOR DEC. 4 TO DEC. 31,
2017. AFTER DEC. 31 USE ORIGINAL
SHEETS 30-32.


CALL BEFORE YOU DIG!
TEXAS ONE CALL PARTICIPANTS REQUEST
48 HOURS NOTICE BEFORE YOU DIG, DRILL,
OR BLAST - STOP CALL

 Texas One Call System
1-800-DIG-TESS

UTILITY LOCATION NOTE:
The location of existing utilities shown on these
plans are approximate and based on existing
plans and data furnished by utility companies.
It is the responsibility of the contractor to verify
the location and depth of all existing utilities
that may conflict with construction.
Call 1-800-344-8377 two working days prior to
construction for on site locations. Any damage
to existing utilities shall be repaired at
contractor's expense, at no additional cost.

RECORD DRAWING
THIS DRAWING IS A COMPILATION OF A COPY OF THE SEALED
ENGINEERING DRAWING FOR THIS PROJECT, MODIFIED BY ADDENDA,
CHANGE ORDERS AND INFORMATION FURNISHED BY THE CONTRACTOR.
THE INFORMATION SHOWN ON THE RECORD DRAWING THAT WAS
PROVIDED BY THE CONTRACTOR OR OTHERS NOT ASSOCIATED WITH
THE DESIGN ENGINEER CANNOT BE VERIFIED FOR ACCURACY OR
COMPLETENESS. THE ORIGINAL SEALED DRAWINGS ARE ON FILE AT THE
OFFICE OF E.JES, INC., TBE FIRM REGISTRATION No. 2488

James Allen, P.E., TX License No. 65929 Date: JULY 26, 2019

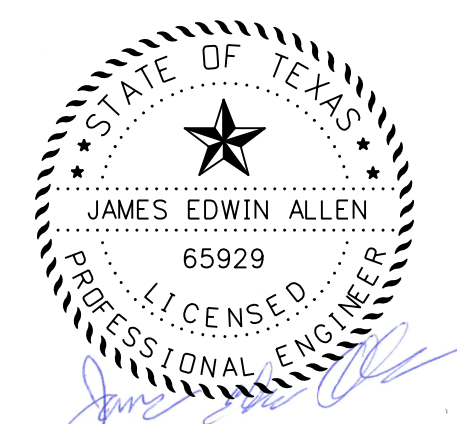

EJES INCORPORATED
12655 N Central Expy, Suite # 500, Dallas, Texas 75243.
Tel # 214-343-1210, Fax # 214-343-3885
FIRM REGISTRATION No: F-2488

TCP STAGE 1 PHASE 2A						
E. BOYDSTUN AVE.						
FROM S. GOLIAD ST TO S. CLARK ST						
PUBLIC WORKS DEPARTMENT						
CITY OF ROCKWALL, TEXAS						
DESIGN	DRAWN	DATE	SCALE	NOTES	FILE	SHEET NO.
EJES	EJES	MAY 2017	1"=20' H			32