


STAGE 2 PHASE 1 NOTES:  
 (AA) HIGH EARLY STRENGTH CONCRETE MAY BE USED IN THESE AREAS AND SHALL BE SUBSIDIARY TO THE CONCRETE PAVEMENT AND CONCRETE DRIVEWAY BID ITEMS. PHASE DRIVEWAY CONSTRUCTION SUCH THAT ACCESS IS AVAILABLE AT ALL TIMES.

- TCP LEGEND**
- CONSTRUCTION THIS STAGE
  - CONSTRUCTION PREVIOUS STAGE
  - UTILITY CONSTRUCTION
  - (A) 24" WK ZN NON REMOVABLE (SLD) (W)
  - (B) 24" WK ZN REMOVABLE (SLD) (W)
  - (C) EXIST PAV MRKS
  - ARROW BOARD
  - SIGN
  - VERTICAL PANEL (30' C-C)
  - TYPE III BARRICADE
  - PLASTIC DRUMS
  - TRAFFIC FLOW DIRECTION

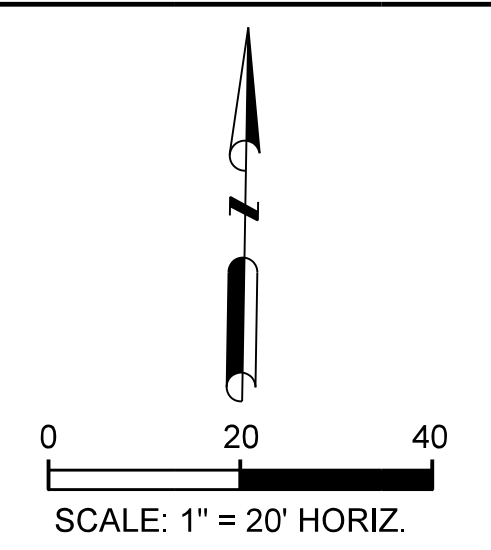

**CALL BEFORE YOU DIG!**  
 TEXAS ONE CALL PARTICIPANTS REQUEST 48 HOURS NOTICE BEFORE YOU DIG, DRILL, OR BLAST - STOP CALL

Texas One Call System  
 1-800-DIG-TESS


**UTILITY LOCATION NOTE:**  
 The location of existing utilities shown on these plans are approximate and based on existing plans and data furnished by utility companies. It is the responsibility of the contractor to verify the location and depth of all existing utilities that may conflict with construction. Call 1-800-344-8377 two working days prior to construction for on site locations. Any damage to existing utilities shall be repaired at contractor's expense, at no additional cost.

- 2. N 7026304.738 E 2594701.100 ELEV= 583.119 CIRST
- 3. N 7026315.130 E 2595264.068 ELEV= 571.525 CIRST

**RECORD DRAWING**  
 THIS DRAWING IS A COMPILATION OF A COPY OF THE SEALED ENGINEERING DRAWING FOR THIS PROJECT, MODIFIED BY ADDENDA, CHANGE ORDERS AND INFORMATION FURNISHED BY THE CONTRACTOR. THE INFORMATION SHOWN ON THE RECORD DRAWING THAT WAS PROVIDED BY THE CONTRACTOR OR OTHERS NOT ASSOCIATED WITH THE DESIGN ENGINEER CANNOT BE VERIFIED FOR ACCURACY OR COMPLETENESS. THE ORIGINAL SEALED DRAWINGS ARE ON FILE AT THE OFFICE OF E.J.E.S., INC. TYPE FIRM REGISTRATION No. 2488

JULY 26, 2019  
 James Allen, P.E., TX License No. 65929

ADDENDUM 1: 9-22-2017

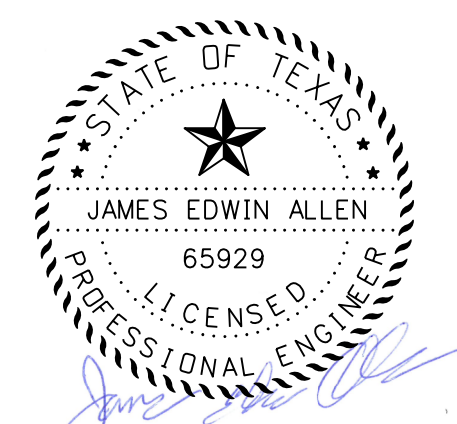

**EJES** INCORPORATED  
 12655 N Central Expy, Suite # 500, Dallas, Texas 75243.  
 Tel # 214-343-1210, Fax # 214-343-3885  
 FIRM REGISTRATION No: F-2488

<b>TCP STAGE 2 PHASE 1</b>						
<b>E. BOYDSTUN AVE.</b>						
<b>FROM S. GOLIAD ST TO S. CLARK ST</b>						
<b>PUBLIC WORKS DEPARTMENT</b>						
<b>CITY OF ROCKWALL, TEXAS</b>						
DESIGN	DRAWN	DATE	SCALE	NOTES	FILE	SHEET NO.
EJES	EJES	MAY 2017	1"=20' H			34

