

- LEGEND**
- ▲ CONTROL POINTS
 - BORING LOCATIONS


NOTE:
 SURVEY ESTABLISHED USING CITY OF ROCKWALL'S MONUMENT "RESET RO05-1". MONUMENT NEAR THE INTERSECTION OF SUMMIT RIDGE DR. AND FM 740.

SURVEY IS DONE IN TEXAS STATE PLANE COORDINATE SYSTEM, NAD 83, NORTH CENTRAL ZONE 4202. ALL DISTANCES AND COORDINATES ARE SURFACE. THEY MAY BE CONVERTED TO GRID BY DIVIDING BY A COMBINED SCALE FACTOR OF 1.000146135

BORINGS FROM GEOTECHNICAL REPORT BY HVJ INC. MARCH 9, 2016

RECORD DRAWING
 THIS DRAWING IS A COMPLETION OF A COPY OF THE SEALED ENGINEERING DRAWING FOR THIS PROJECT, MODIFIED BY ADDENDUM, CHANGE ORDERS AND INFORMATION FURNISHED BY THE CONTRACTOR. THE INFORMATION SHOWN ON THE RECORD DRAWING THAT WAS PROVIDED BY THE CONTRACTOR OR OTHERS NOT ASSOCIATED WITH THE DESIGN ENGINEER CANNOT BE VERIFIED FOR ACCURACY OR COMPLETENESS. THE ORIGINAL SEALED DRAWINGS ARE ON FILE AT THE OFFICE OF E.JES, INC., TBE FIRM REGISTRATION NO. 2488

James Allen, P.E., TX License No. 65929
 Date: JULY 28, 2019

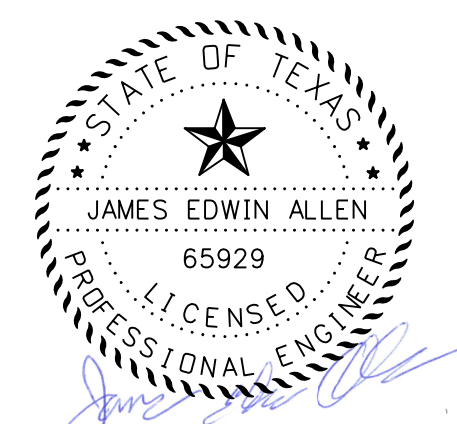

EJES INCORPORATED
 12655 N Central Expy, Suite # 500, Dallas, Texas 75243.
 Tel # 214-343-1210, Fax # 214-343-3885
 FIRM REGISTRATION No: F-2488

PROJECT LAYOUT						
E. BOYDSTUN AVE.						
FROM S. GOLIAD ST TO S. CLARK ST						
PUBLIC WORKS DEPARTMENT						
CITY OF ROCKWALL, TEXAS						
DESIGN	DRAWN	DATE	SCALE	NOTES	FILE	SHEET NO.
EJES	EJES	MAY 2017				4