


STAGE 3 PHASE 2 NOTES:

(BB) HIGH EARLY STRENGTH CONCRETE MAY BE USED FOR DRIVEWAY CONSTRUCTION AND SHALL BE SUBSIDIARY TO THE CONCRETE DRIVEWAY BID ITEM. THE CONTRACTOR SHALL COORDINATE WITH THE PROPERTY OWNER TO SCHEDULE DRIVEWAY CONSTRUCTION.

TCP LEGEND

- CONSTRUCTION THIS STAGE
- CONSTRUCTION PREVIOUS STAGE
- UTILITY CONSTRUCTION
- (A) 24" WK ZN NON REMOVABLE (SLD) (W)
- (B) 24" WK ZN REMOVABLE (SLD) (W)
- (C) EXIST PAV MRKS
- ARROW BOARD
- SIGN
- VERTICAL PANEL (30' C-C)
- TYPE III BARRICADE
- PLASTIC DRUMS
- TRAFFIC FLOW DIRECTION

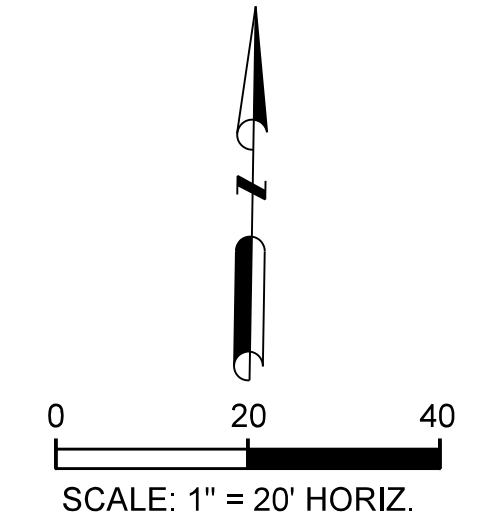

CALL BEFORE YOU DIG!
TEXAS ONE CALL PARTICIPANTS REQUEST 48 HOURS NOTICE BEFORE YOU DIG, DRILL, OR BLAST - STOP CALL

Texas One Call System
1-800-DIG-TESS


UTILITY LOCATION NOTE:
The location of existing utilities shown on these plans are approximate and based on existing plans and data furnished by utility companies. It is the responsibility of the contractor to verify the location and depth of all existing utilities that may conflict with construction. Call 1-800-344-8377 two working days prior to construction for on site locations. Any damage to existing utilities shall be repaired at contractor's expense, at no additional cost.

- 2. N 7026304.738 E 2594701.100 ELEV= 583.119 CIRST
- 3. N 7026315.130 E 2595264.068 ELEV= 571.525 CIRST
- 4. N 7026371.130 E 2595879.811 ELEV= 555.166 60DST

RECORD DRAWING
THIS DRAWING IS A COMPLETION OF A COPY OF THE SEALED ENGINEERING DRAWING FOR THIS PROJECT, MODIFIED BY ADDENDA, CHANGE ORDERS AND INFORMATION FURNISHED BY THE CONTRACTOR. THE INFORMATION SHOWN ON THIS RECORD DRAWING THAT WAS PROVIDED BY THE CONTRACTOR OR OTHERS NOT ASSOCIATED WITH THE DESIGN ENGINEER CANNOT BE VERIFIED FOR ACCURACY OR COMPLETENESS. THE ORIGINAL SEALED DRAWINGS ARE ON FILE AT THE OFFICE OF E.J.E.S., INC., T.B.P.E. FIRM REGISTRATION NO. 2488


JAMES EDWIN ALLEN
65929
LICENSED PROFESSIONAL ENGINEER

JULY 28, 2019
Date

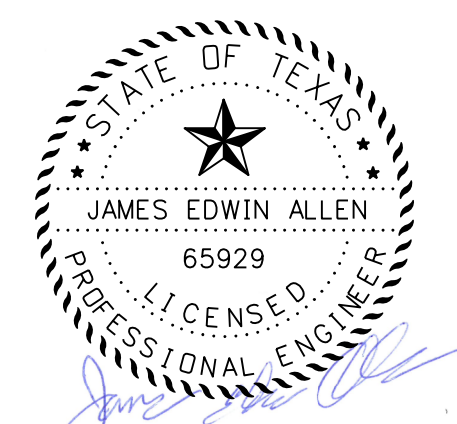

EJES INCORPORATED
12655 N Central Expy, Suite # 500, Dallas, Texas 75243.
Tel # 214-343-1210, Fax # 214-343-3885
FIRM REGISTRATION No: F-2488

TCP STAGE 3 PHASE 2						
E. BOYDSTUN AVE.						
FROM S. GOLIAD ST TO S. CLARK ST						
PUBLIC WORKS DEPARTMENT						
CITY OF ROCKWALL, TEXAS						
DESIGN	DRAWN	DATE	SCALE	NOTES	FILE	SHEET NO.
EJES	EJES	MAY 2017	1"=20' H			44

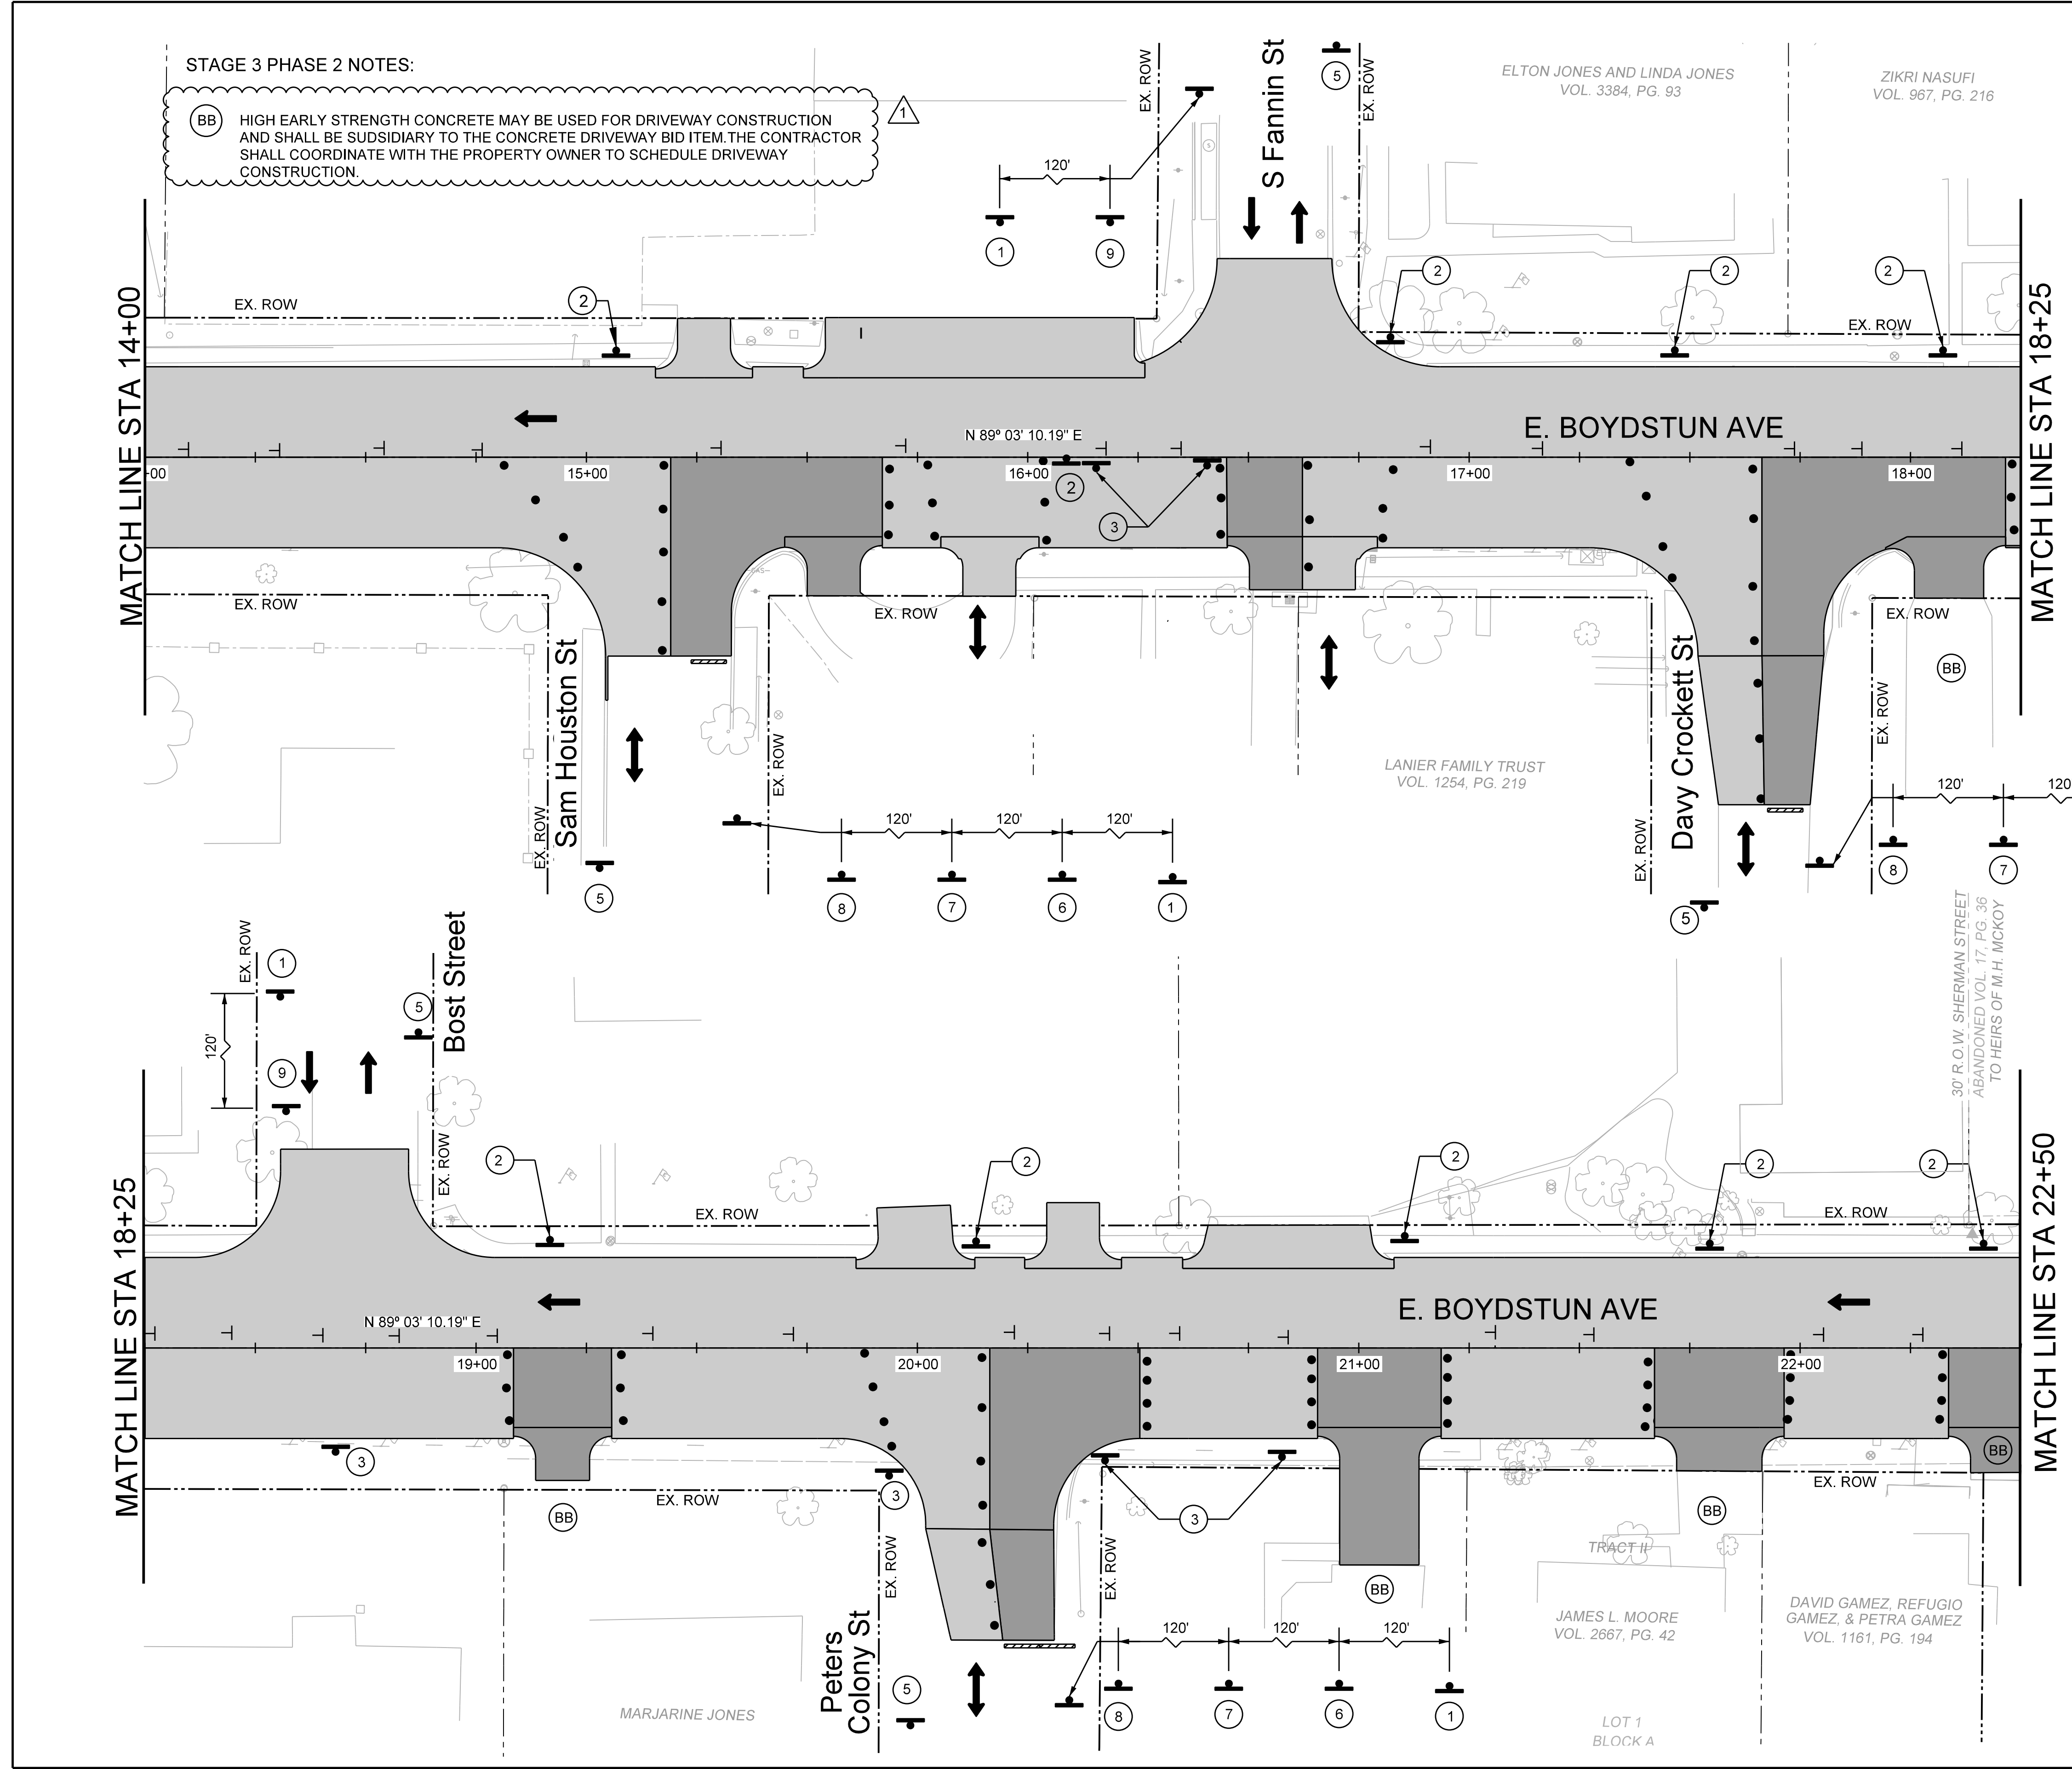

ADDENDUM 1: 9-22-2017

\$DATES