




**PROPOSED TYPICAL SECTION
STA 10+41.00 TO STA 17+50.00**

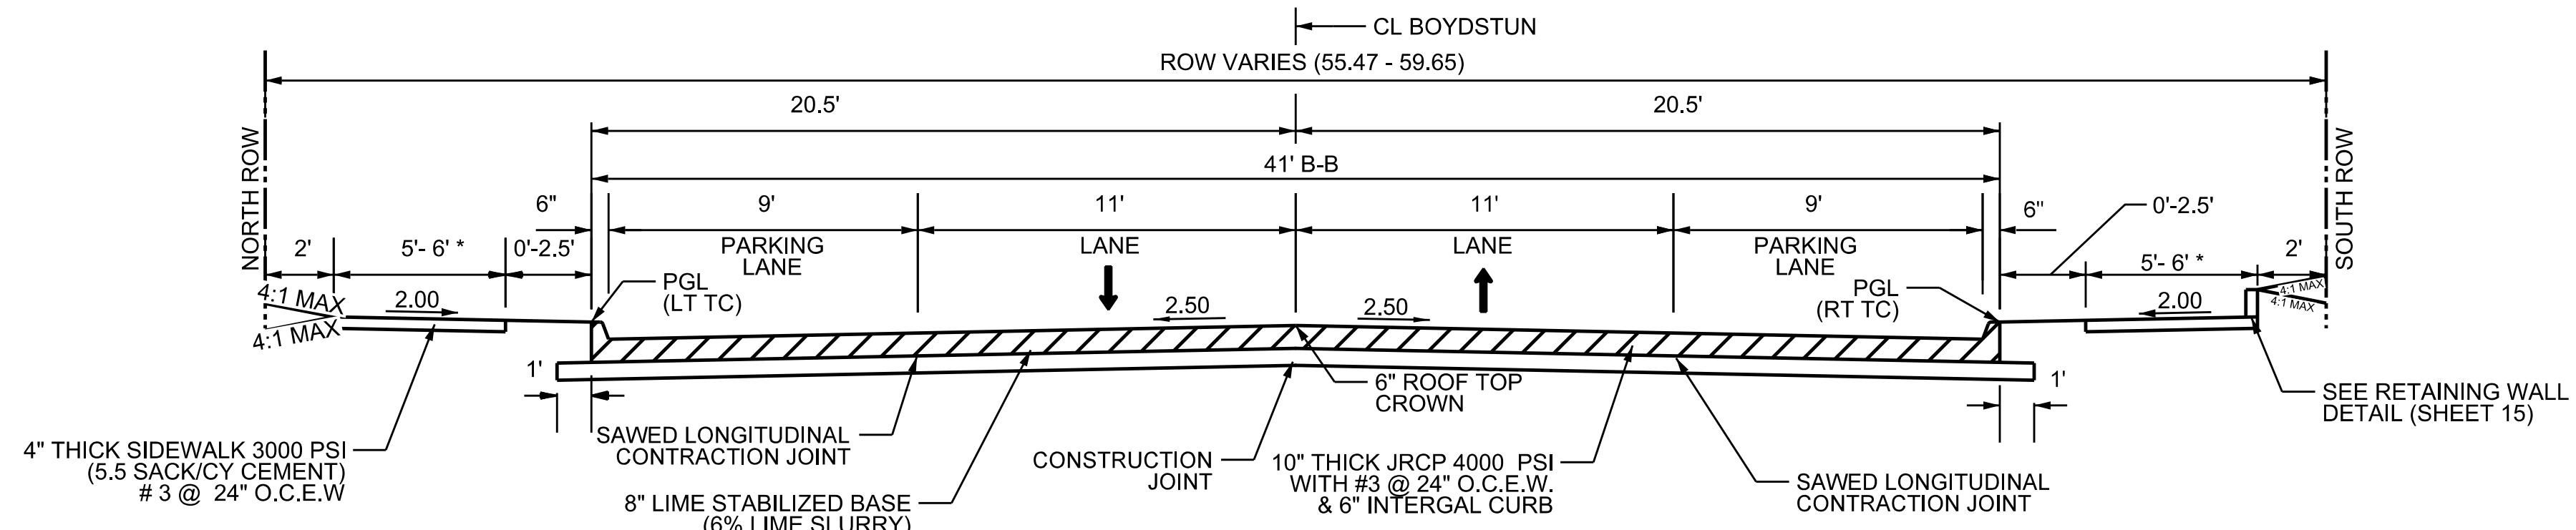

**PROPOSED TYPICAL SECTION
STA 12+18.00 TO STA 16+40.00
(NO PARKING ON NORTHSIDE OF STREET)
STA 17+50.00 TO STA 28+18.46**

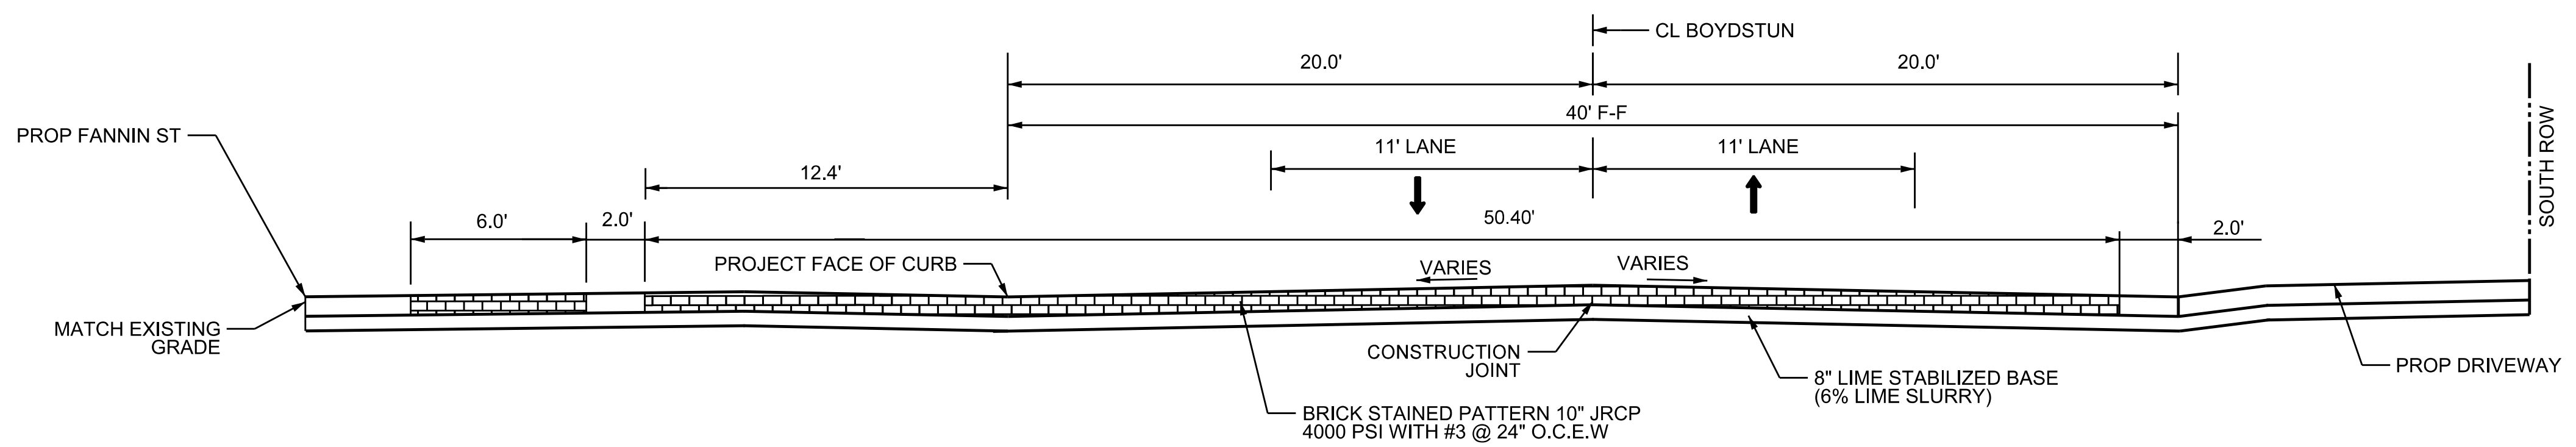

PROPOSED BOYDSTUN/ FANNIN TYPICAL SECTION

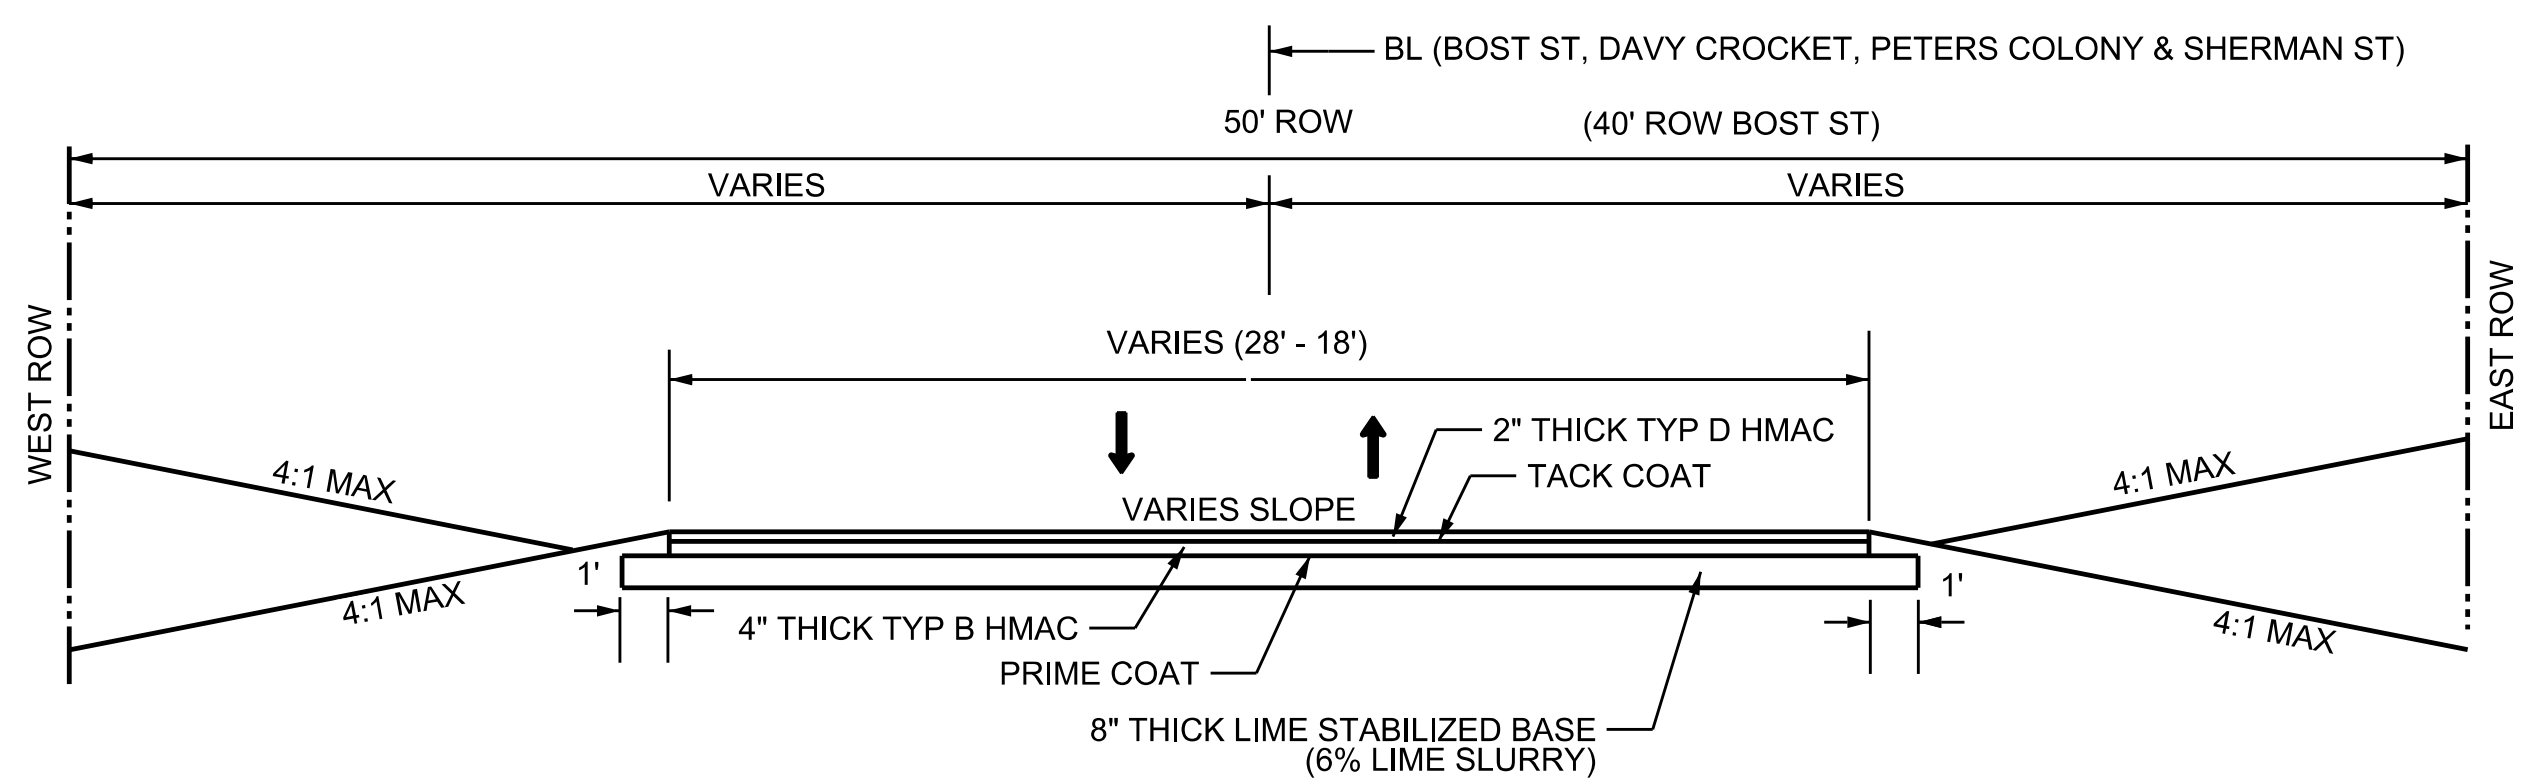


PROPOSED ASPHALT TAPER TYPICAL SECTION

- NOTE:
1. SEE NCTCOG DETAIL 2170 JOINT LUG DETAIL FOR SIDEWALK ADJACENT TO CURB AND LUG SHOULD BE DOWELED IN WITH #3 BARS ON 24" CENTERS APPROXIMATELY 3" INTO CURB AND ANCHORED WITH EPOXY RESIN.
 2. SIDEWALK WIDTH SHALL BE 6' AGAINST CURB AND 5' AWAY FROM CURB.
 3. APPLY TACK COAT MS-2 OR SS-1 AT A RATE OF 0.10 GAL/SY OR AS DIRECTED BY THE ENGINEER.
 4. APPLY PRIME COAT (MC-30) AT A RATE OF 0.20 GAL/SY OR DIRECTED BY THE ENGINEER.

RECORD DRAWING
THIS DRAWING IS A COMPILED COPY OF THE SEALED ENGINEERING DRAWING FOR THIS PROJECT, MODIFIED BY ADDENDA, CHANGE ORDERS AND INFORMATION FURNISHED BY THE CONTRACTOR. THE INFORMATION SHOWN ON THIS RECORD DRAWING WAS PROVIDED BY THE CONTRACTOR OR OTHERS NOT ASSOCIATED WITH THE DESIGN ENGINEER. THE ORIGINAL SEALED DRAWINGS ARE ON FILE AT THE OFFICE OF E.JES, INC., T.B.P.E. FIRM REGISTRATION NO. 2488.

James Allen JULY 26, 2019
James Allen, P.E., TX License No. 65929 Date

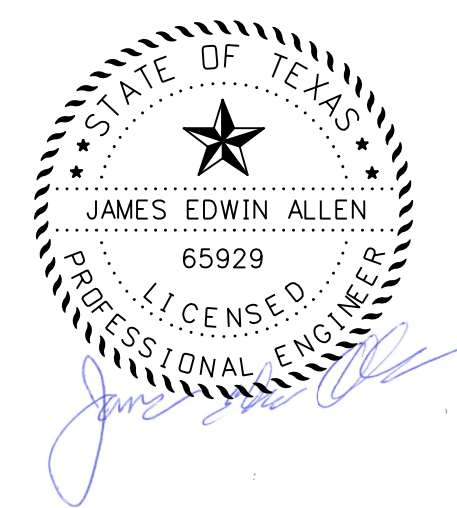

EJES INCORPORATED						
12655 N Central Expy, Suite # 500, Dallas, Texas 75243. Tel # 214-343-1210, Fax # 214-343-3885 FIRM REGISTRATION No: F-2488						
TYPICAL SECTIONS						
E. BOYDSTUN AVE.						
FROM S. GOLIAD ST TO S. CLARK ST						
PUBLIC WORKS DEPARTMENT						
CITY OF ROCKWALL, TEXAS						
DESIGN	DRAWN	DATE	SCALE	NOTES	FILE	SHEET NO.
EJES	EJES	MAY 2017				6