




\$DATES

RECORD DRAWING
 THIS DRAWING IS A COMPILATION OF A COPY OF THE SCALED ENGINEERING DRAWING FOR THIS PROJECT, MODIFIED BY ADDENDA, CHANGE ORDERS AND INFORMATION FURNISHED BY THE CONTRACTOR. THE INFORMATION SHOWN ON THIS RECORD DRAWING THAT WAS PROVIDED BY THE CONTRACTOR OR OTHERS NOT ASSOCIATED WITH THE DESIGN ENGINEER CANNOT BE VERIFIED FOR ACCURACY OR COMPLETENESS. THE ORIGINAL SEALED DRAWINGS ARE ON FILE AT THE OFFICE OF E.J.E.S., INC., TBPE FIRM REGISTRATION NO. 2488.
 James Allen, P.E., TX License No. 65929 Date: JULY 26, 2015

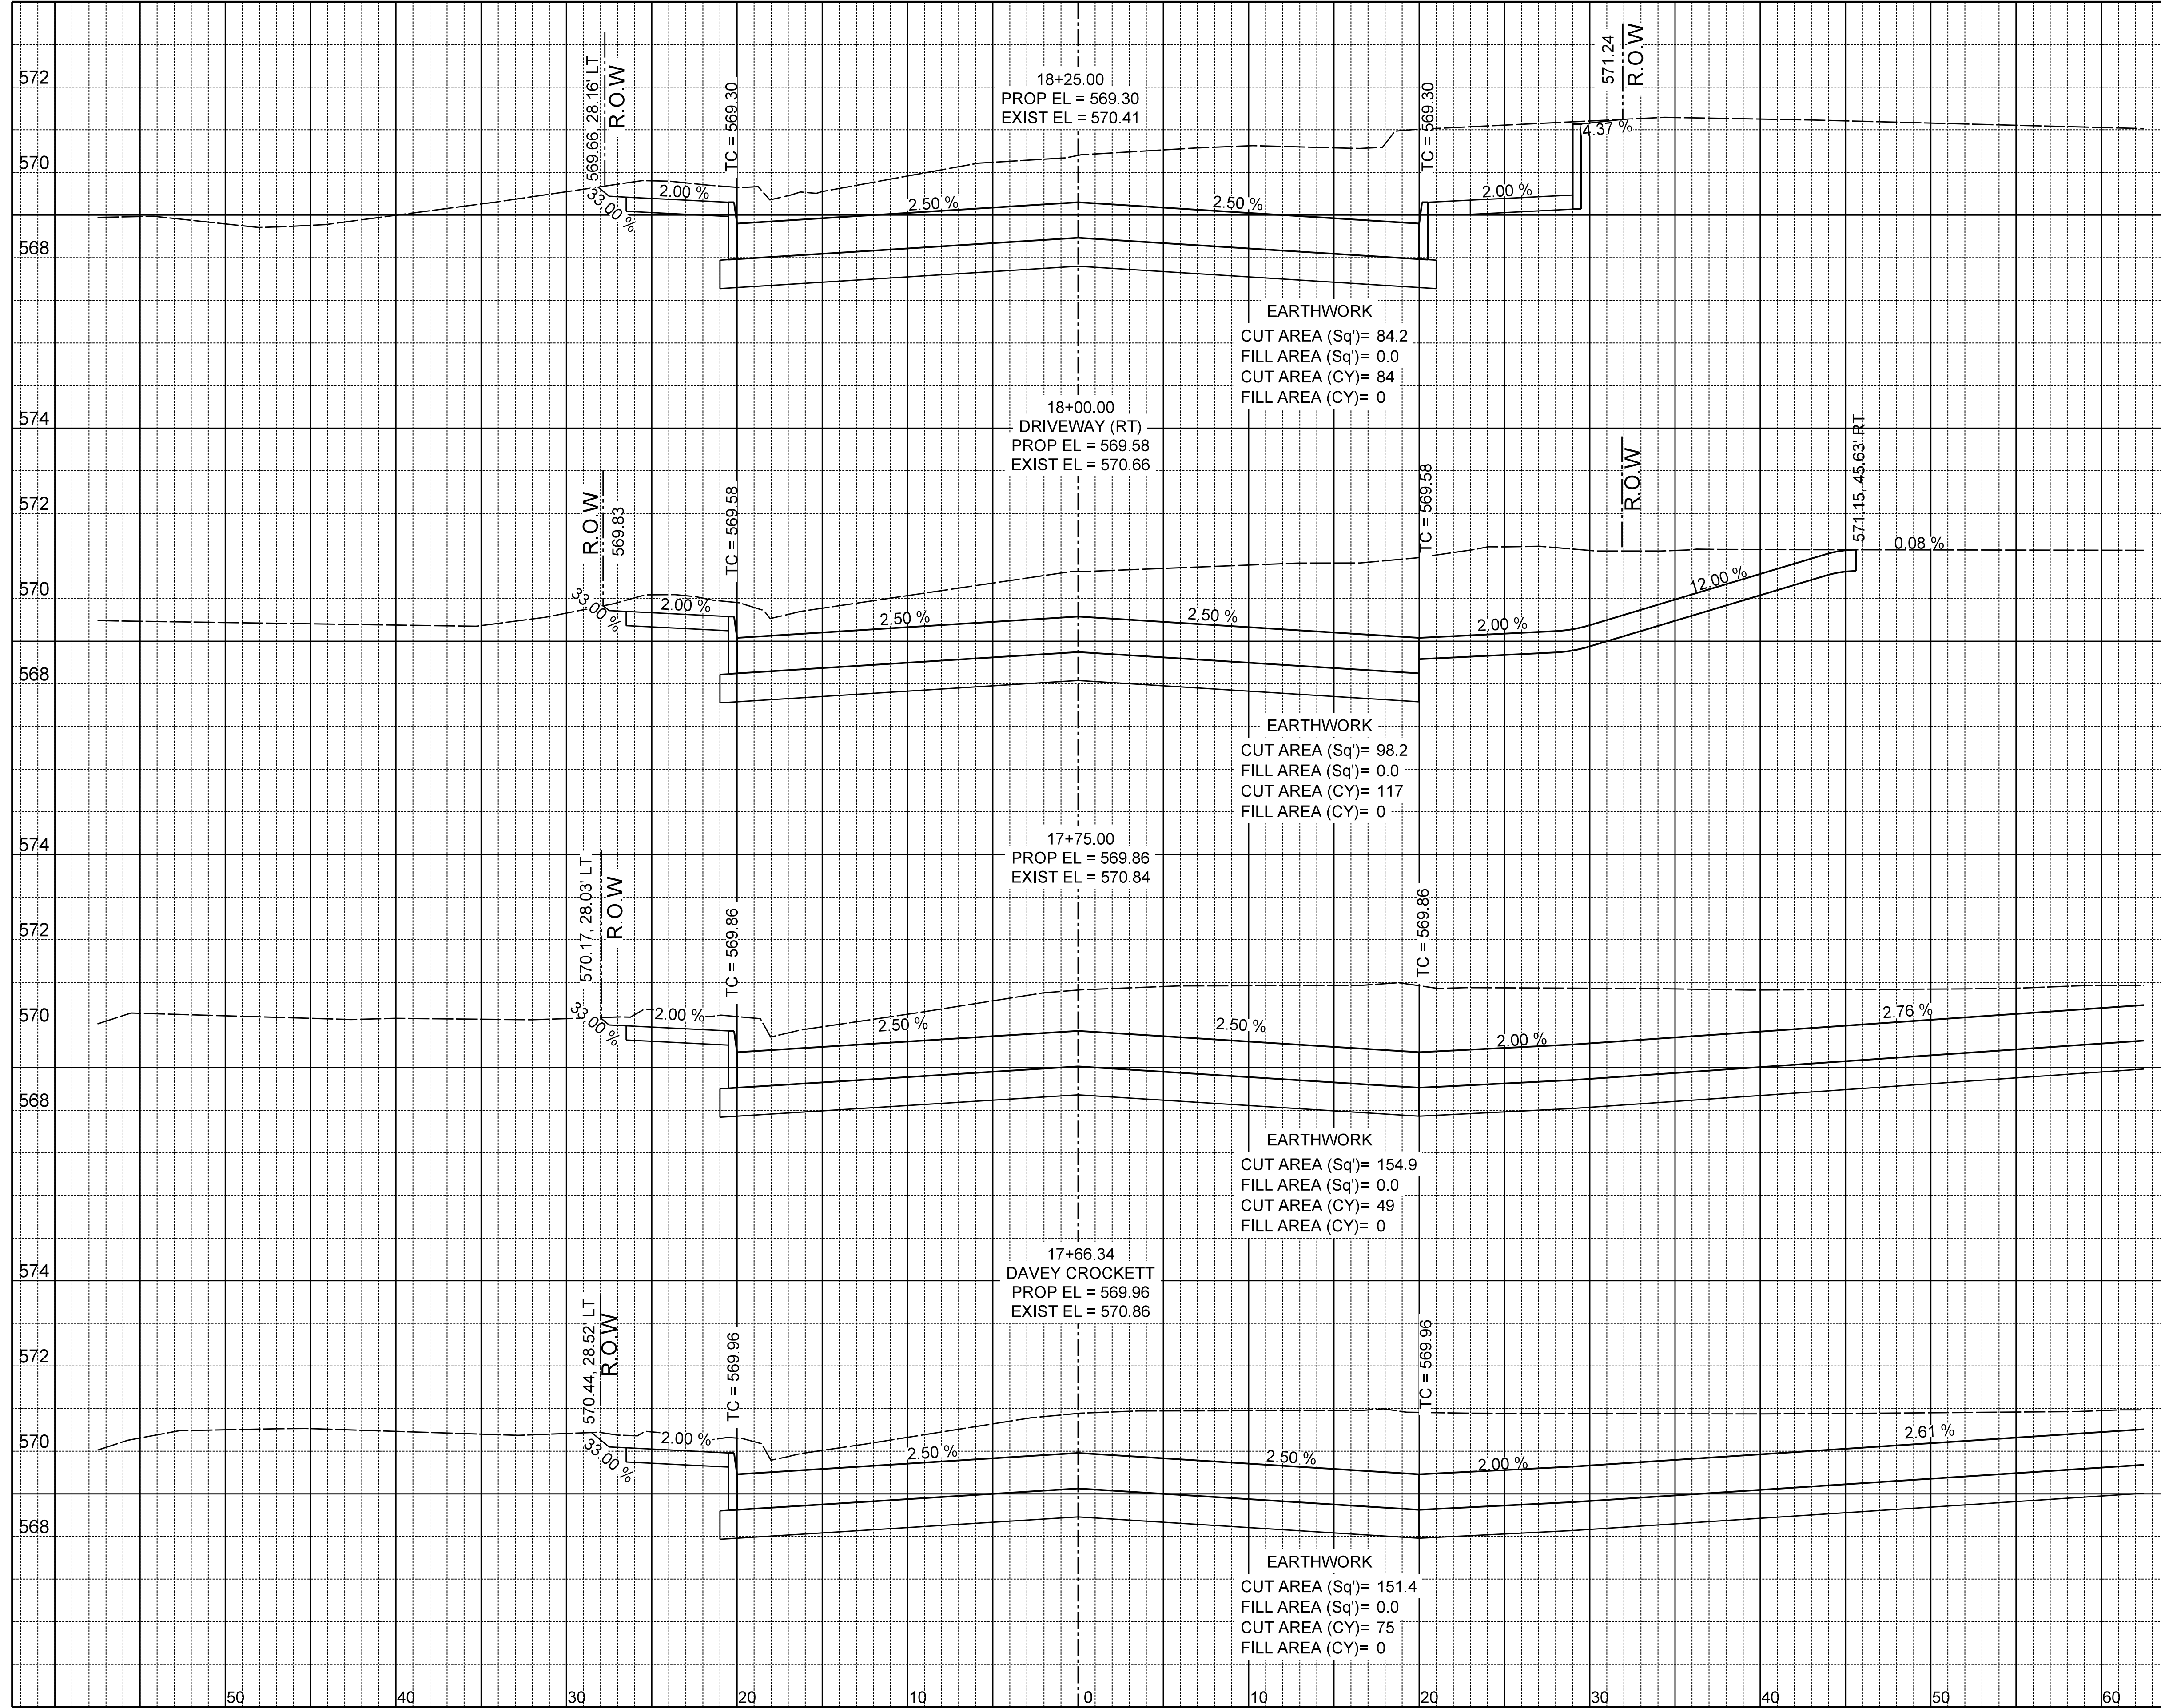

EARTHWORK
 CUT AREA (Sq')= 84.2
 FILL AREA (Sq')= 0.0
 CUT AREA (CY)= 84
 FILL AREA (CY)= 0

EARTHWORK
 CUT AREA (Sq')= 98.2
 FILL AREA (Sq')= 0.0
 CUT AREA (CY)= 117
 FILL AREA (CY)= 0

EARTHWORK
 CUT AREA (Sq')= 154.9
 FILL AREA (Sq')= 0.0
 CUT AREA (CY)= 49
 FILL AREA (CY)= 0

EARTHWORK
 CUT AREA (Sq')= 151.4
 FILL AREA (Sq')= 0.0
 CUT AREA (CY)= 75
 FILL AREA (CY)= 0

11
27

EJES INCORPORATED
 12655 N Central Expy, Suite # 500, Dallas, Texas 75243.
 Tel # 214-343-1210, Fax # 214-343-3885
 FIRM REGISTRATION No: F-2488

CROSS SECTIONS						
BOYDSTUN STREET						
FROM S. GOLIAD ST TO S. CLARK ST						
PUBLIC WORKS DEPARTMENT						
CITY OF ROCKWALL, TEXAS						
DESIGN	DRAWN	DATE	SCALE	NOTES	FILE	NO.
EJES	EJES	NOV 2015	1"=10' H 1"=4' V			77