




\$DATES

RECORD DRAWING
 THIS DRAWING IS A COMPILATION OF A COPY OF THE SCALED ENGINEERING DRAWING FOR THIS PROJECT, MODIFIED BY ADDENDA, CHANGE ORDERS AND INFORMATION FURNISHED BY THE CONTRACTOR. THE INFORMATION SHOWN ON THIS RECORD DRAWING THAT WAS PROVIDED BY THE CONTRACTOR OR OTHERS NOT ASSOCIATED WITH THE DESIGN ENGINEER CANNOT BE VERIFIED FOR ACCURACY OR COMPLETENESS. THE ORIGINAL SEALED DRAWINGS ARE ON FILE AT THE OFFICE OF E.J.E.S., INC., TBPE FIRM REGISTRATION No. 2488.
 James Allen, P.E., TX License No. 65929 Date: JULY 26, 2015

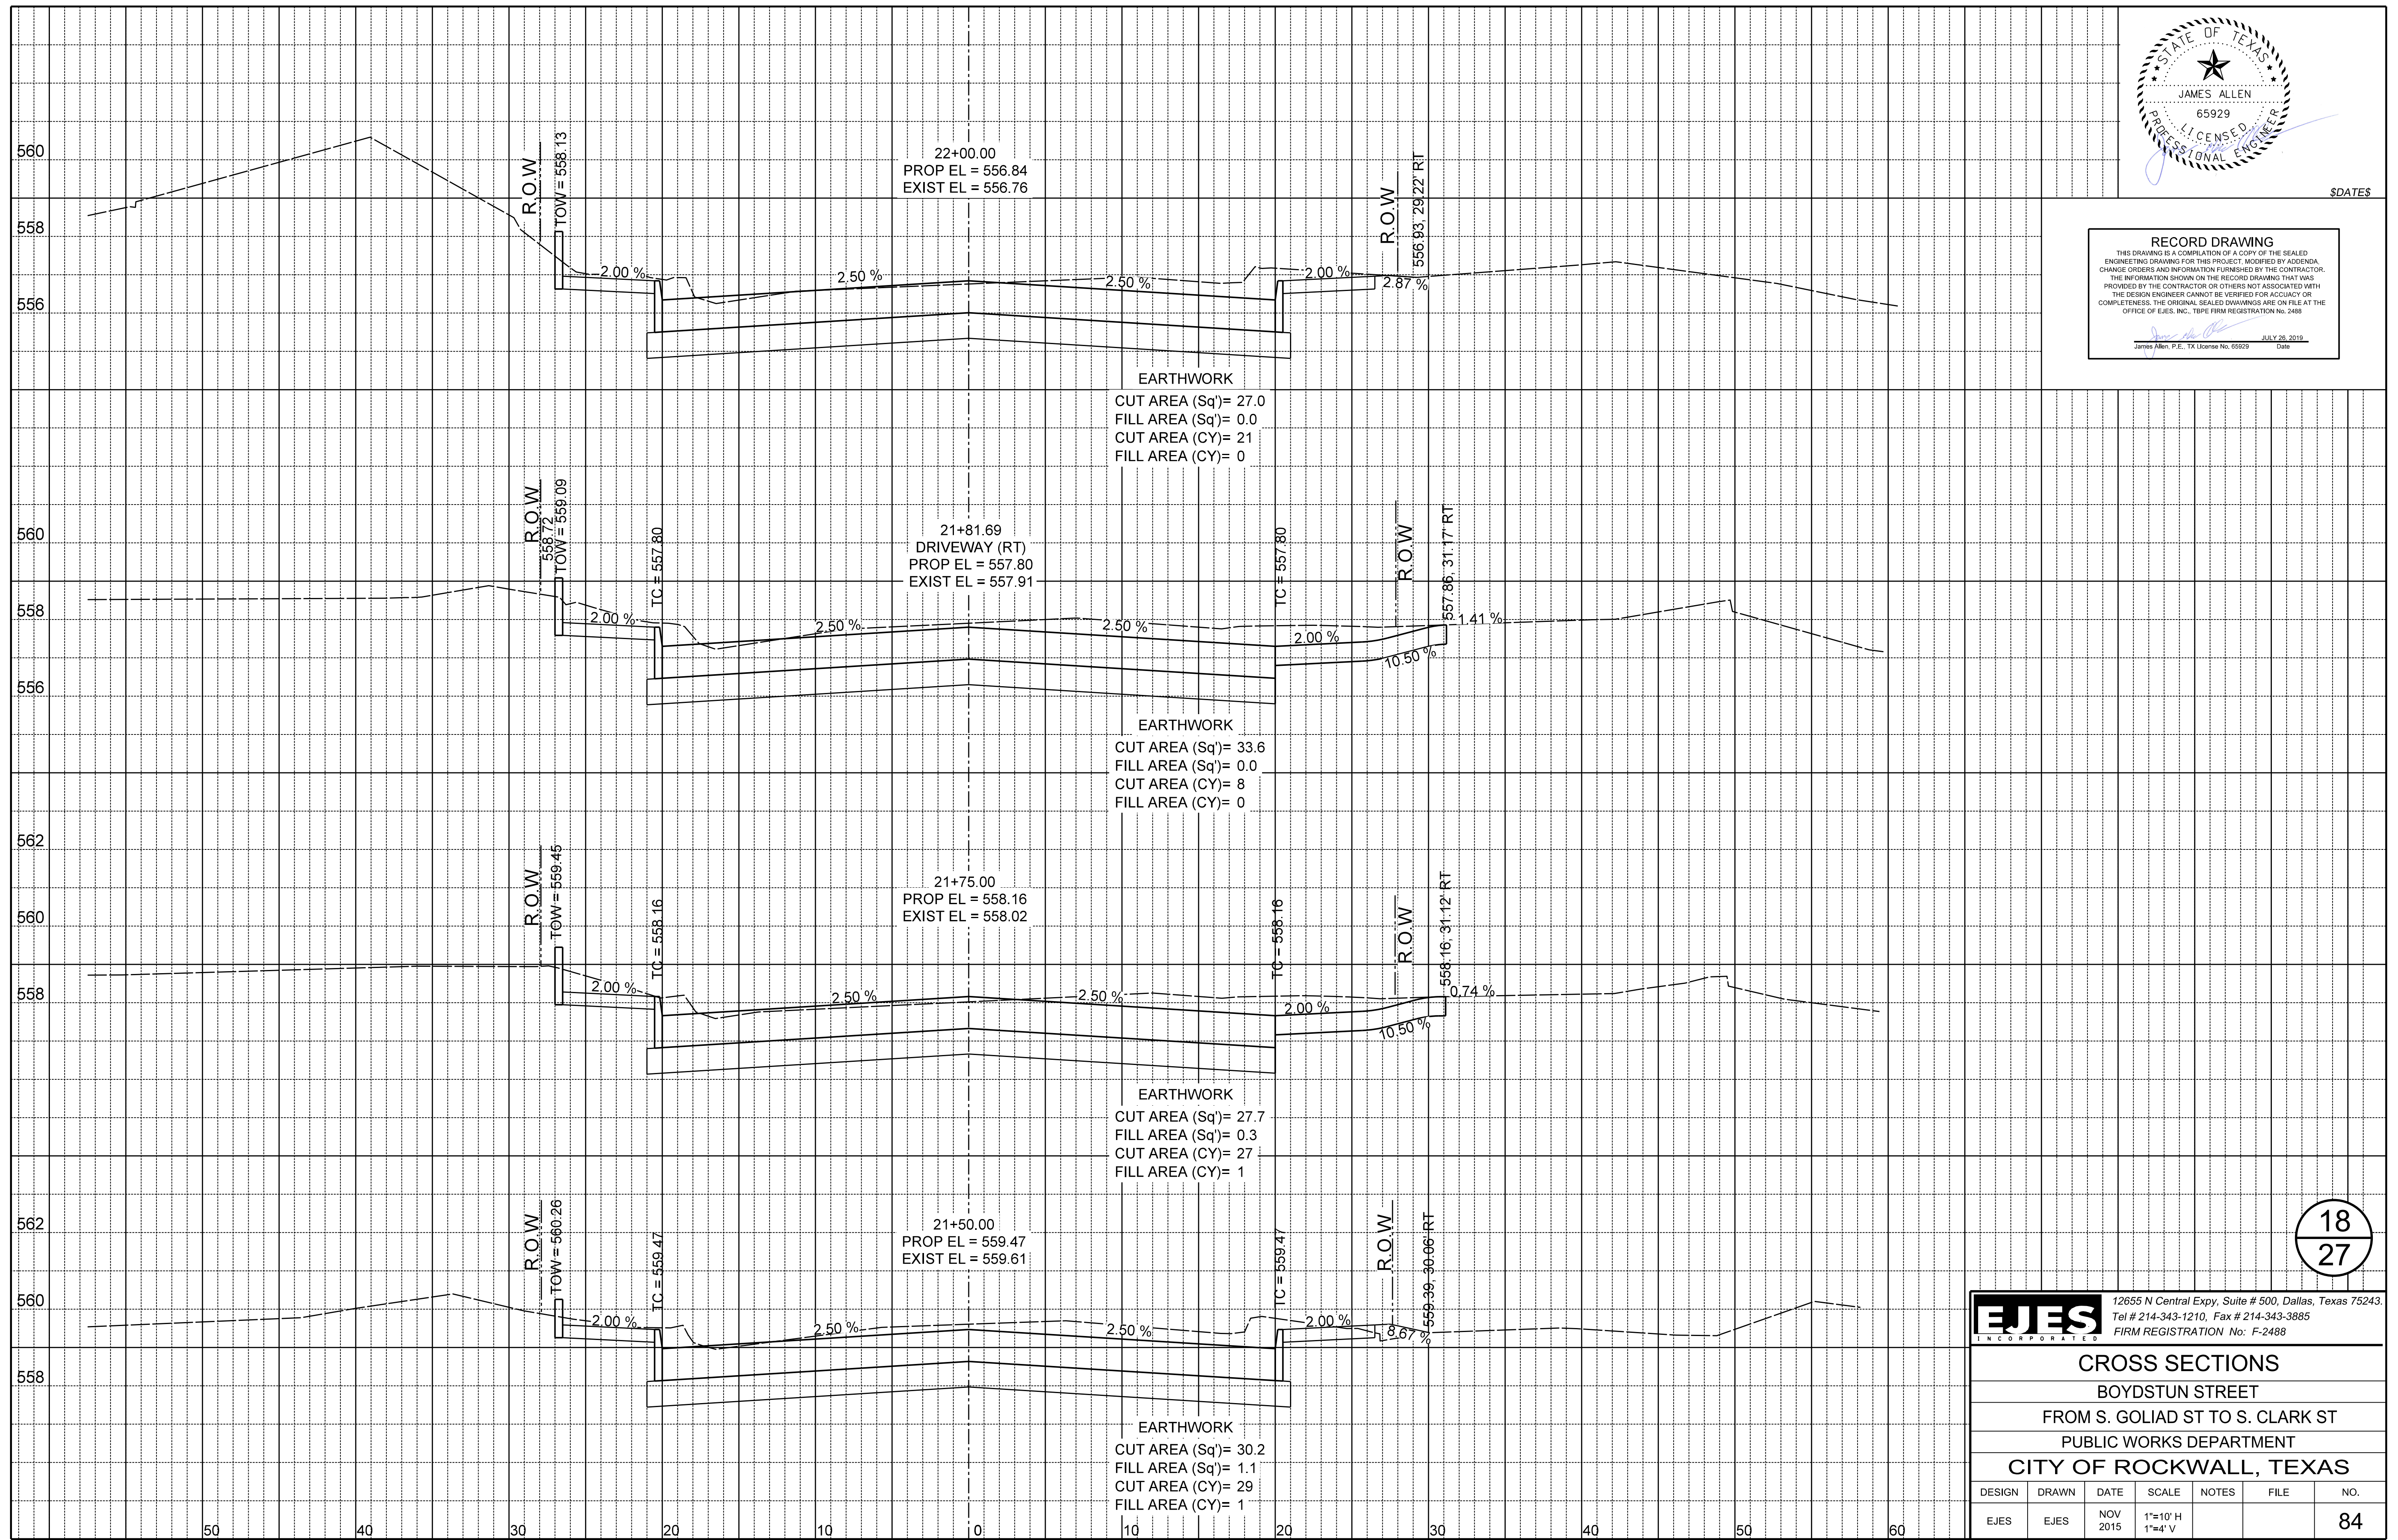

18
27

EJES INCORPORATED		12655 N Central Expy, Suite # 500, Dallas, Texas 75243. Tel # 214-343-1210, Fax # 214-343-3885 FIRM REGISTRATION No: F-2488			
CROSS SECTIONS					
BOYDSTUN STREET					
FROM S. GOLIAD ST TO S. CLARK ST					
PUBLIC WORKS DEPARTMENT					
CITY OF ROCKWALL, TEXAS					
DESIGN	DRAWN	DATE	SCALE	NOTES	FILE NO.
EJES	EJES	NOV 2015	1"=10' H 1"=4' V		84