

**UTILITY OWNERS**

Lone Star Gas - 722-8366  
206 West Rusk Street  
Rockwall, Texas 75087

Texas Power & Light 722-8393  
P.O. Box 39  
Rockwall, Texas 75087

STORER Cable Television - 840-2388  
Jim Hough - 722-0202  
934 East Centerville  
Garland, Texas 75041

Telephone Co.  
Southwestern Bell - (214) 990-5800.

Water & Sewer Dept.  
George Barnett - 226-7885  
205 West Rusk St.  
Rockwall, Texas 75087


Director of Community Services  
Ed Heath - 226-7885  
205 West Rusk St.  
Rockwall, Texas 75087

**TABLE OF CONTENTS**

SHEET No.	DESCRIPTION
1	COVER SHEET
2	LOCATION MAP & MISC. INFORMATION
3	20" WATER LINE PLAN PROFILE STA. 1+00 - 13+00
4	20" WATER LINE PLAN PROFILE STA. 13+00 - 25+00
5	20" WATER LINE PLAN PROFILE STA. 25+00 - 37+00
6	20" WATER LINE PLAN PROFILE STA. 37+00 - 49+00
7	20" WATER LINE PLAN PROFILE STA. 49+00 - 58+07
8	MISC. WATER LINE DETAILS
9	MISC. WATER LINE DETAILS
10	MISC. WATER LINE DETAILS

**LEGEND**

RIGHT-OF-WAY	— — — — —
SURVEY BASELINE	— — — — —
ADOPTED BASELINE	— — — — —
PROPOSED WATER LINES	— — — — —
PROPOSED MANUAL AIR 1 RELEASE VALVE	— — — — —
PROPOSED CATHODIC PROTECTION TEST STATION	— — — — —
PROPOSED HIGH PRESSURE WATER LINE (WARNING SIGN)	— — — — —
PROPOSED WATER VALVE	— — — — —
EXISTING SANITARY MANHOLE	— — — — —
EXISTING SANITARY SEWER	— — — — —
EXISTING WATER LINE	— — — — —
EXISTING WATER VALVE	— — — — —
EXISTING WATER METER	— — — — —
EXISTING GAS LINE	— — — — —
EXISTING GAS VALVE	— — — — —
EXISTING POWER POLE	— — — — —
EXISTING GUY ANCHOR	— — — — —
EXISTING POWER CABLE UNDERGROUND	— — — — —
EXISTING TELEPHONE POLE	— — — — —
EXISTING TELEPHONE PEDESTAL	— — — — —
EXISTING TELEPHONE UNDERGROUND CABLE	— — — — —
EXISTING UNDERGROUND STRUCTURE	— — — — —

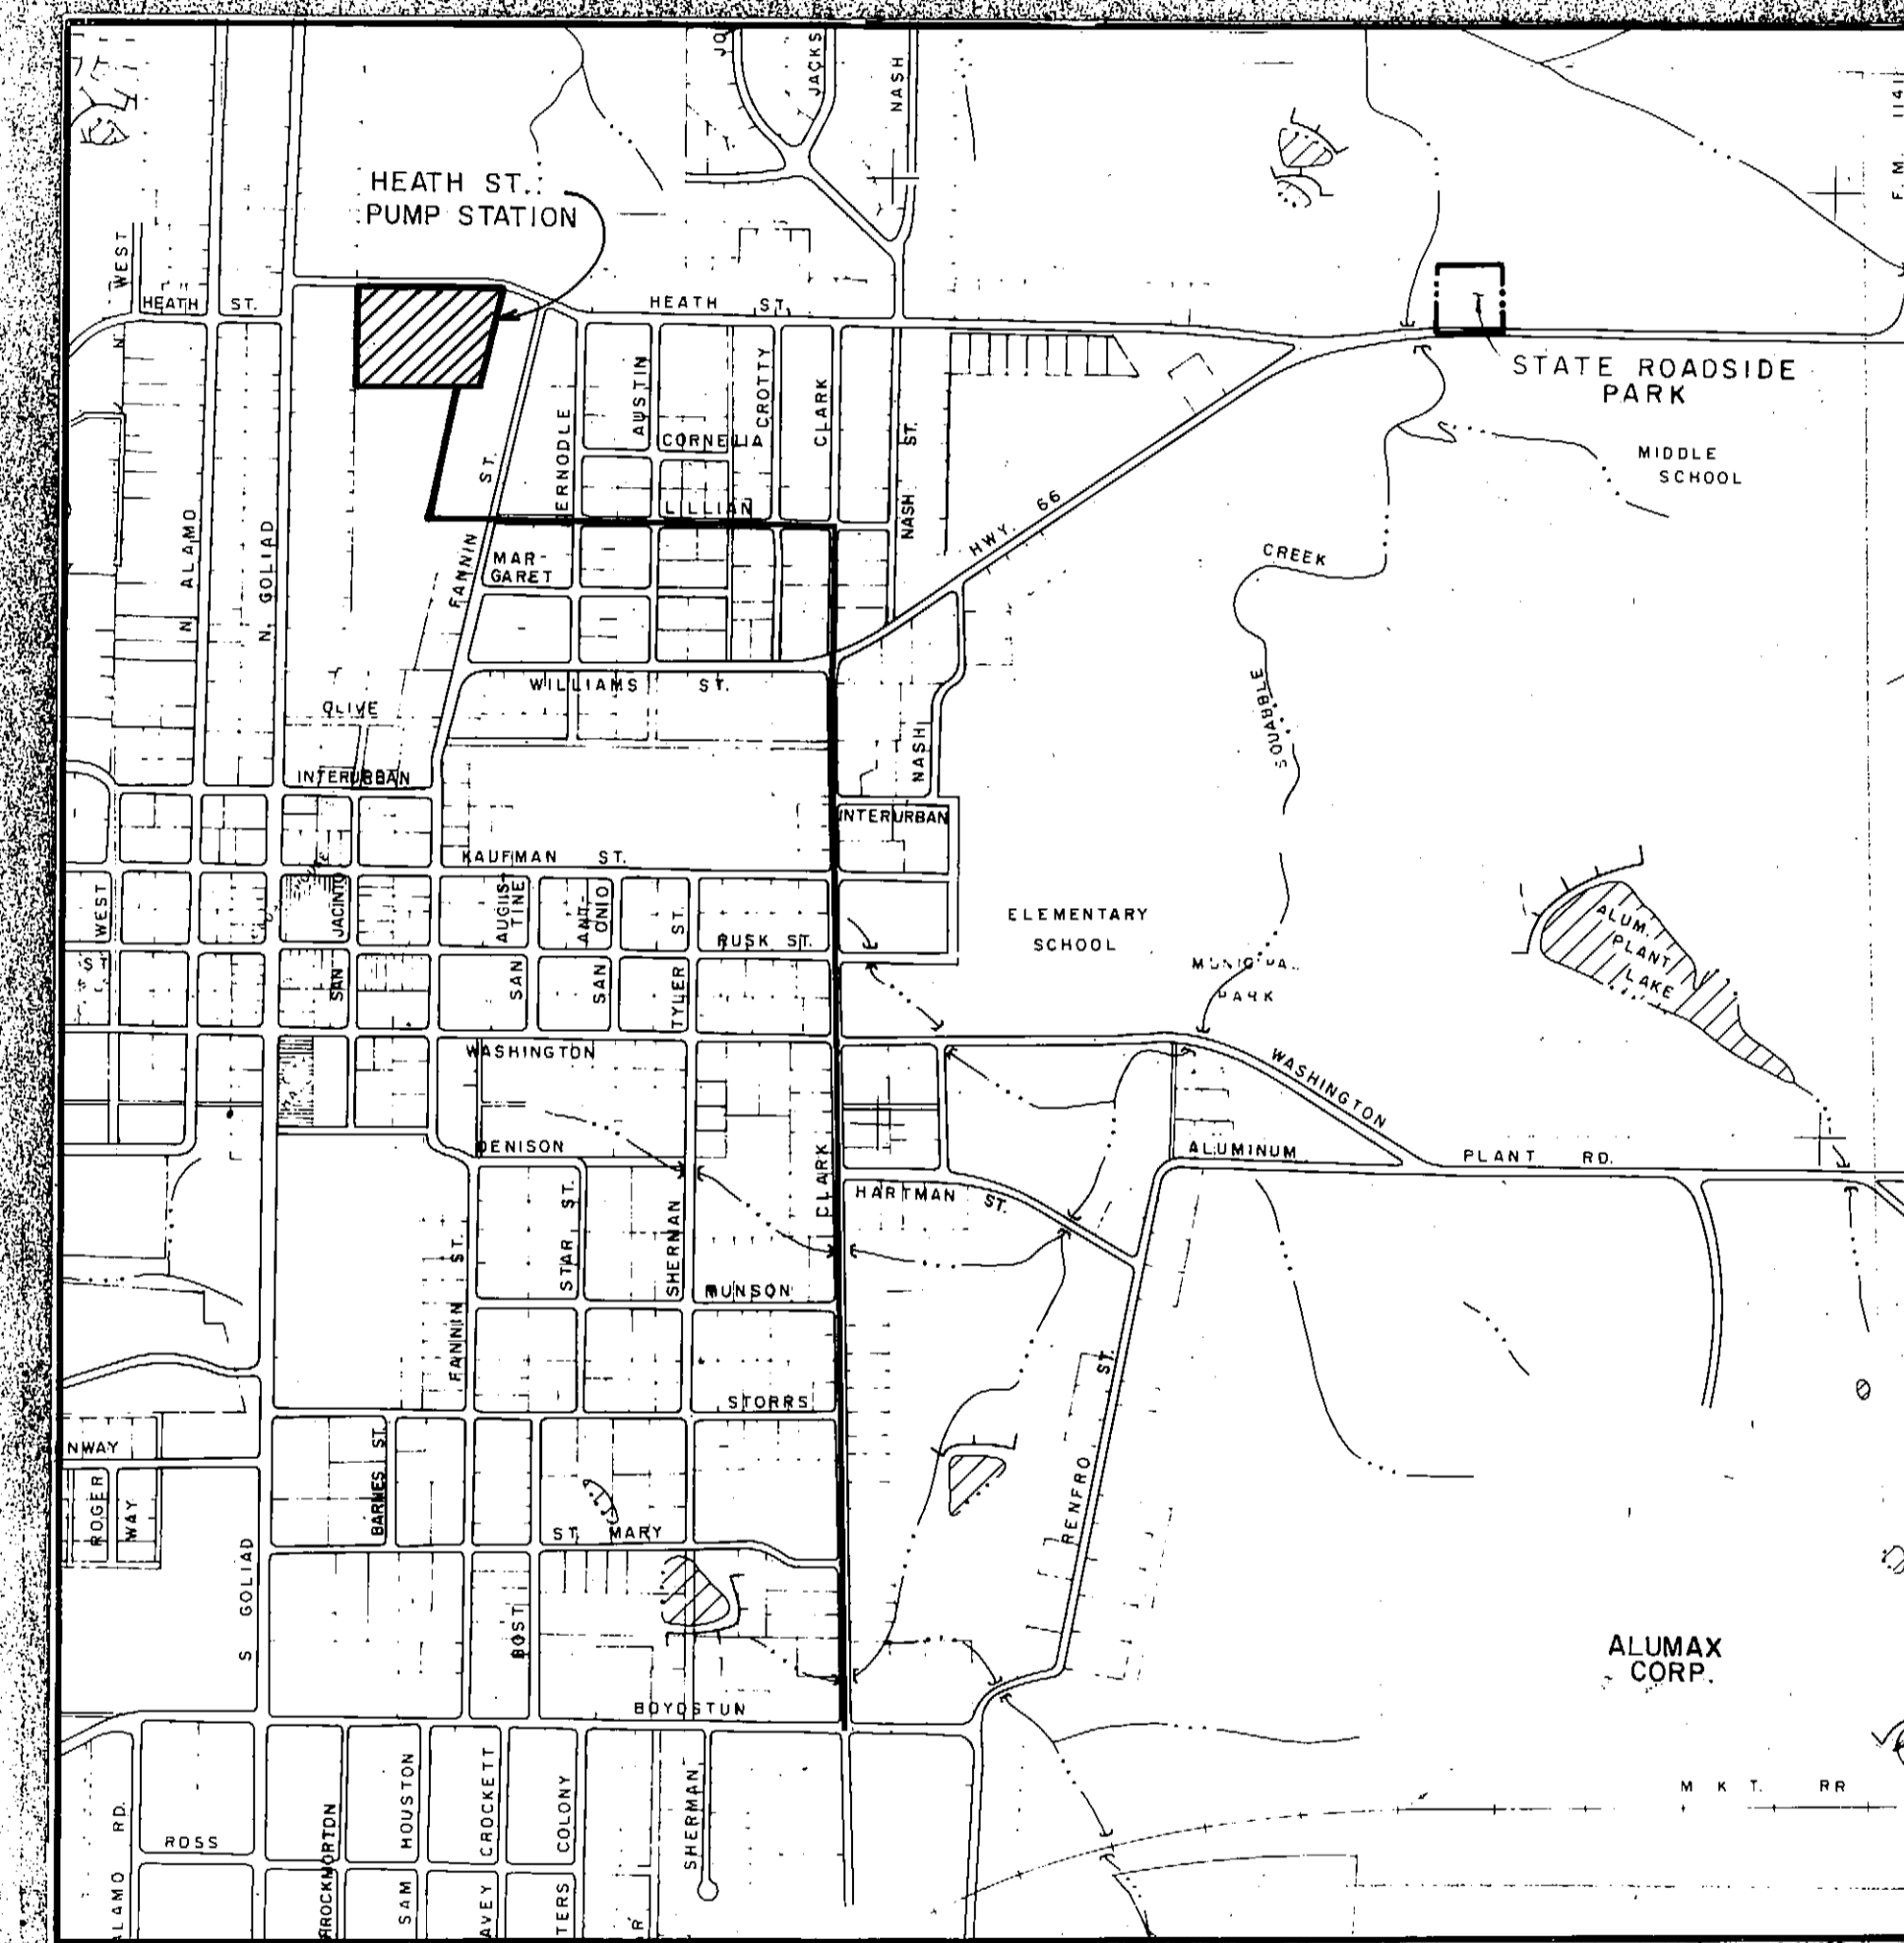

**LOCATION MAP**  
N.T.S.

RECORD DRAWING  
DATE 1-17-84 BY DEB

DATE	REVISION	DESIGNED	DRAWN	TRACED	CHECKED	JOB NO.	DATE	SCALE
		WLB	WLB		JAV	804-0001	1/17/84	AS SHOWN

FRESE AND NICHOLS  
CONSULTING ENGINEERS  
FORT WORTH-AUSTIN, TEXAS

EAST SIDE WATER DISTRIBUTION PIPELINE

LOCATION MAP & INDEX

SHEET  
2 of 10