

CITY OF ROCKWALL, TEXAS

EASTSIDE PUMP STATION 1.0 M.G. GROUND STORAGE TANK FACILITY AND WATERLINE IMPROVEMENTS

1990

MAYOR

Dr. FRANK R. MILLER

COUNCIL

DAVID ELKINS


PAT LUBY

GARY MARTIN

NORM SELIGMAN

NELL WELBORN

ALMA WILLIAMS

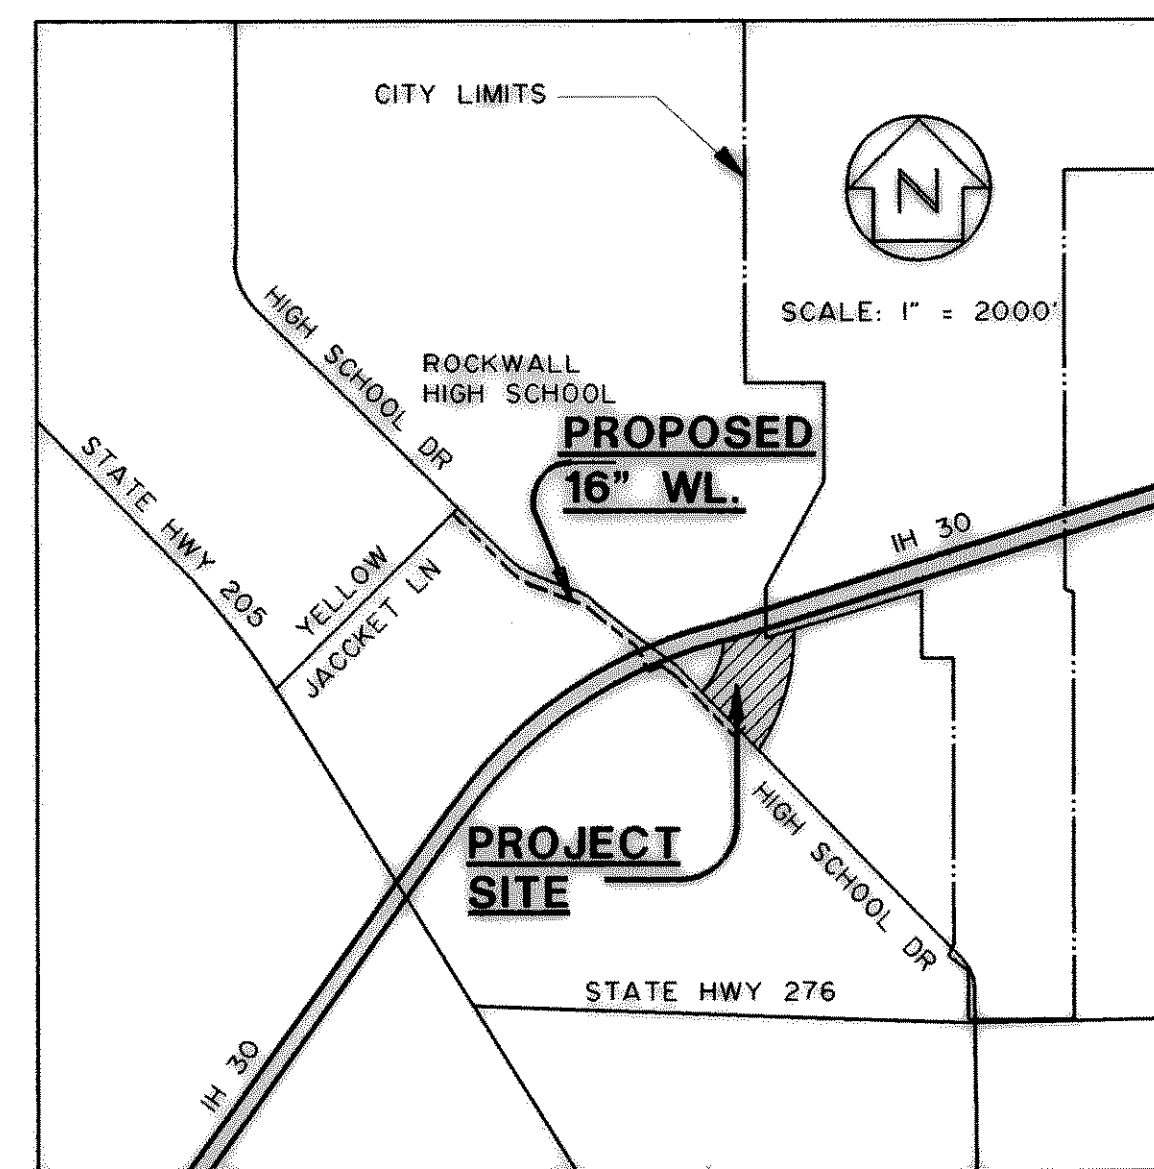

CITY MANAGER

WILLIAM EISEN


CITY ENGINEER

W.L. DOUPHRATE, II P.E.

DIRECTOR OF COMMUNITY SERVICES

ED HEATH

FREESE AND NICHOLS, INC.
CONSULTING ENGINEERS

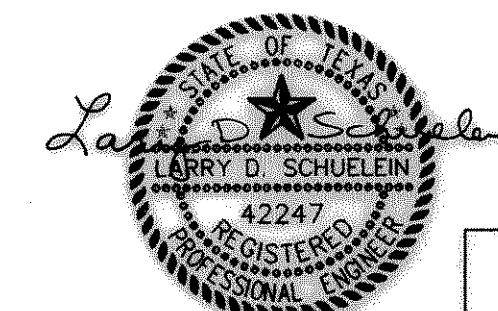

RECORD DRAWING
BASED ON INFORMATION
SUPPLIED BY THE CONTRACTOR
DATE: 10/1/92 BY: LDS

12-4-90