


**RECORD DRAWING**  
 BASED ON INFORMATION  
 SUPPLIED BY THE CONTRACTOR  
 DATE: 10/2/92 BY: LDS

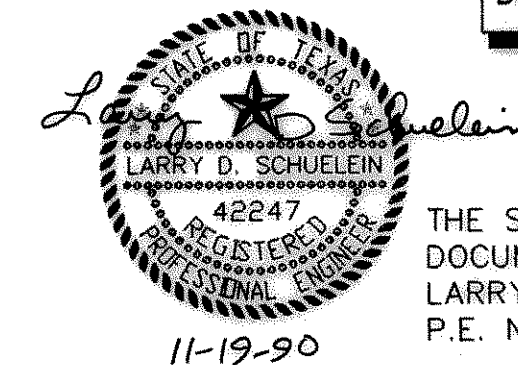

THE SEAL APPEARING ON THIS DOCUMENT WAS AUTHORIZED BY LARRY D. SCHUELEIN, TEXAS P.E. No. 42247 ON NOV. 19, 1990

DATE	REVISION	DESIGNED BY	JOB NO.
10/2/92	REVISED AS PER RECORD DRAWINGS	LDS	ROK89005
		TRACED BY	DATE
			11/19/90
		CHECKED BY	SCALE
			AS SHOWN