



FLOOR PLAN
SC 3/8"=1'-0"

- EXHAUST FAN, EF-3, 1" PENN PIGT 1410 CFM @ 12" wg 1/2" HP @ 120V/1Φ/60HZ
- LOUVER, L-2, AROLITE KB406 24" x 18" x 6" W/ MOTORIZED DAMPERS INTERLOCKED W/ EF-3
- UNIT HEATER, UH-4, MARKEL P3P5107CA1 7.5 KW @ 480V/3Φ/60HZ-9.1AMP 28,600 BTUH/1700 CFM/1000 fpm DCB 253 3P/25A DISC SW AG176 SPST LOW VOLTAGE THERMOSTAT


ROOF PLAN
SC 3/8"=1'-0"

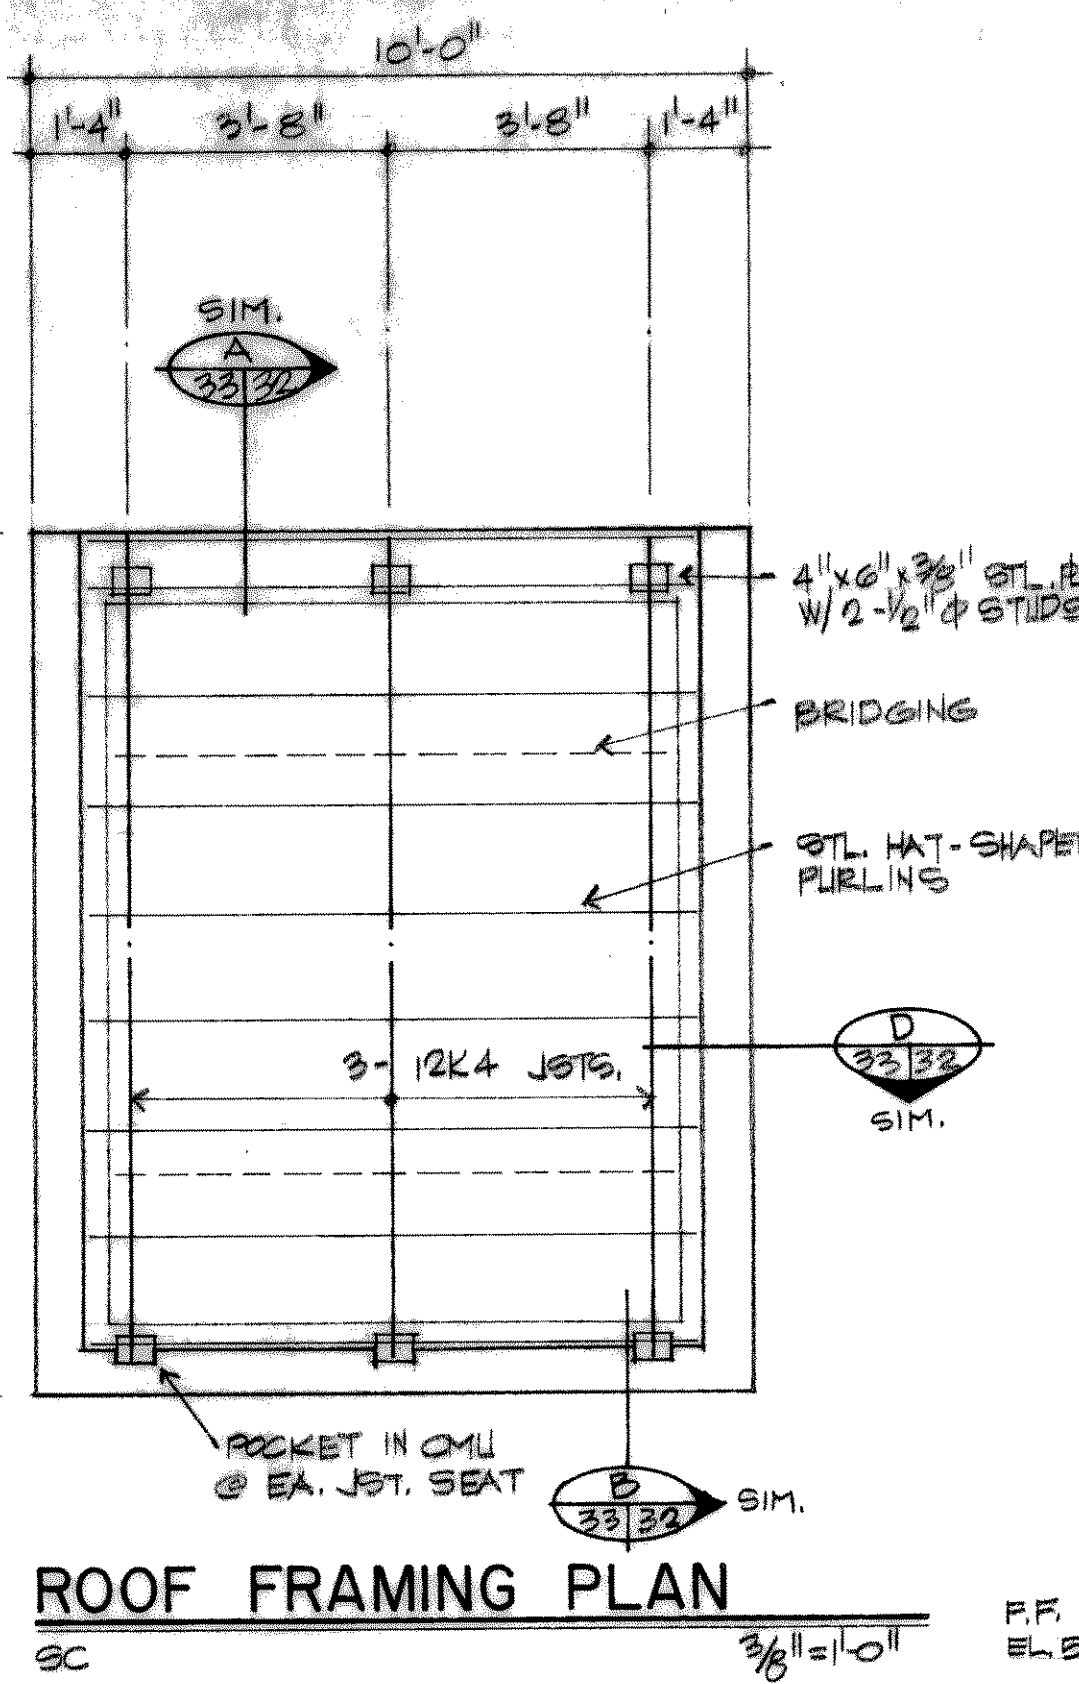


ROOF FRAMING PLAN
SC 3/8"=1'-0"

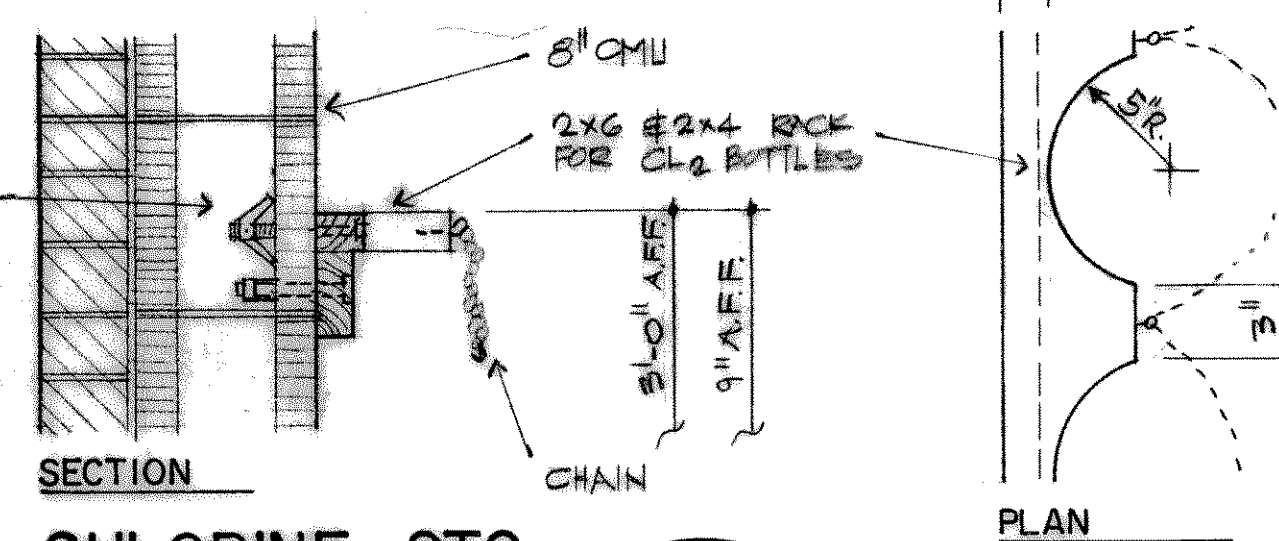


CHLORINE STO.
SC 1/2"=1'-0"

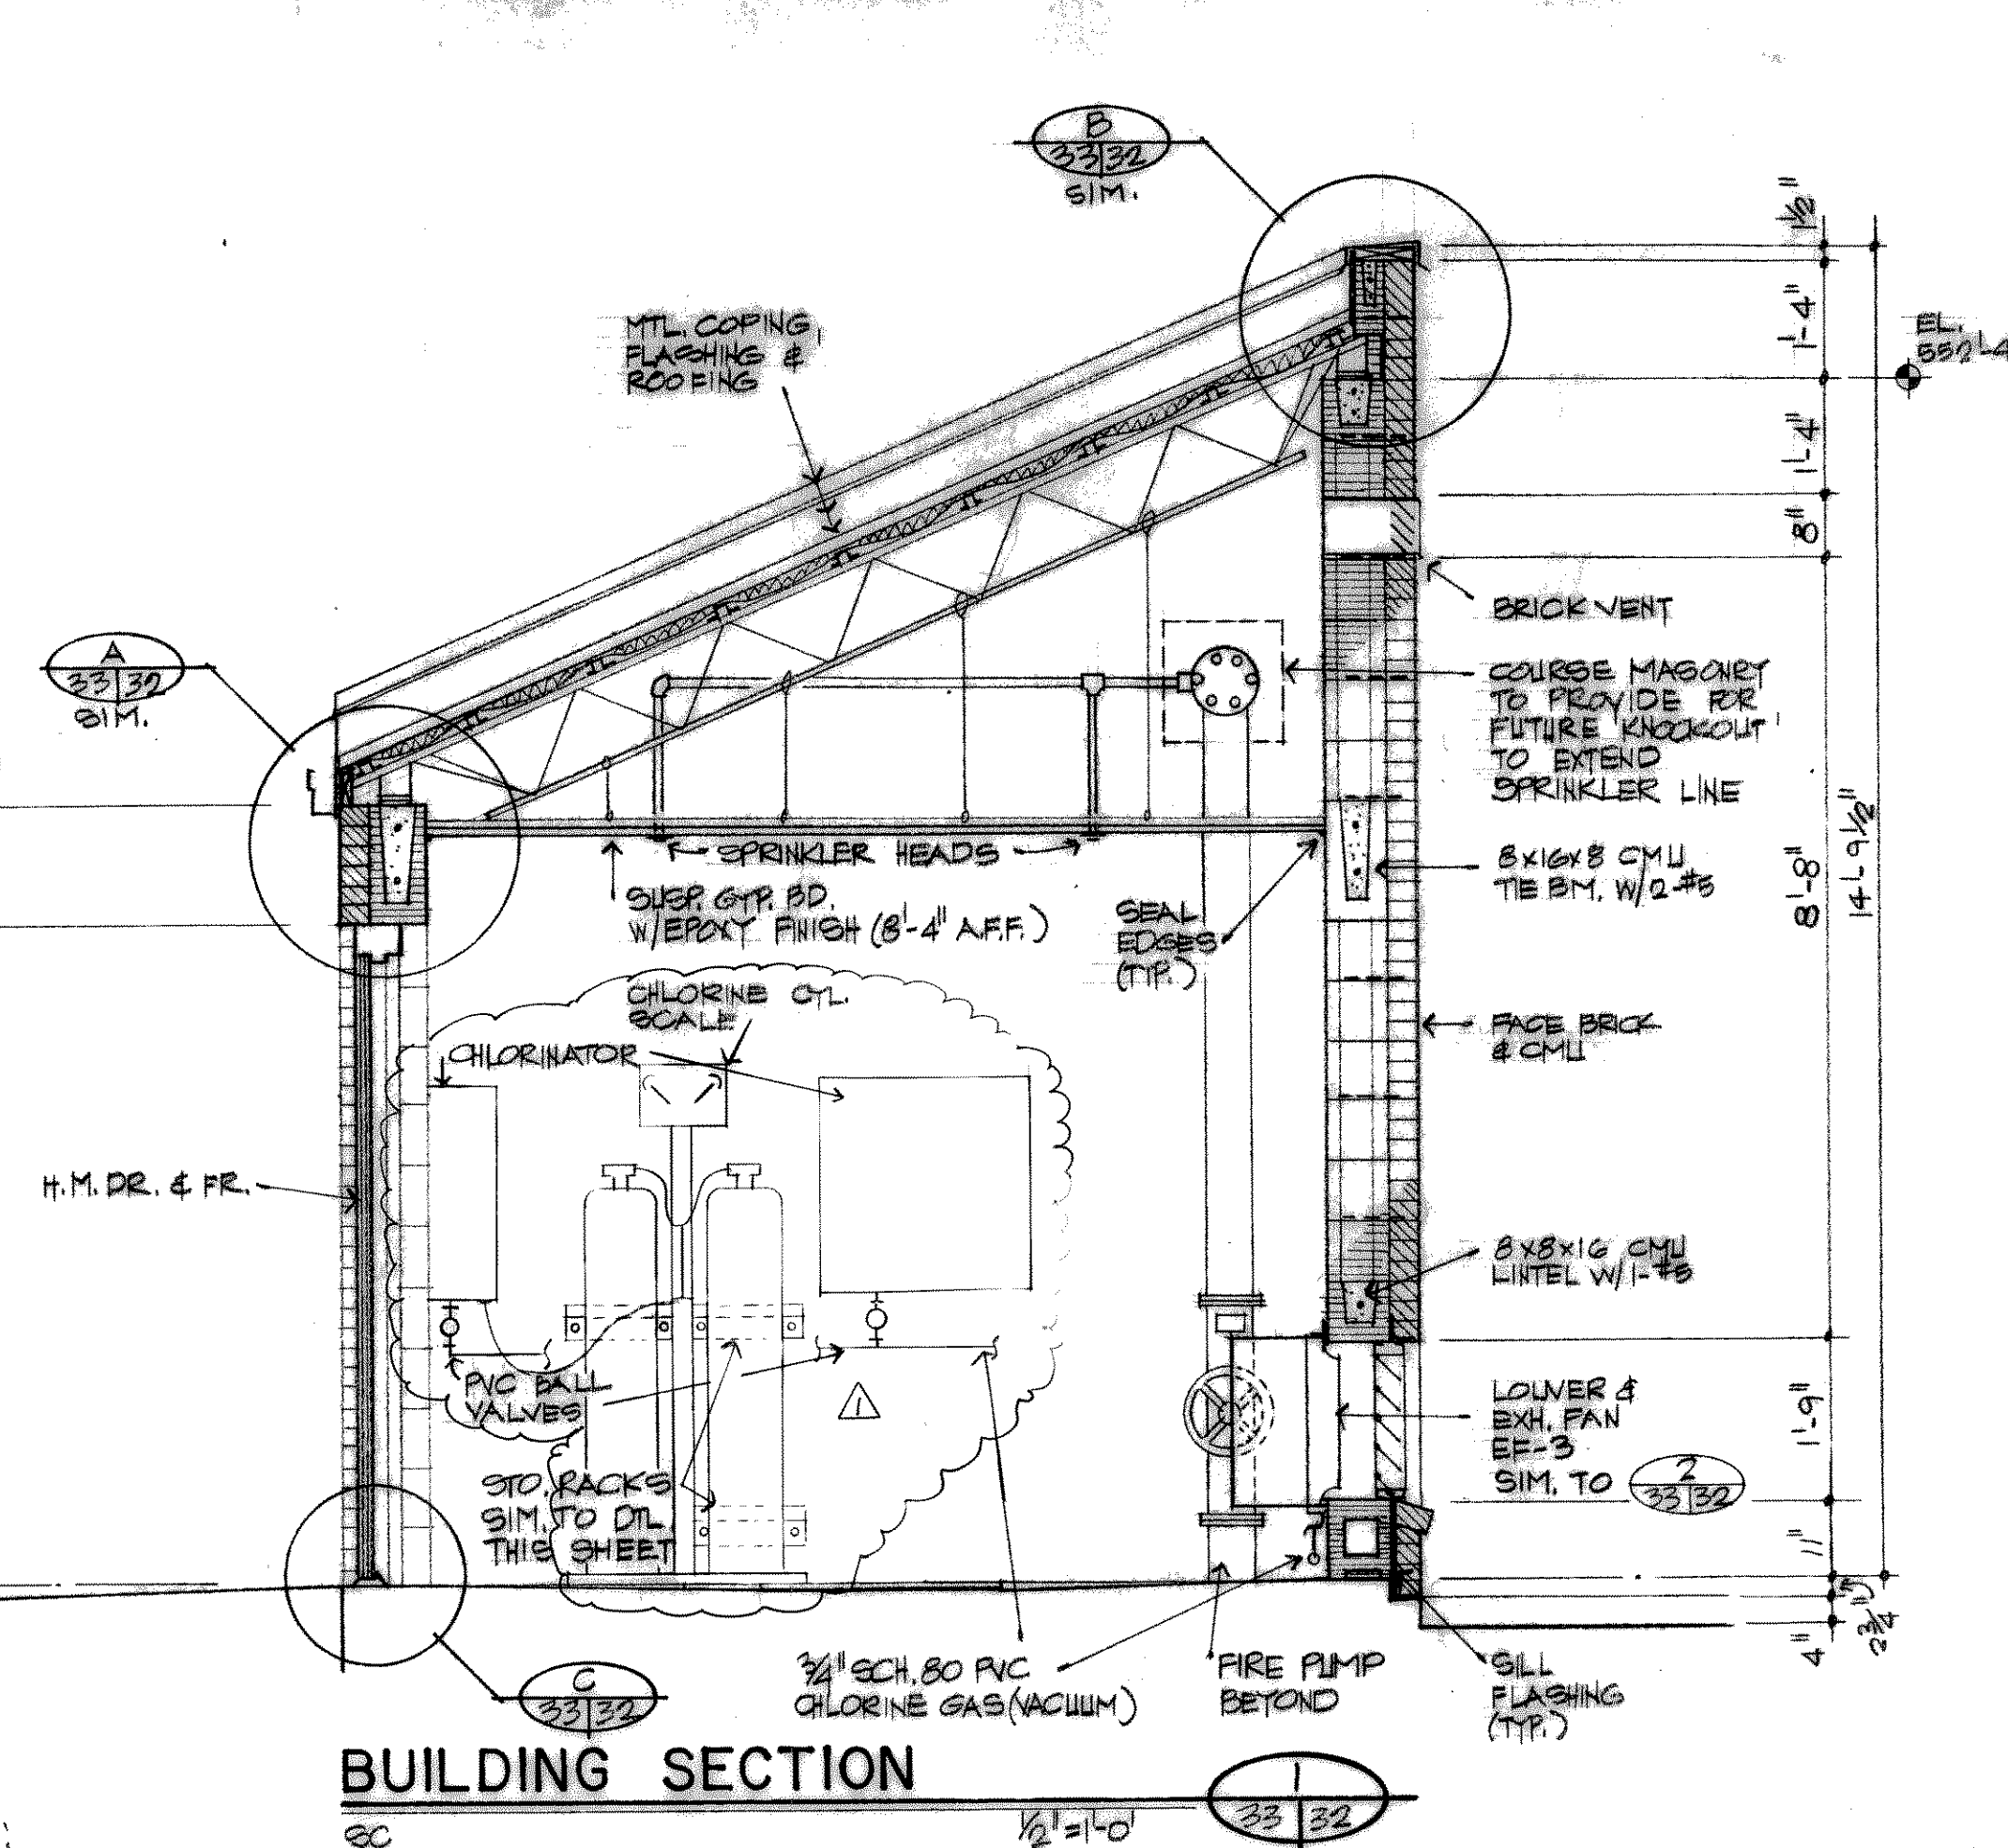


BUILDING SECTION
SC 1/2"=1'-0"

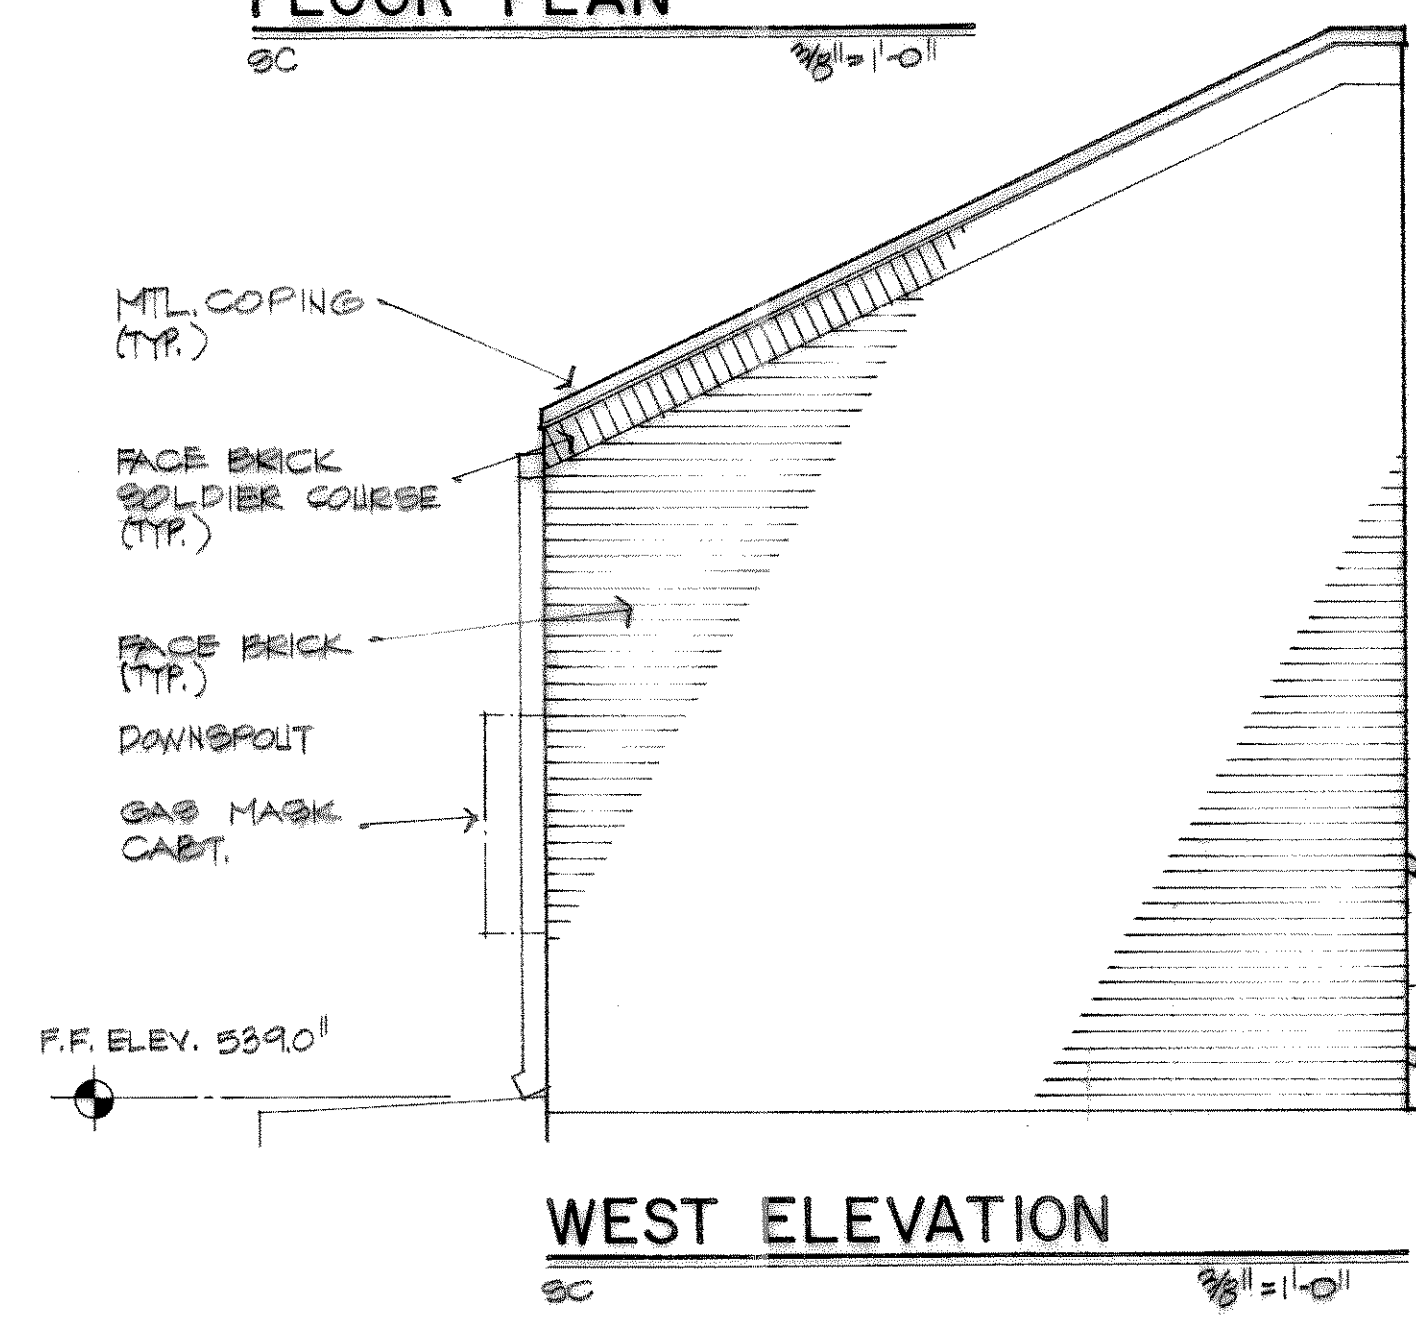


WEST ELEVATION
SC 3/8"=1'-0"

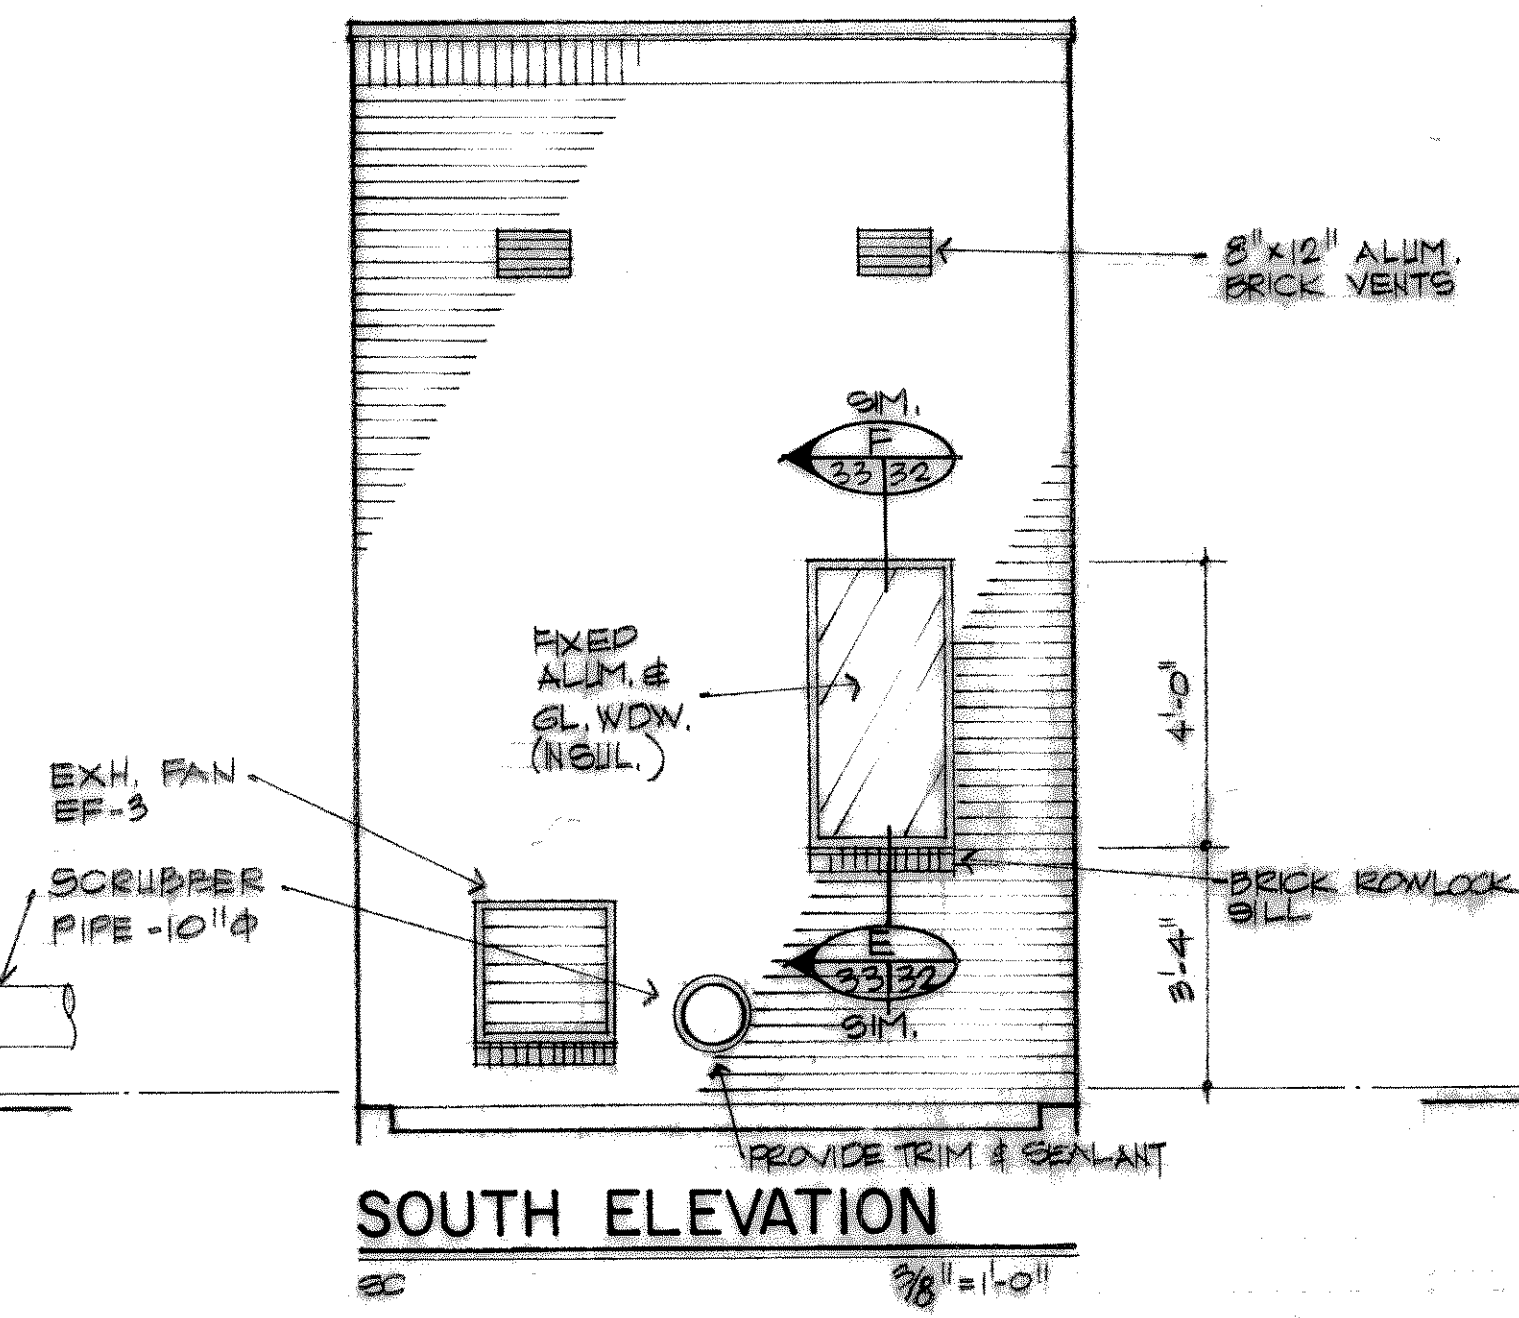

SOUTH ELEVATION
SC 3/8"=1'-0"

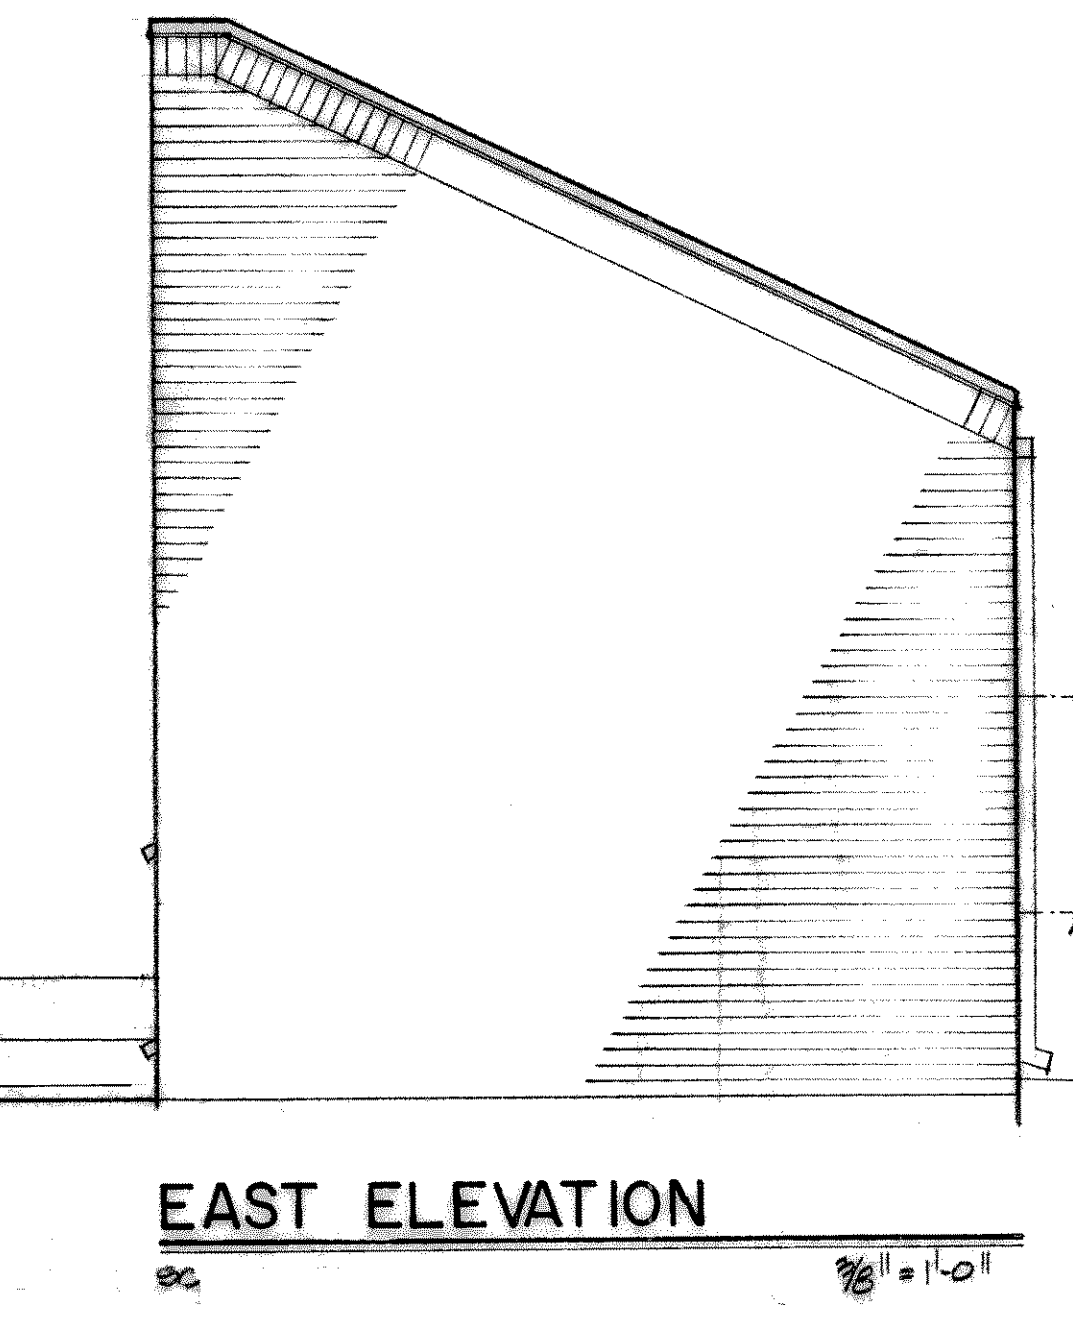

EAST ELEVATION
SC 3/8"=1'-0"

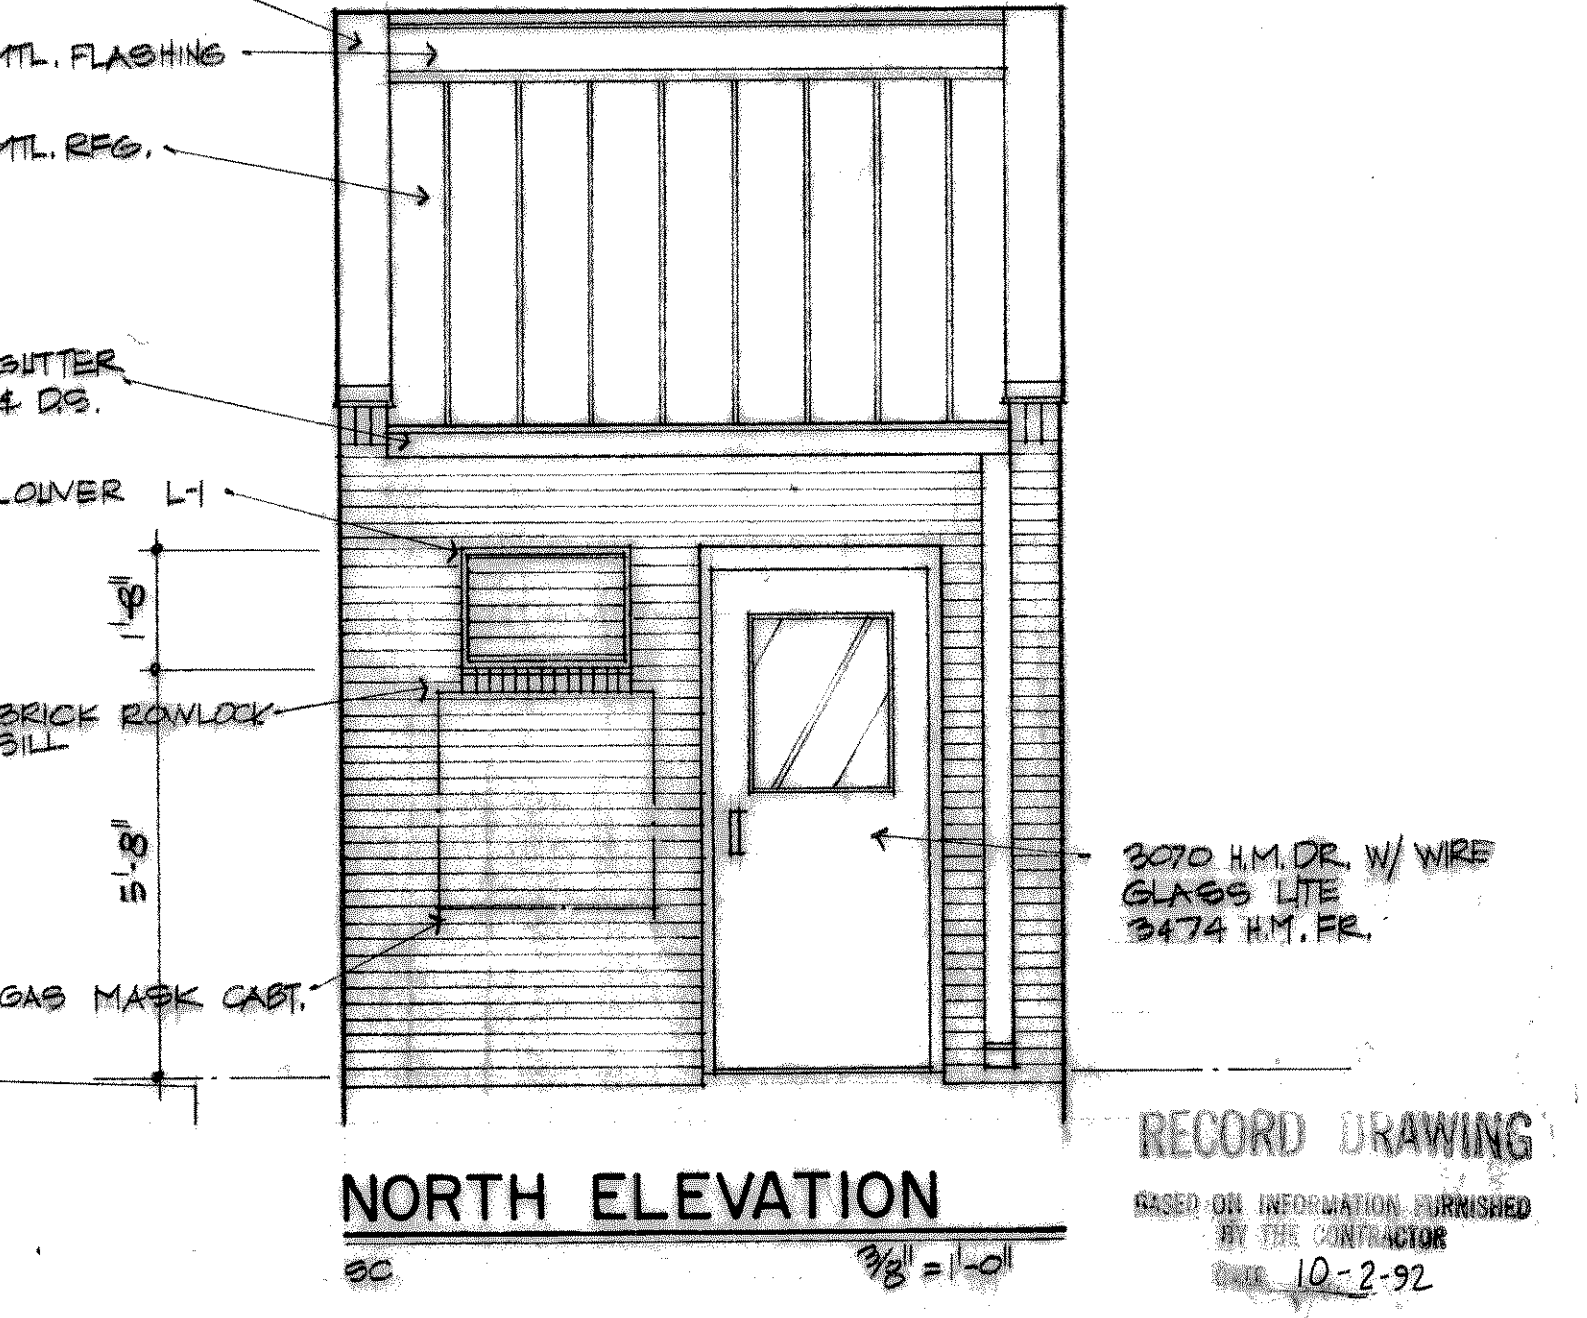

NORTH ELEVATION
SC 3/8"=1'-0"

RECORD DRAWING
BASED ON INFORMATION FURNISHED BY THE CONTRACTOR
DATE 10-2-92

