

CITY OF ROCKWALL, TEXAS

CONSTRUCTION PLANS FOR

EASTSIDE PUMP STATION REPLACEMENT OF PUMPS 1 AND 2

(ADDITIVE ALTERNATE: INSTALL PUMP NO. 4)

INCLUDED IN
THIS PROJECT

CONTRACTOR: TRIPLE D, INC.
P.O. BOX 1149
KELLER, TX. 76244

PROJECT SUPERINTENDENT: BOB SKINNER

CITY INSPECTOR: MIKE WHISENHUNT

CONTRACT COMPLETION DATE: NOV. 23, 1999

ORIGINAL CONTRCT AMOUNT: \$374,000

FINAL CONTRCT AMOUNT: \$357,909

COUNCIL MEMBERS

- GEORGE HATFIELD, MAYOR
- NELL WELBORN, MAYOR PRO-TEM
- BILLY MORRIS
- SCOTT SELF
- SAM BUFFINGTON
- RON COLESON
- DALE MORGAN

CITY MANAGER

JULIE COUCH

ASSISTANT CITY MANAGER

RICHARD R. CROWLEY

CITY ENGINEER

CHARLES A. TODD, P.E.


This record drawing is a compilation of the sealed engineering drawing for this project; modified by addenda, change orders and information furnished by the contractor. The information shown on the record drawings that was provided by the contractor or others not associated with the design engineer cannot be verified for accuracy or completeness. This original sealed drawings are on file at the offices of Birkhoff, Hendricks & Conway, L.L.P.

BY G.C.H. DATE 05/06/09



SHIMEK, JACOBS & FINKLEA, L.L.P.
CONSULTING ENGINEERS
Dallas, Texas

APRIL 1999

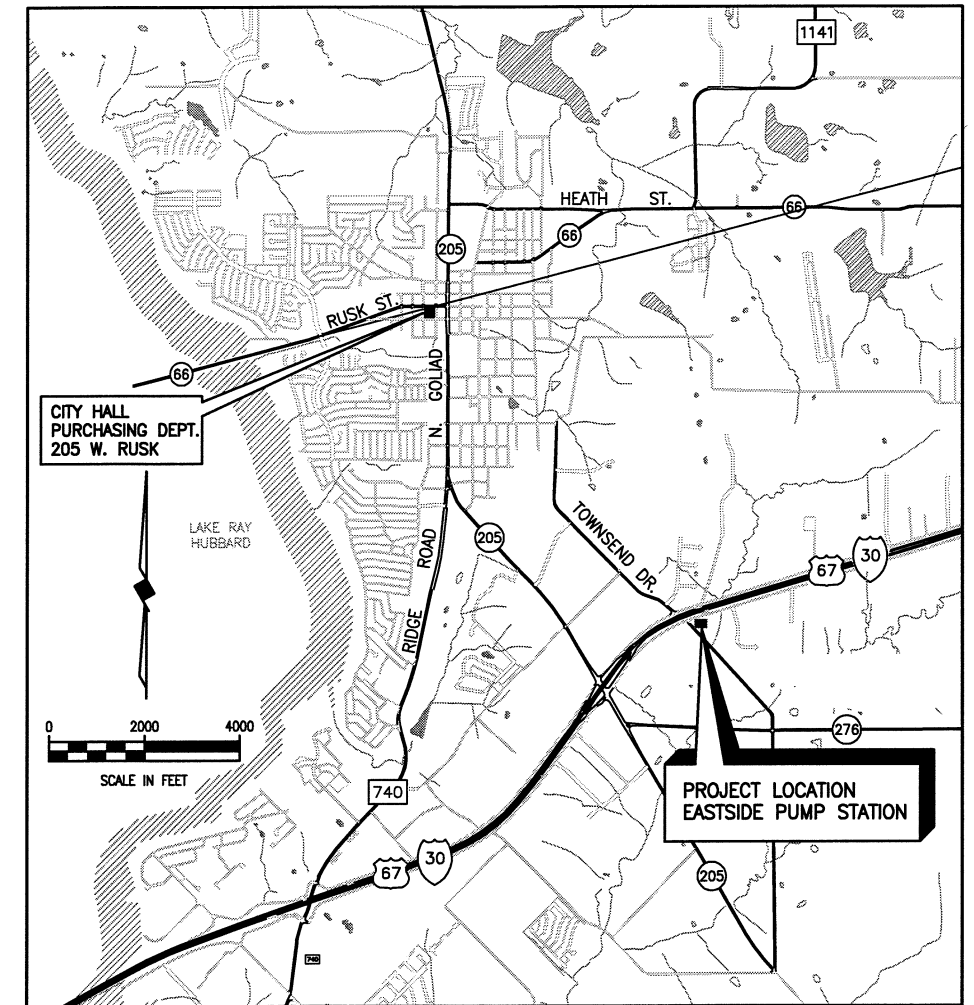

LOCATION MAP

SHEET INDEX

<u>SHEET NO.</u>	<u>SHEET DESCRIPTION</u>
-	COVER SHEET, LOCATION MAP AND INDEX
1	EXISTING SITE PLAN
1A	ADDENDUM NO. 1
1B	PUMP 1, 2 & 4 - PUMP MOTOR SHOP DRAWING DATA
1C	CHANGE ORDERS & FINAL PAY REQUEST
2	EXISTING PUMP STATION ROOF PLAN
3	EXISTING PIPING LAYOUT (BELOW GRADE)
4	EXISTING PUMP 1 AND 2 - SECTIONS
5	EXISTING PUMP 4 - SECTION PROPOSED PUMP 1, 2 & ALTERNATE 4 - SECTION
6	PROPOSED PUMP 1, 2 & ALTERNATE 4 - PLAN
7	E1 ONE LINE DIAGRAMS
8	E2 ELECTRICAL SITE PLAN
8A	ADDENDUM NO. 1, AIR CONDITIONER UNIT
9	E3 ELECTRICAL SECTIONAL PLAN
10	E4 SCHEMATICS
11-12	E5 & E6 ELECTRICAL DETAILS 7(E1)



G.C.H.
04/08/1999