
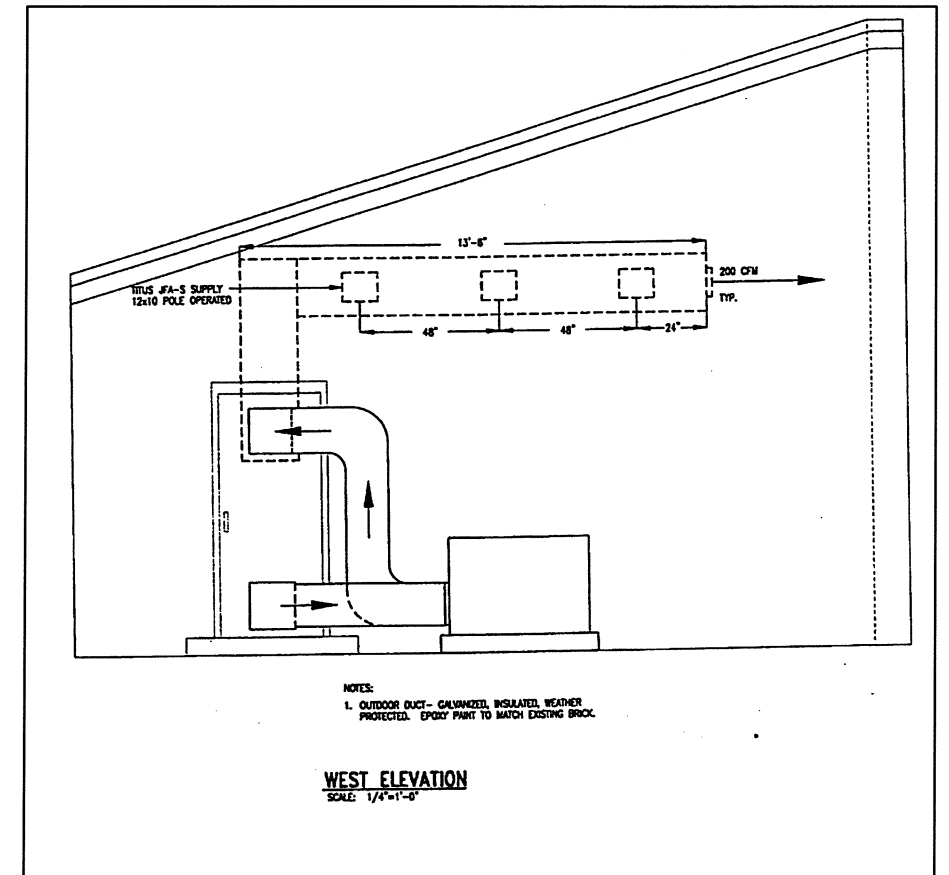
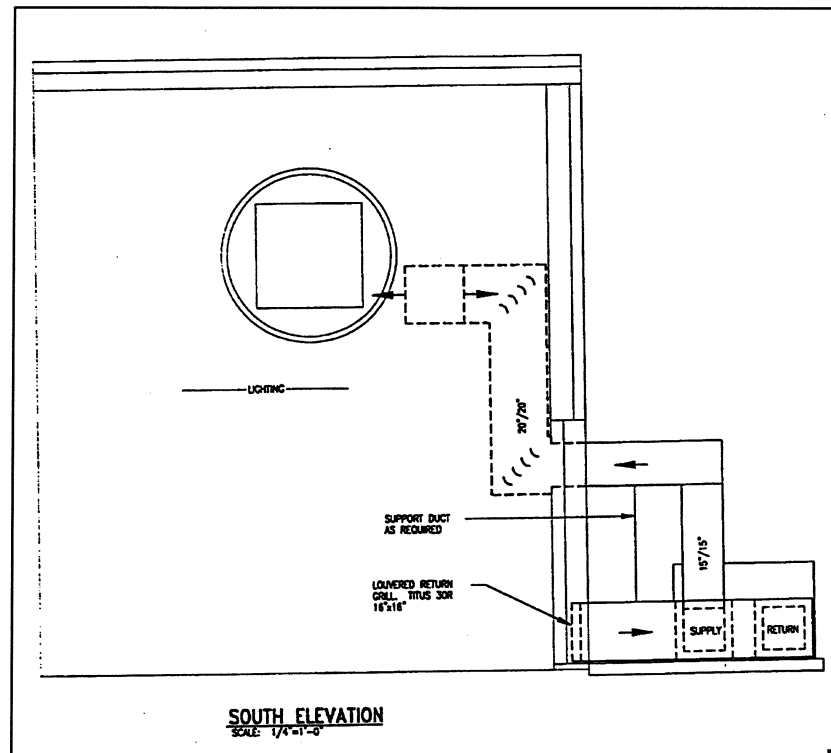


4/08/99 .LY H:\PROJECTS\ROCKWALL\98192\SHEETS\98192-05.DWG

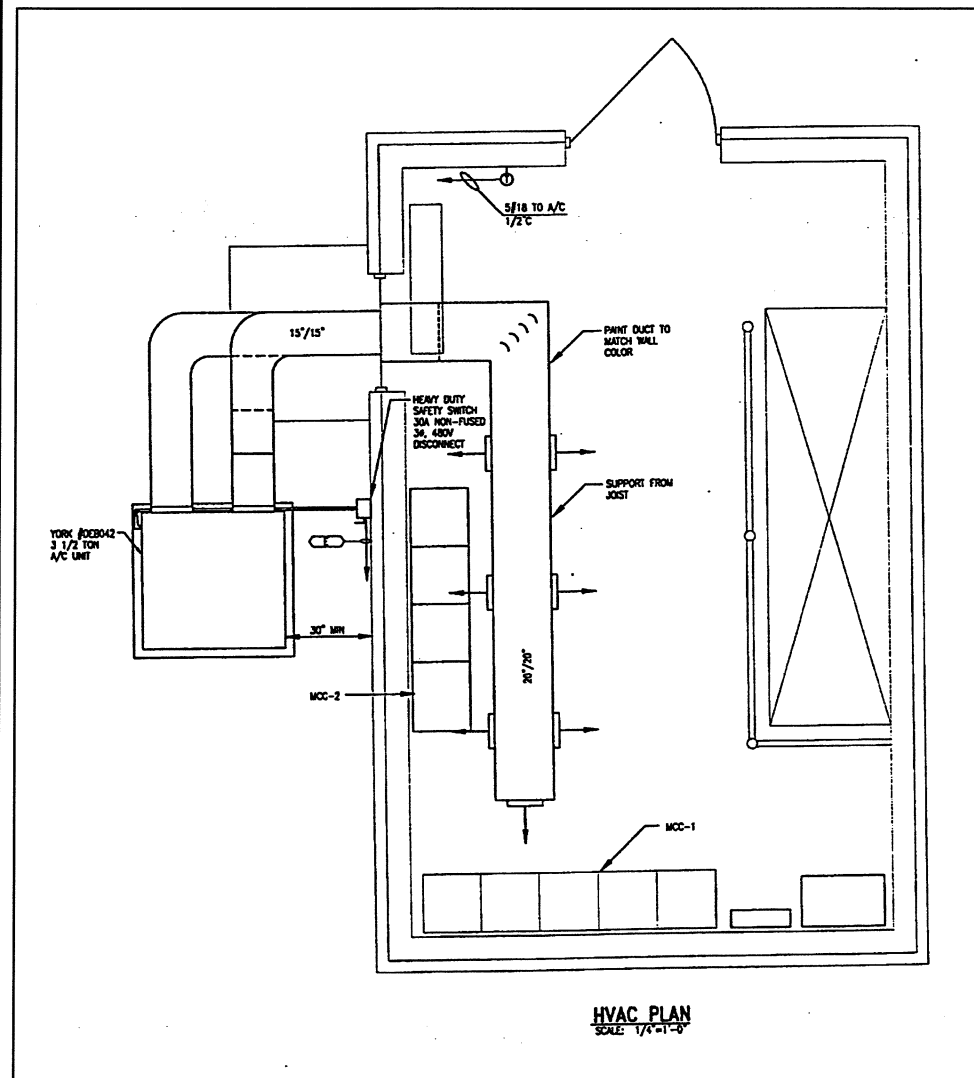


This record drawing is a compilation of the sealed
 engineering drawing for this project, modified by addenda,
 change orders and information furnished by the contractor.
 The information shown on the record drawings that was
 provided by the contractor or others not associated with the
 design engineer cannot be verified for accuracy or
 completeness. This original sealed drawings are on file at the
 offices of Birkhoff, Hendricks & Conway, L.L.P.

BY G.C.H. DATE 05/06/09

These plans and related specifications
 were prepared for construction of this
 specific project only. Reuse of these
 documents is not permitted without
 written authorization of Shimek, Jacobs
 & Finklea.

John A. Fry
 4-8-99

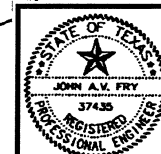

CITY OF ROCKWALL, TEXAS		
EASTSIDE PUMP STATION AIRCONDITIONING UNIT REVISIONS		
SHIMEK, JACOBS & FINKLEA, L.L.P. CONSULTING ENGINEERS Dallas, Texas		
DESIGNED BY: J. A. FRY	PROJECT: 98 192	SHEET NO. 8A
DRAWN BY: R. E. BRADY	DATE: APRIL 1999	OF 12 SHEETS