

CITY OF ROCKWALL

" THE NEW HORIZON "

EMMA JANE & DAVY CROCKETT

FROM S. GOLIAD STREET TO BOURN STREET

PAVING, STORMWATER, WATER & WASTEWATER IMPROVEMENTS

MAYOR

George Hatfield

CITY COUNCIL

Dale Morgan


Scott Self

Billy Morris

Sam Buffington

Ron Coleson

Nell Welborn

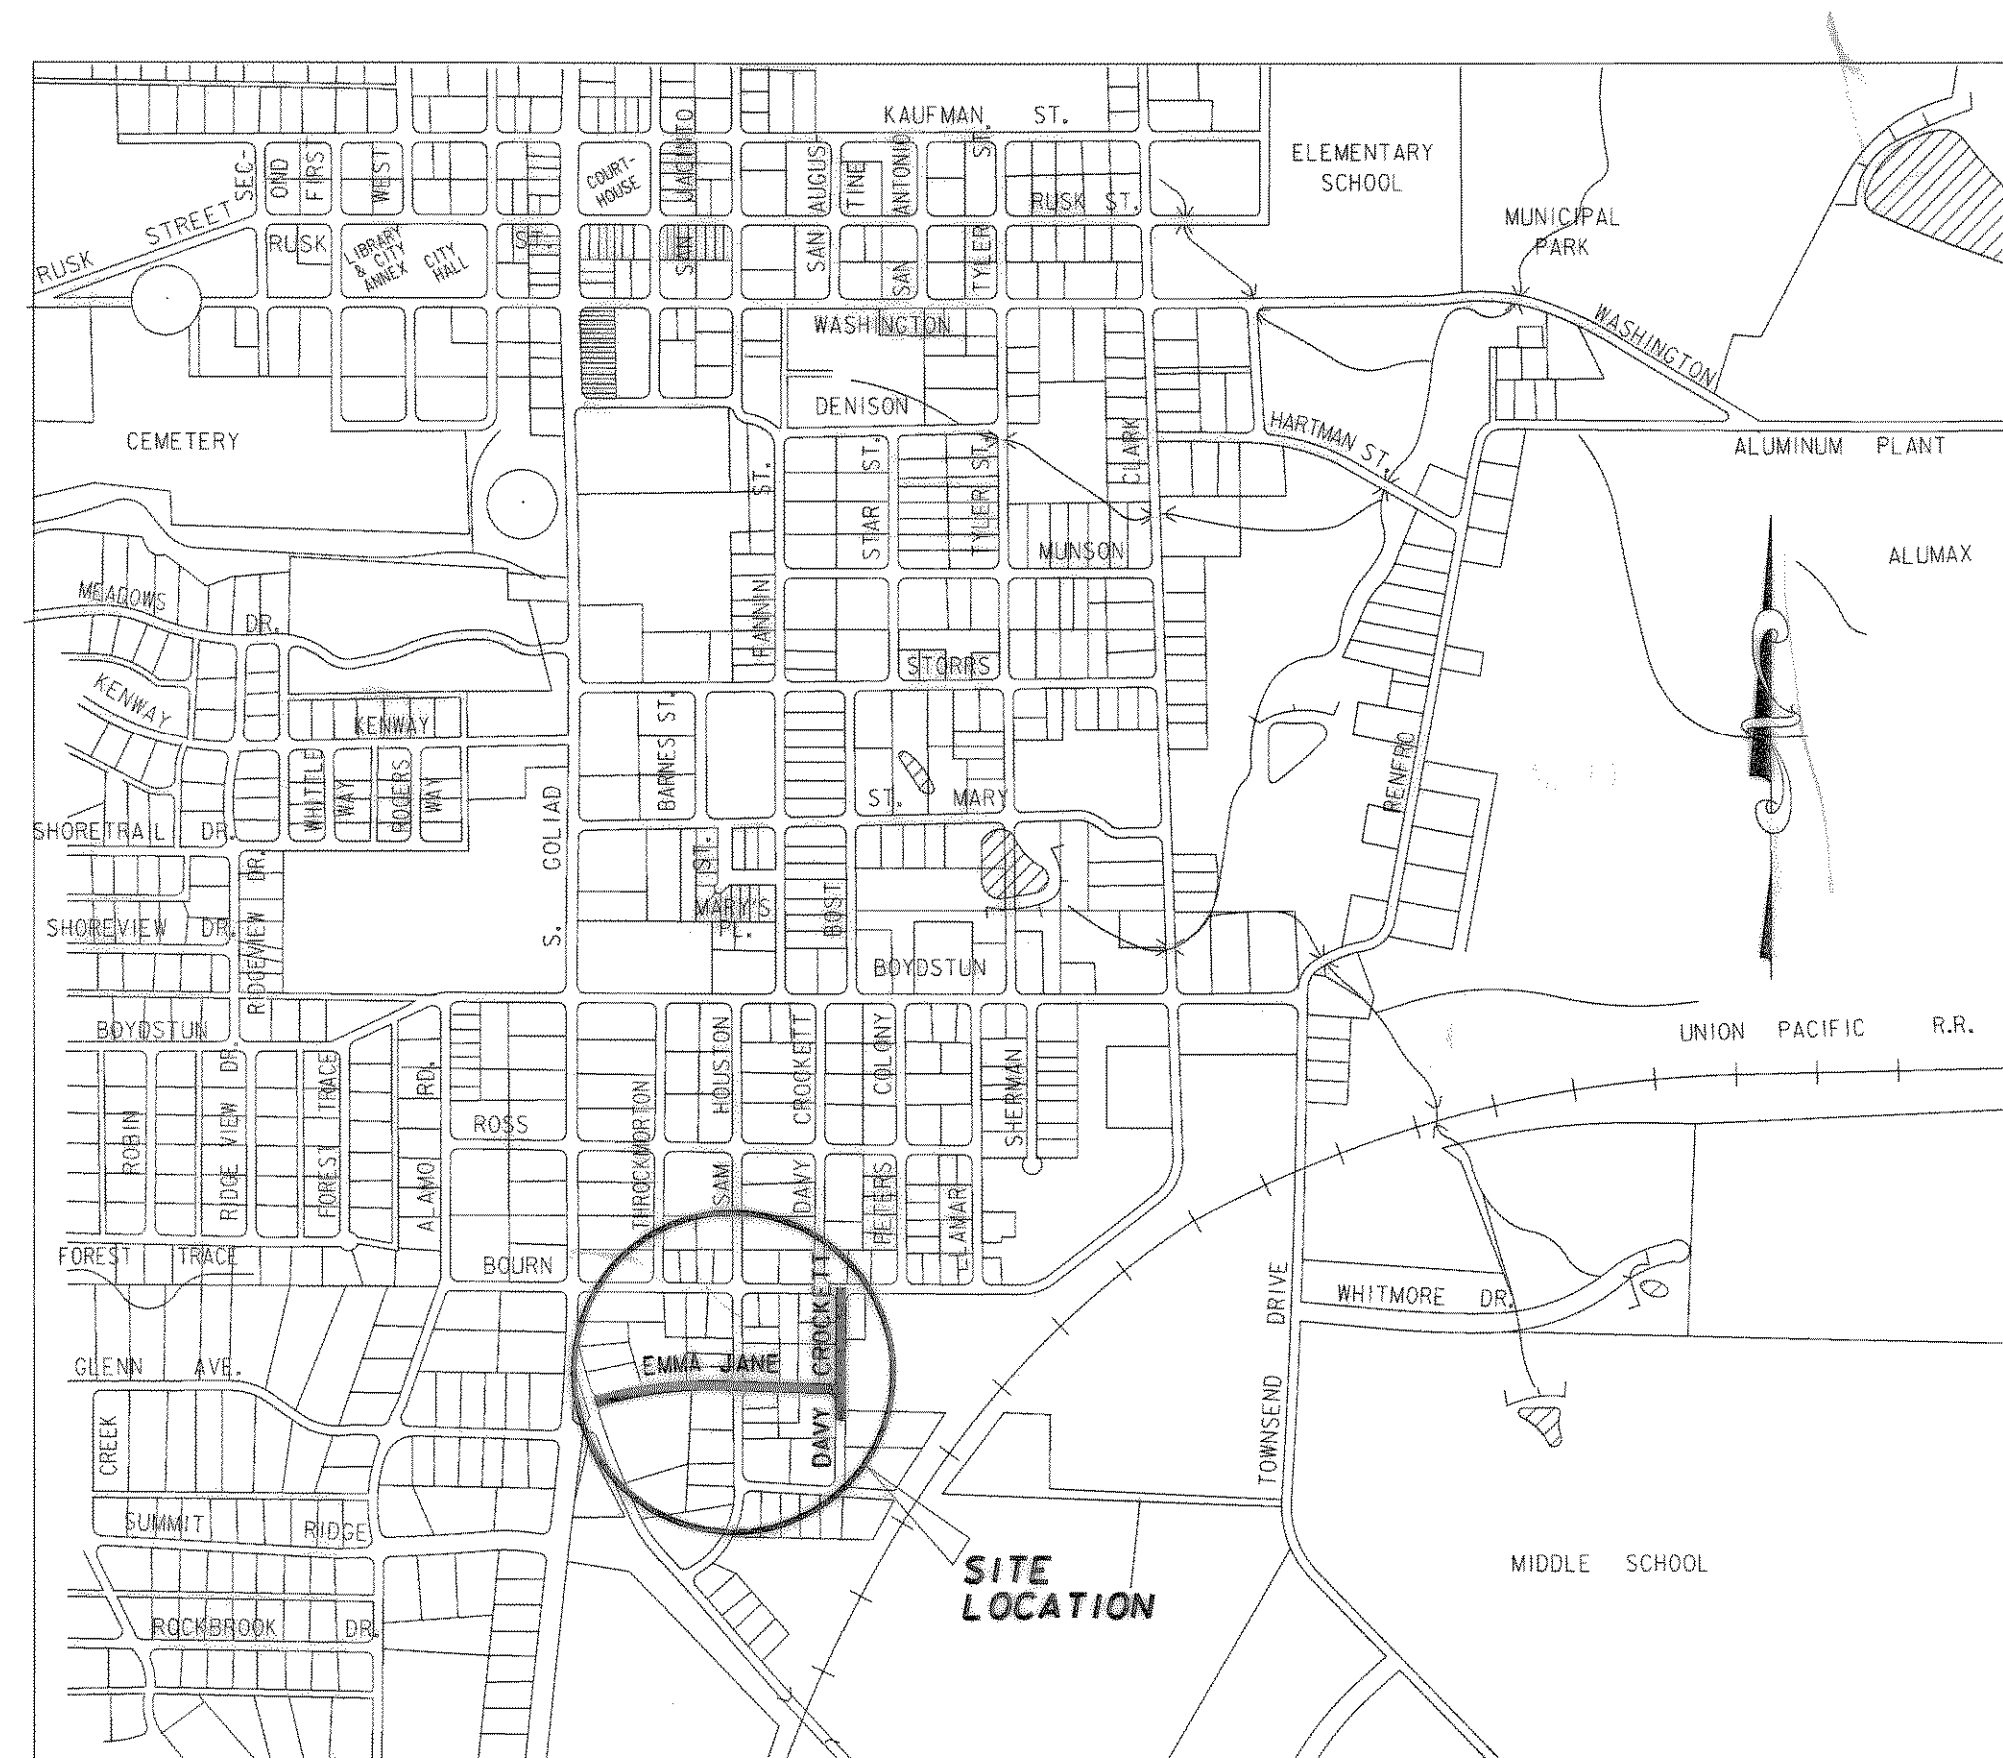

INDEX OF DRAWINGS

SHEET NO.	TITLE
C-1	COVER SHEET
Q-1	QUANTITY SHEET
P-1 to P-3	PAVING PLAN & PROFILE
ST-1	DRAINAGE AREA MAP
ST-2	STORMWATER CALCULATIONS
ST-3 to ST-4	STORMWATER PLAN & PROFILE
ST-5 to ST-6	POLLUTION CONTROL PLAN & DETAILS
U-1	WATER PLAN
U-2	WASTEWATER PLAN
U-3	WASTEWATER PROFILE
X-1 to X-5	CROSS-SECTIONS
D-1 to D-6	CITY OF ROCKWALL STANDARD DETAILS

THE STANDARD DETAILS ATTACHED TO THESE CONSTRUCTION DRAWINGS HAVE BEEN DESIGNATED BY THE ENGINEER AS APPLICABLE TO THIS PROJECT.
KENNETH A. ROBERTS, P.E. REG. NO. 55446
DATE: MAY 4, 1998



RECORD DRAWINGS FEBRUARY 5, 1999
THIS RECORD DOCUMENT HAS BEEN PREPARED BASED IN PART UPON INFORMATION FURNISHED BY OTHERS. THE DESIGN PROFESSIONAL CANNOT ASSURE THE ACCURACY OF OTHERS' INFORMATION AND THIS IS NOT RESPONSIBLE FOR THE ACCURACY OF THIS RECORD DOCUMENT OR FOR ANY ERROR OR OMISSION THAT MAY HAVE BEEN INCORPORATED INTO IT AS A RESULT. THOSE RELYING ON THIS RECORD DOCUMENT ARE ADVISED TO OBTAIN INDEPENDENT VERIFICATION OF ITS ACCURACY BEFORE APPLYING IT FOR ANY PURPOSE.


OWNER:

CITY OF ROCKWALL
ENGINEERING DEPARTMENT
205 WEST RUSK
ROCKWALL, TEXAS 75087
(972) 771-7700


ENGINEER:

HUITT-ZOLLARS, INC.
3131 MCKINNEY AVE., SUITE 600
DALLAS, TEXAS 75204
(214) 871-3311

THE SEAL APPEARING ON THIS DOCUMENT WAS AUTHORIZED BY KENNETH A. ROBERTS, P.E. 55446 ON MAY 7, 1998

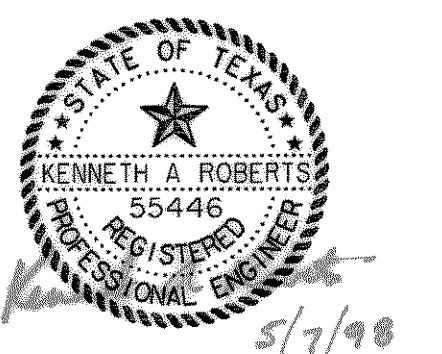

NOTE: INFORMATION ON UNDERGROUND FRANCHISED UTILITIES, BOTH EXISTING & PROPOSED, WAS NOT RECEIVED PRIOR TO ISSUING THESE PLANS FOR BID. CONTRACTOR TO VERIFY IN THE FIELD THE LOCATION OF ALL EXISTING UTILITIES PRIOR TO CONSTRUCTION. INFORMATION PROVIDED WITHIN THESE PLANS DOES NOT RELIEVE THE CONTRACTOR OF THE FULL AND TOTAL RESPONSIBILITY FOR THE PROTECTION OF EXISTING UTILITIES NOR ANY DAMAGES CAUSED BY SAID CONTRACTOR DURING CONSTRUCTION.

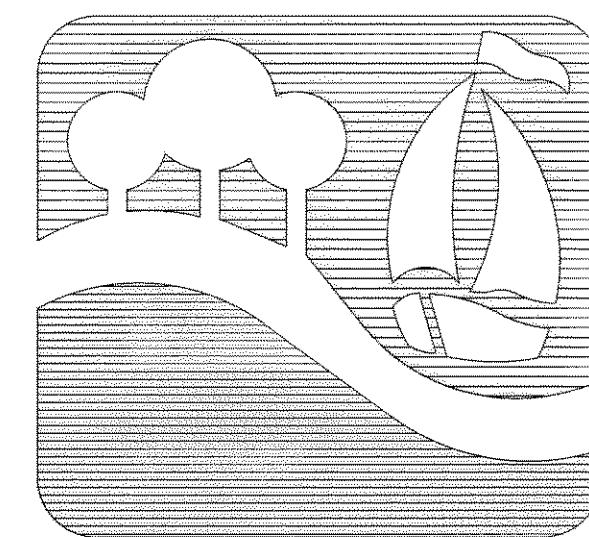

ROCKWALL, TEXAS