


# QUANTITY SUMMARY SHEET

ITEM NO	DESCRIPTION	UNIT	SHEET SUMMARY													ITEM NO	TOTAL QUANTITY	
			EMMA JANE P-1	EMMA JANE P-2	DAVY CROCKETT P-3	LINE 'B' ST-3	LATERALS ST-4	WATER U-1	WASTEWATER U-2									
1	BARRICADES & TRAFFIC CONTROL	MONTH	2	2	2												1	6
2	PREPARING RIGHT-OF-WAY	STA	4.65	4.70	4.15												2	13.5
3	UNCLASSIFIED STREET EXCAVATION	CY	935	699	580												3	2,214
4	REMOVE EX. CONCRETE PAVEMENT	SY	157	77	428	18											4	680
5	REMOVE EX. CONCRETE SIDEWALK	SF	56	135	96												5	287
6	6" 3500 PSI REINF. CONC. PAVEMENT	SY	1,352	1,476	1,706	19											6	4,553
7	6" INTEGRAL CONCRETE CURB	LF	554	693	597												7	1,844
8	REINF. CONC. STREET HEADER	LF	29	58	29												8	116
9	REINF. CONC. COMB. WALK / RET. WALL	CY			2												9	2
10	6" LIME STABILIZED SUBGRADE	SY	1,491	1,795	1,885	107											10	5,278
11	HYDRATED LIME (30 LBS./SY)	TON	22.3	27.0	28.3	1.6											11	79.2
12	4" 3000 PSI REINF. CONC. SIDEWALK	SF	1,966	3,253	2,601												12	7,820
13	REINF. CONCRETE SIDEWALK CURB	LF			75												13	75
14	REINF. CONC. SEPARATE CURB & GUTTER	LF	33		100												14	133
15	6" THICK FLEX BASE TY. A, GR. 1, CL. 5	SY	232	176	117	12			43								15	580
16	4" THICK HMAC, TY. B, TXDOT ITEM 340	SY	107	280	140	107			189								16	823
17	2" THICK HMAC, TY. D, TXDOT ITEM 340	SY	107	280	140	107			189								17	823
18	6" THICK HMAC FOR DETOURS	SY	350	350	300												18	1,000
19	6" THICK TOPSOIL	CY	64	94	113	19											19	290
20	SOLID SOD GRASS	SY	384	565	680	180											20	1,809
21	RELOCATE MAILBOX	EA		2	3	2											21	7
22	RELOCATE GAS LAMP	EA		1													22	1
23	4' TALL GALV. CHAIN LINK FENCE	LF		50	20												23	70
24	6' TALL GALV. CHAIN LINK FENCE	LF	47														24	47
25	6' TALL 20' WIDE GALV. CHAIN LINK GATE	EA	1														25	1
26	BOARD FENCE	LF		45													26	45
27	18" CLASS III RCP	LF				58	27										27	85
28	21" CLASS III RCP	LF				166	75										28	241
29	15" HDPE PIPE	LF				60											29	60
30	FLARED END SECTION	EA				6											30	6
31	5' STANDARD INLET	EA					2										31	2
32	10' STANDARD INLET	EA					2										32	2
33	4' 'Y' INLET	EA				1											33	1
34	TYPE 'P' SAFETY END TREATMENT	EA				1											34	1
35	REMOVE INLET	EA				2											35	2
36	REMOVE PIPE	LF		42		90	13										36	145
37	TRENCH SAFETY - STORMWATER	LF				284	102										37	386
38	EROSION CONTROL	LS				1											38	1
39	6" P.V.C. WATER, CL B-1 EMBEDMENT	LF						150									39	150
40	8" P.V.C. WATER, CL B-1 EMBEDMENT	LF						1,412									40	1,412
41	6" GATE VALVE / BOX	EA						8									41	8
42	8" GATE VALVE / BOX	EA						5									42	5
43	8"x8" TAPPING SLEEVE & VALVE	EA						1									43	1
44	1" WTR SERVICE TAP/VALVE/BOX/LINE	EA						12									44	12
45	INSTALL METER & RECONNECT SERVICE	EA						9									45	9
46	FIRE HYDRANT ASSEMBLY	EA						4									46	4
47	CONNECT TO EXISTING WATER	EA						3									47	3
48	TRENCH SAFETY - WATER	LF						1,562									48	1,562
49	WATER TEST	LS						1									49	1
50	6" P.V.C. WASTEWATER	LF							1,097								50	1,097
51	6" P.V.C. WASTEWATER BY BORE	LF							50								51	50
52	4' DIA. MANHOLE	EA							5								52	5
53	CLEANOUT	EA							3								53	3
54	4" P.V.C. WASTEWATER SERVICE	EA							14								54	14
55	TRENCH SAFETY - WASTEWATER	LF							1,097								55	1,097
56	WASTEWATER TEST	LS							1								56	1
57	T.V. INSPECTION	LF							1,097								57	1,097

RECORD DRAWINGS FEBRUARY 5, 1999  
 THIS RECORD DOCUMENT HAS BEEN PREPARED BASED IN PART UPON INFORMATION FURNISHED BY OTHERS. THE DESIGN PROFESSIONAL CANNOT ASSURE THE ACCURACY OF OTHERS' INFORMATION AND THIS IS NOT RESPONSIBLE FOR THE ACCURACY OF THIS RECORD DOCUMENT OR FOR ANY ERROR OR OMISSION THAT MAY HAVE BEEN INCORPORATED INTO IT AS A RESULT. THOSE RELYING ON THIS RECORD DOCUMENT ARE ADVISED TO OBTAIN INDEPENDENT VERIFICATION OF ITS ACCURACY BEFORE APPLYING IT FOR ANY PURPOSE.

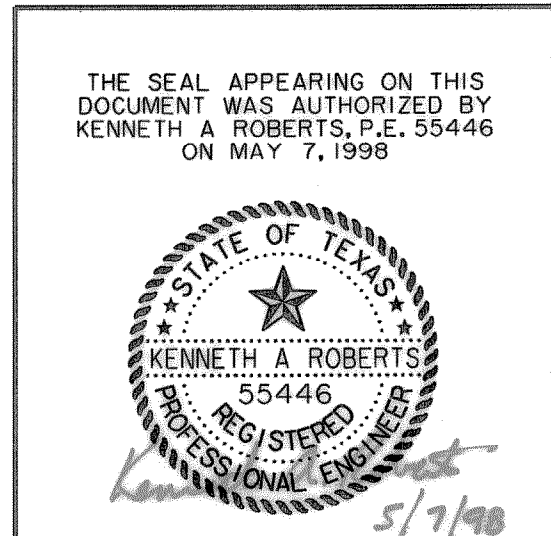

RECORD DRAWING  
2/5/99

<b>PAVING QUANTITIES</b>						
<b>EMMA JANE STREET</b>						
<b>DAVY CROCKETT</b>						
<b>CITY OF ROCKWALL, TEXAS</b>						
Huitt-Zollars, Inc./Consulting Engineers Dallas, Fort Worth, Houston, Phoenix, Tucson, El Paso, Ontario, Albuquerque						
DESIGN	DRAWN	APPR.	SCALE	DATE	PROJECT NO.	NO.
HZI	HZI	KAR	N.T.S.	MAY 98	01226201	Q-1