


EMMA JANE & DAVY CROCKETT
STORMWATER PIPE CALCULATIONS - DECEMBER 17, 1997

COLLECTION POINT UPSTREAM STATION	COLLECTION POINT DOWNSTREAM STATION	DISTANCE BETWEEN COLLECTION POINTS	AREA NO.	AREA A (ACRES)	INCREMENTAL RUNOFF COEFF. C	DRAINAGE A INCREM. CA	ACCUM. CA	TIME @ UPSTREAM STATION (MIN.)	DESIGN STORM FREQUENCY (YEAR)	RAINFALL INTENSITY I (IN./HR)	STORM WATER RUNOFF Q (CFS)	SLOPE OF HYDRAULIC GRADIENT S (FT/FT)	PIPE SIZE (INCHES)	VELOCITY IN STORM SEWER V (FPS)	HEAD LOSS COEFF. K _j	HEAD LOSS AT UPSTREAM WYE STATION (FT)	FLOW TIME IN PIPE (MIN)	TIME @ DOWNSTREAM STATION (MIN)	DESIGN Q (CFS)	VELOCITY H _v (FT)	H.G. AT UPSTREAM STATION (FT)	H.G. AT DOWNSTREAM STATION (FT)	REMARKS
LINE "B" - EMMA JANE AT SAM HOUSTON																							
756.99	746.69	10.30	B-1	0.26	0.52	0.14	0.14	10.00	100	9.80	1.32	0.0002	18	0.75	1.25	0.01	0.23	10.23	1.32	0.01	567.96	567.96	
746.69	695.09	51.60				0.14	0.14	10.23	100	9.80	1.32	0.0002	18	0.75	0.35	0.01	1.15	11.38	1.32	0.01	567.95	567.95	
695.09	549.01	146.08	B-2&3	1.58	0.80	1.26	1.40	11.38	100	9.80	13.71	0.0075	21	5.70	0.60	0.50	0.43	11.81	13.71	0.50	567.45	566.35	LAT B-2 & 3
549.01	533.58	15.43				1.40	1.40	11.81	100	9.80	13.71	0.0075	21	5.70	0.35	0.33	0.05	11.85	13.71	0.50	566.03	565.91	
533.58	530.33	3.25				1.40	1.40	11.85	100	9.80	13.71	0.0075	21	5.70	0.75	0.13	0.01	11.86	13.71	0.50	565.77	565.75	
LAT "B-2"																							
43.00	10.71	32.29	B-2	1.32	0.82	1.08	1.08	10.00	100	9.80	10.61	0.0016	21	2.62	1.25	0.13	0.21	10.21	6.29	0.11	568.16	568.11	
10.71	0.00	10.71	B-3	0.26	0.68	0.18	1.26	10.21	100	9.80	12.34	0.0061	21	5.13	0.60	0.34	0.03	10.24	12.34	0.41	567.76	567.70	LAT B-3
LAT "B-3"																							
31.73	0.00	31.73	B-3	0.26	0.68	0.18	0.18	10.00	100	9.80	1.73	0.0015	21	2.52	1.25	0.12	0.21	10.21	6.05	0.10	568.21	568.16	
LINE "A" - EXISTING LINE IN BOURN STREET AT DAVY CROCKETT																							
LAT "A-1" - EXISTING LATERAL																							
45.84	0.00	45.84	A-1	0.07	0.50	0.04	0.04	10.00	100	9.80	0.34	0.0000	18	0.19	1.25	0.00	3.97	13.97	0.34	0.00	554.16	554.16	
LAT "A-2" - EXISTING LATERAL																							
56.06	0.00	56.06	A-2	0.61	0.50	0.31	0.31	10.00	100	9.80	2.99	0.0008	18	1.69	1.25	0.06	0.55	10.55	2.99	0.04	554.14	554.09	


EMMA JANE & DAVY CROCKETT
INLET CALCULATIONS - FEBRUARY 2, 1998

INLET TYPE & NO.	INLET LOCATION	DRAINAGE AREA NUMBER	PEAK FLOW FOR AREA "Q _{p-5"} (CFS)	CARRY-OVER FROM UPSTREAM AT INLET "Q _{co} " (CFS)	TOTAL FLOW "Q _{T-5"} (CFS)	STREET SECTION WIDTH & CROWN	STREET SLOPE "S _o " (FT/FT)	STREET CAPACITY ROW-ROW (CFS)	STREET CAPACITY CURB-CURB (CFS)	FLOW DEPTH "y" (FT)	WIDTH OF SPREAD "Sp" (FT)	CAP. PER FOOT OF INLET REQ. "Q" / FOR "Q _o " (CFS/FT)	LENGTH OF INLET REQ. "L" (FT.)	"L"/"L _o "	"Q"/"Q _o "	FLOW INTERCEPTED FROM FIGURE 3.5 "Q" = "Q _o " x ("Q"/"Q _o ") (CFS)	CARRY-OVER FLOW TO DOWNSTREAM "Q _{co} " (CFS)	
I STD.	DAVY CROCKETT	A-1	0.22	0.00	0.22	29'BB / 6"CR	0.0140	49.49	12.14	0.13	2.00	0.74	0.30	5	16.92	1.00	0.22	0.00
I STD.	DAVY CROCKETT	A-2	1.88	0.00	1.88	29'BB / 6"CR	0.0113	44.46	10.91	0.29	5.13	0.91	2.06	5	2.43	1.00	1.88	0.00
I DROP	SAM HOUSTON	B-1	0.83	0.00	0.83	29'BB / 6"CR	0.0050	29.58	7.26	0.29	5.15	0.91	0.91	12	13.19	1.00	0.83	0.00
I STD.	EMMA JANE	B-2	6.66	0.00	6.66	29'BB / 6"CR	0.0150	51.23	12.57	0.50	14.00	1.15	5.78	10	1.73	1.00	6.66	0.00
I STD.	EMMA JANE	B-3	1.09	0.00	1.09	29'BB / 6"CR	0.0150	51.23	12.57	0.25	4.20	0.87	1.25	10	7.97	1.00	1.09	0.00
NONE	DAVY CROCKETT	C-1	1.38	0.00	1.38	29'BB / 6"CR	0.0050	29.58	7.65	0.30	5.51	0.92	1.49	0	0.00	0.00	0.00	1.38
NONE	EMMA JANE	C-2	1.54	0.00	1.54	29'BB / 6"CR	0.0400	83.66	20.53	0.25	4.20	0.87	1.77	0	0.00	0.00	0.00	1.54
NONE	EMMA JANE	C-3	0.89	0.00	0.89	29'BB / 6"CR	0.0400	83.66	20.53	0.21	3.30	0.83	1.08	0	0.00	0.00	0.00	0.89
NONE	DAVY CROCKETT	C-4	1.17	3.81	4.98	29'BB / 6"CR	0.0050	29.58	7.26	0.50	14.00	1.15	4.32	0	0.00	0.00	0.00	4.98
NONE	DAVY CROCKETT	C-5	0.12	0.00	0.12	29'BB / 6"CR	0.0050	29.58	7.26	0.12	2.00	0.73	0.16	0	0.00	0.00	0.00	0.12
NONE	DAVY CROCKETT	C-6	0.25	0.12	0.37	29'BB / 6"CR	0.0050	29.58	7.26	0.21	3.30	0.83	0.45	0	0.00	0.00	0.00	0.37

INLET TYPE & NO.	INLET LOCATION	DRAINAGE AREA NUMBER	PEAK FLOW FOR AREA "Q _{p-100"} (CFS)	CARRY-OVER FROM UPSTREAM AT INLET "Q _{co} " (CFS)	TOTAL FLOW "Q _{T-100"} (CFS)	STREET SECTION WIDTH & CROWN	STREET SLOPE "S _o " (FT/FT)	STREET CAPACITY ROW-ROW (CFS)	STREET CAPACITY CURB-CURB (CFS)	FLOW DEPTH "y" (FT)	WIDTH OF SPREAD "Sp" (FT)	CAP. PER FOOT OF INLET REQ. "Q" / FOR "Q _o " (CFS/FT)	LENGTH OF INLET REQ. "L" (FT.)	"L"/"L _o "	"Q"/"Q _o "	FLOW INTERCEPTED FROM FIGURE 3.5 "Q" = "Q _o " x ("Q"/"Q _o ") (CFS)	CARRY-OVER FLOW TO DOWNSTREAM "Q _{co} " (CFS)	
I DROP	SAM HOUSTON	B-1	1.32	0.00	1.32	29'BB / 6"CR	0.0050	29.58	7.26	0.33	6.06	0.96	1.38	12	8.69	1.00	1.32	0.00
I STD.	EMMA JANE	B-2	10.61	0.00	10.61	29'BB / 6"CR	0.0150	51.23	12.57	0.50	14.00	1.15	9.21	10	1.09	1.00	6.29	4.32
I STD.	EMMA JANE	B-3	1.73	4.32	6.05	29'BB / 6"CR	0.0150	51.23	12.57	0.48	13.44	1.13	5.36	10	1.87	1.00	6.05	0.00

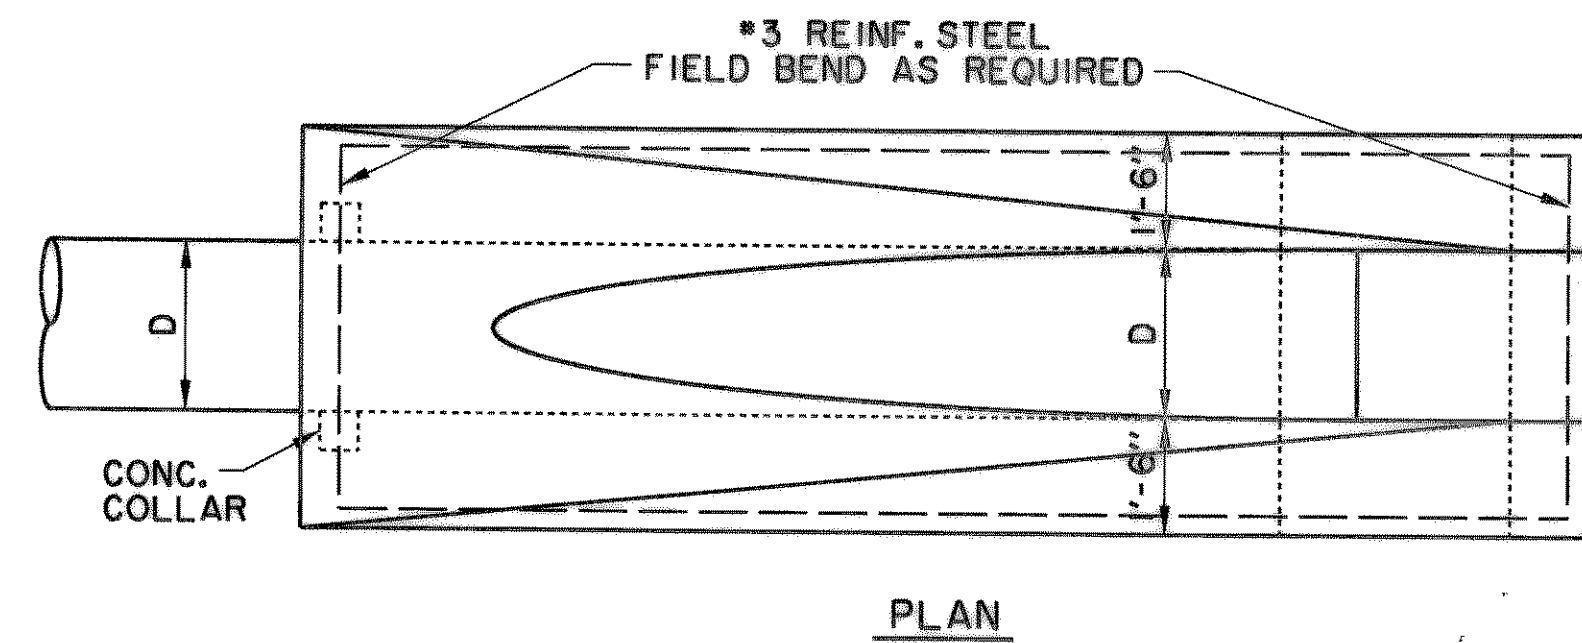


PLAN

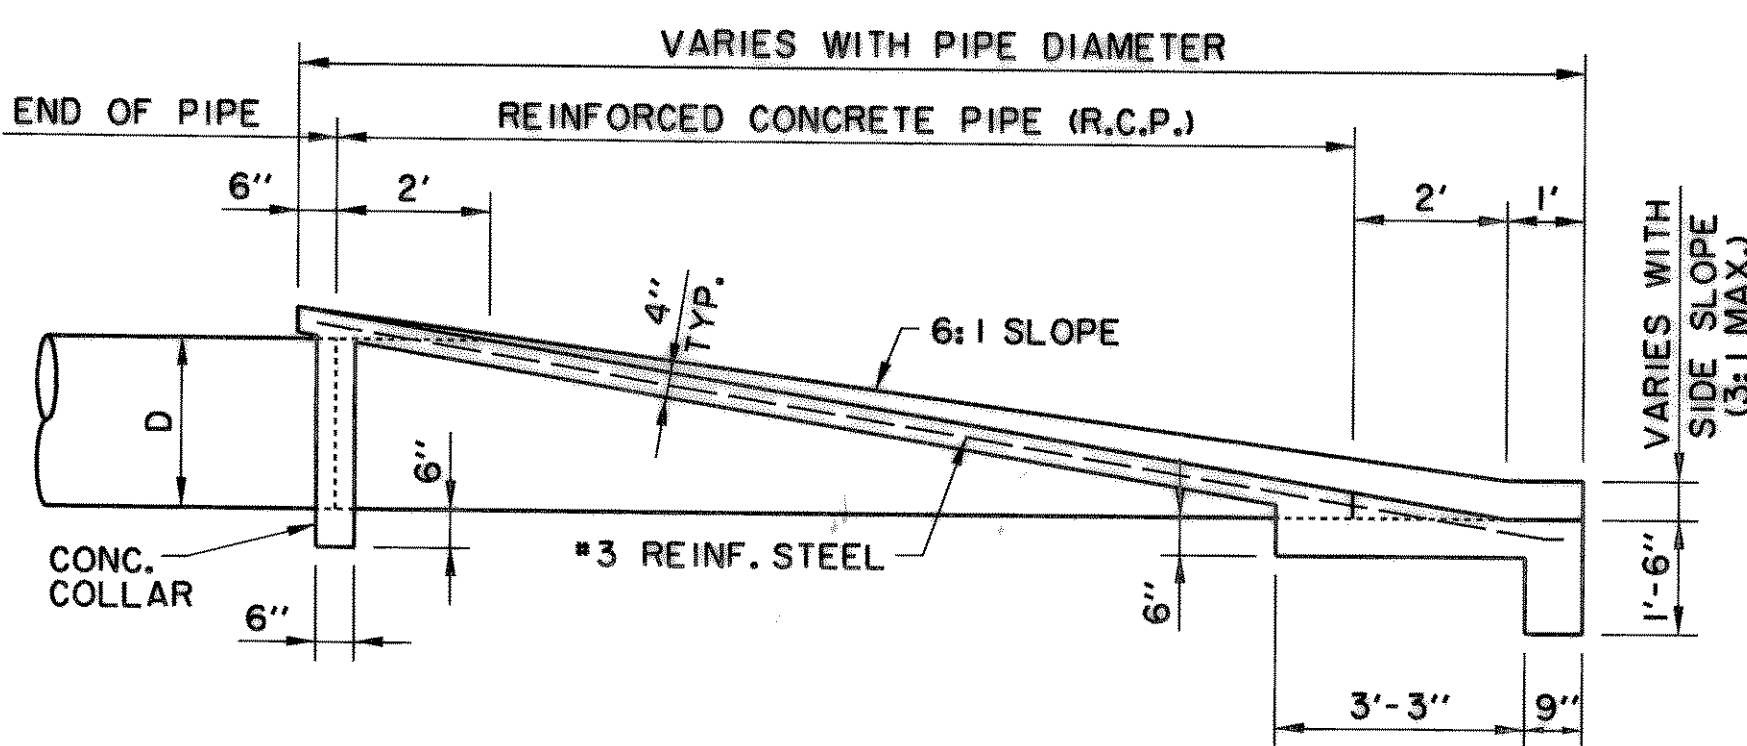


ELEVATION


SAFETY END TREATMENT TYPE P

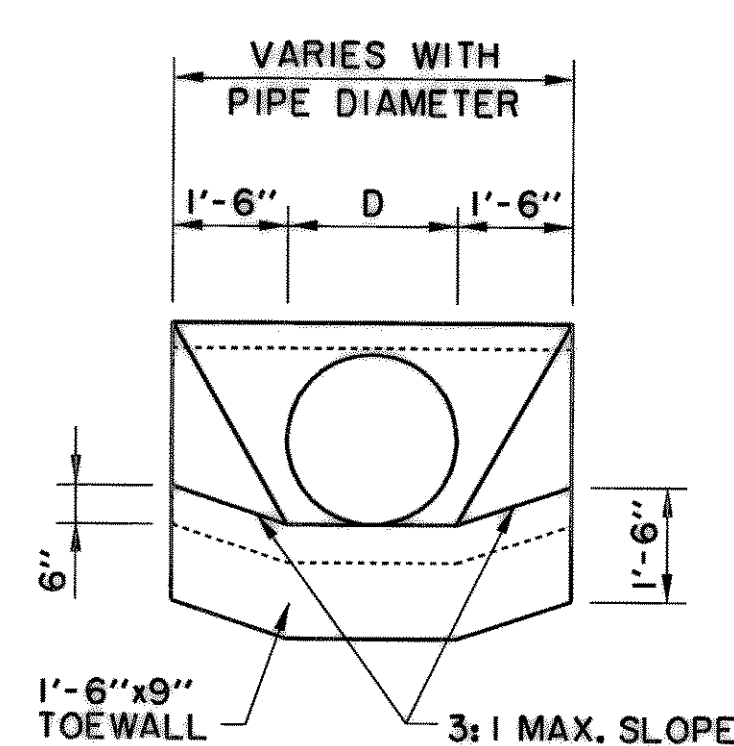

END ELEVATION

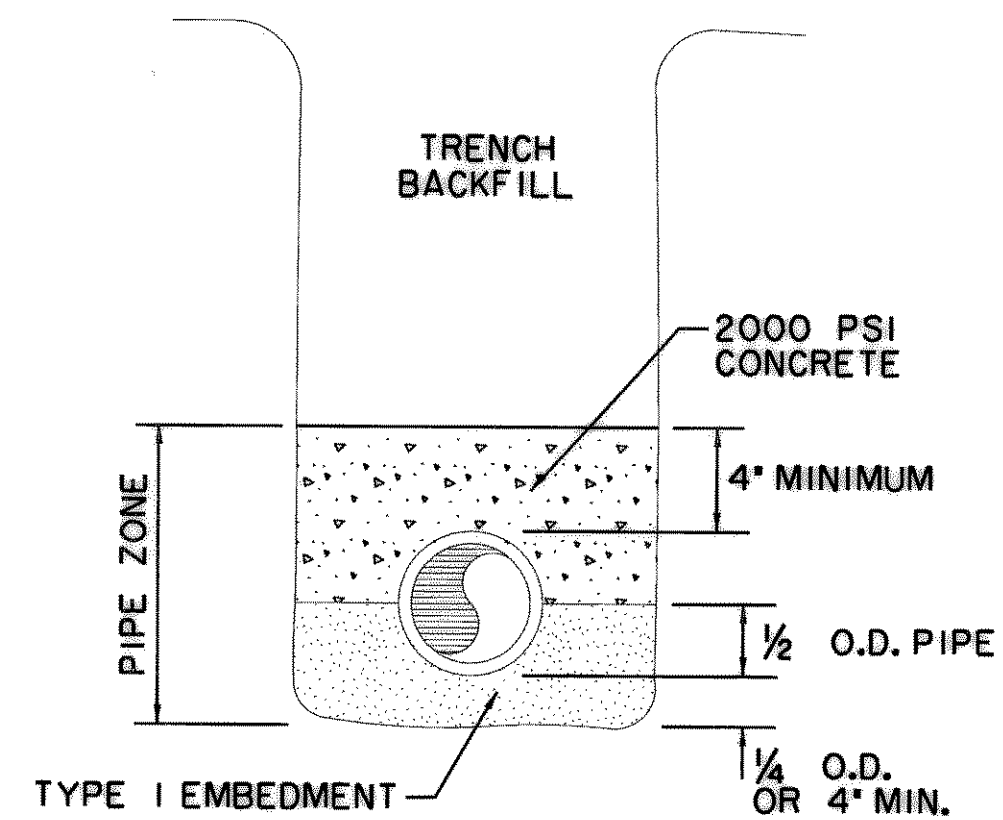

CONCRETE CAP EMBEDMENT DETAIL

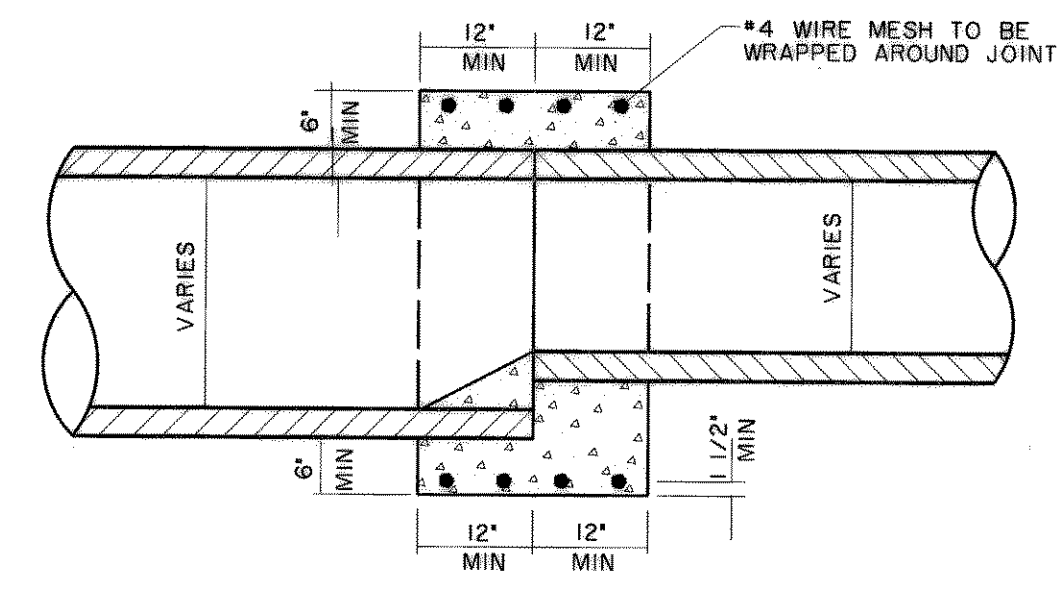

DETAIL OF CONCRETE COLLAR FOR END TO END EXTENSIONS

RECORD DRAWING FEBRUARY 5, 1998
THIS RECORD DOCUMENT HAS BEEN PREPARED BASED IN PART UPON INFORMATION FURNISHED BY OTHERS. THE DESIGN PROFESSIONAL CANNOT ASSURE THE ACCURACY OF OTHERS' INFORMATION AND THIS IS NOT RESPONSIBLE FOR THE ACCURACY OF THIS RECORD DOCUMENT OR FOR ANY ERROR OR OMISSION THAT MAY HAVE BEEN INCORPORATED INTO IT AS A RESULT. THOSE RELYING ON THIS RECORD DOCUMENT ARE ADVISED TO OBTAIN INDEPENDENT VERIFICATION OF ITS ACCURACY BEFORE APPLYING IT FOR ANY PURPOSE.

THE SEAL APPEARING ON THIS DOCUMENT WAS AUTHORIZED BY KENNETH A. ROBERTS, P.E. 55446 ON MAY 7, 1998



RECORD DRAWING 2/5/98

STORMWATER CALCULATIONS & DETAILS						
EMMA JANE STREET						
DAVY CROCKETT						
CITY OF ROCKWALL, TEXAS						
Huitt-Zollars, Inc./Consulting Engineers Dallas, Fort Worth, Houston, Phoenix, Tustin, El Paso, Ontario, Albuquerque						
DESIGN	DRAWN	APPR.	SCALE	DATE	PROJECT NO.	NO.
HZI	HZI	KAR	NONE	MAY 98	01226201	ST-2