




3+50

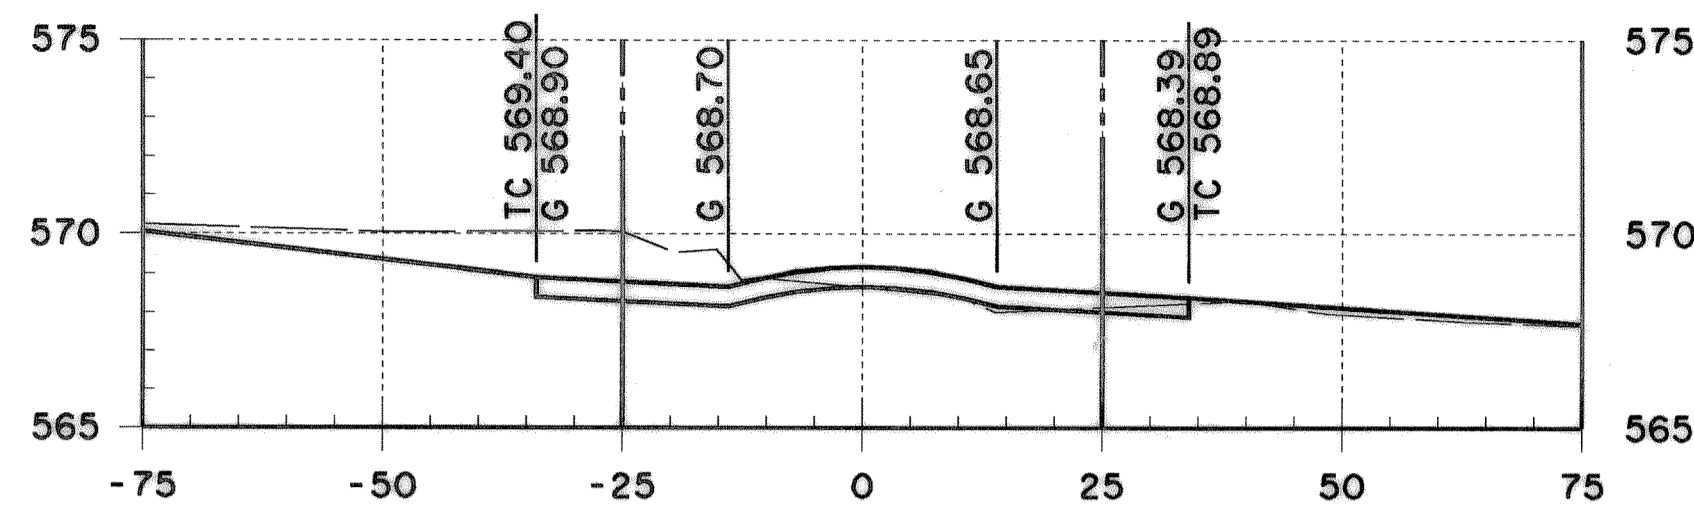


4+51.69
WEST CURB SAM HOUSTON

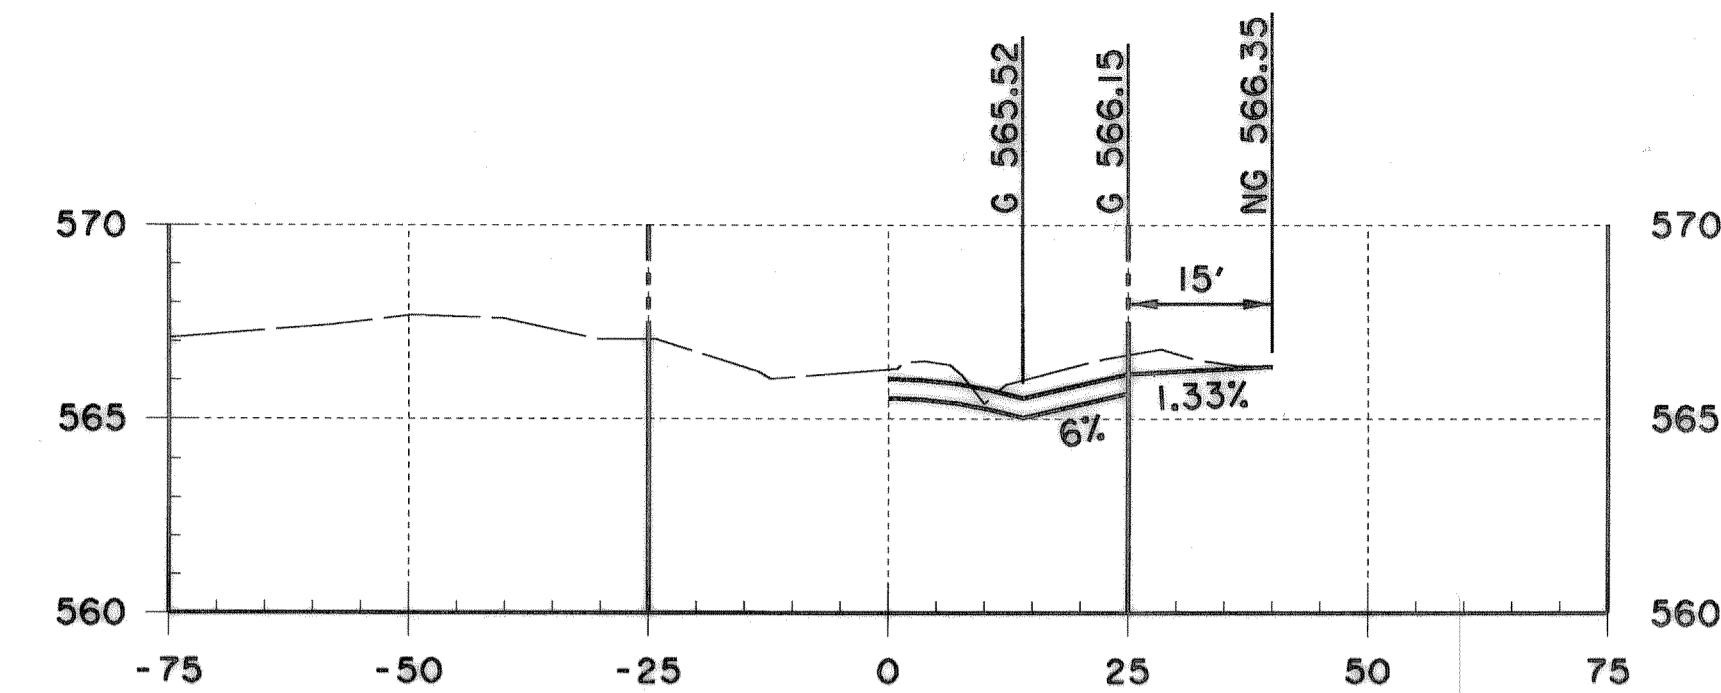


5+38.22
DRIVE RIGHT

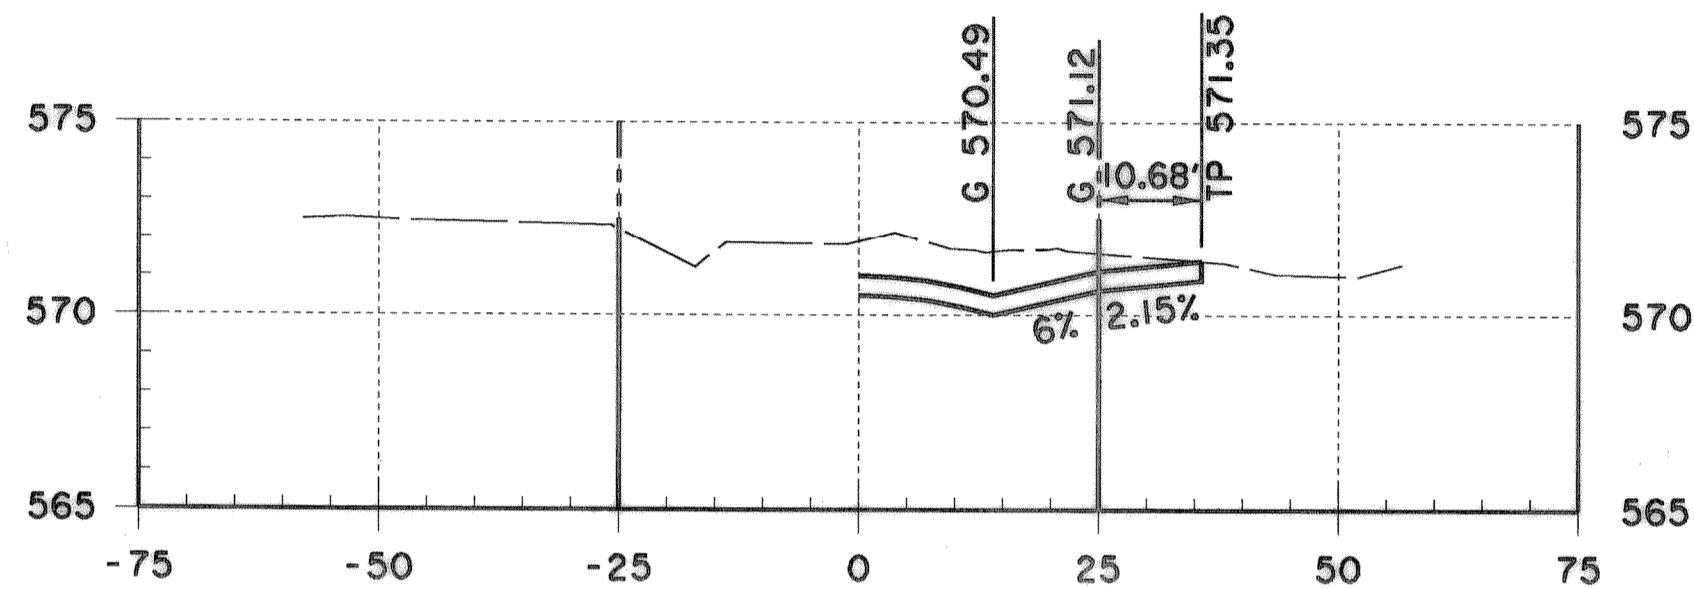


3+34.45
DRIVE RIGHT

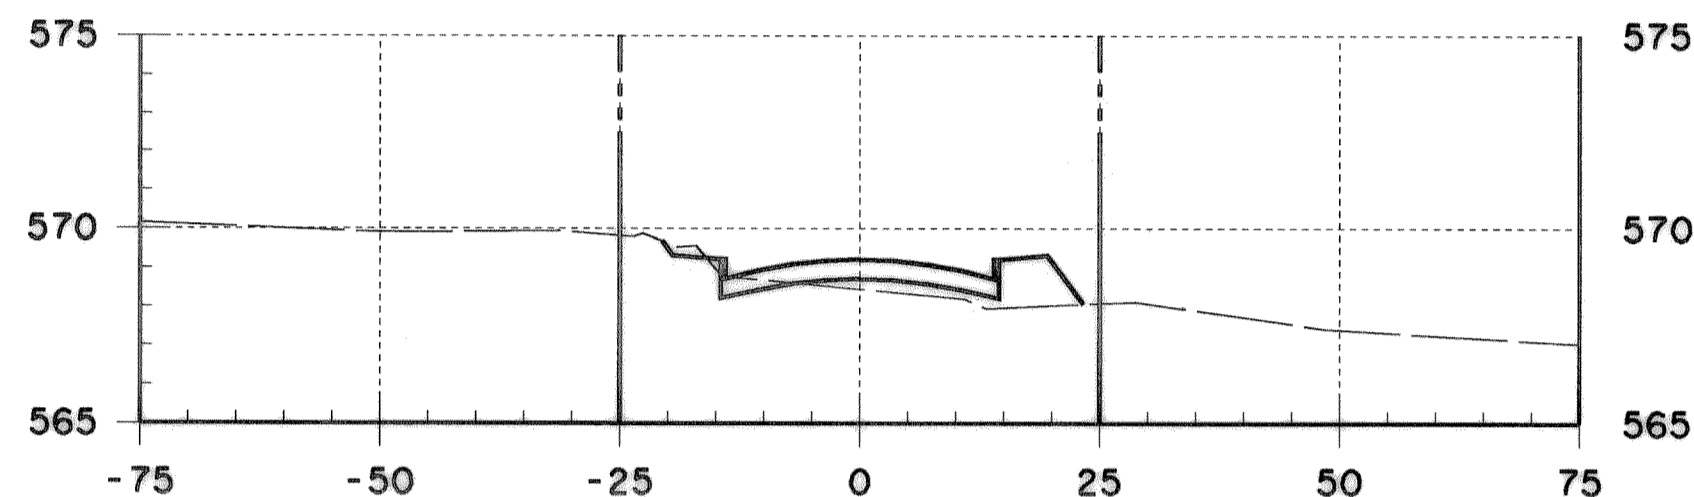


4+50

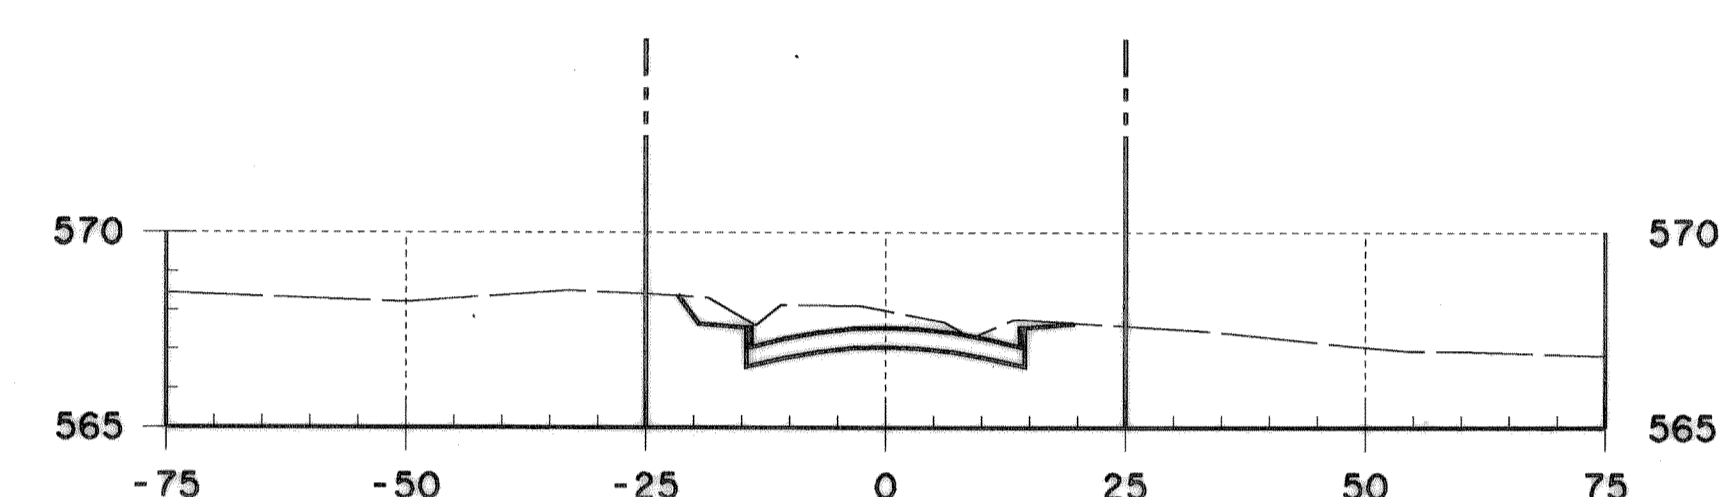


5+00

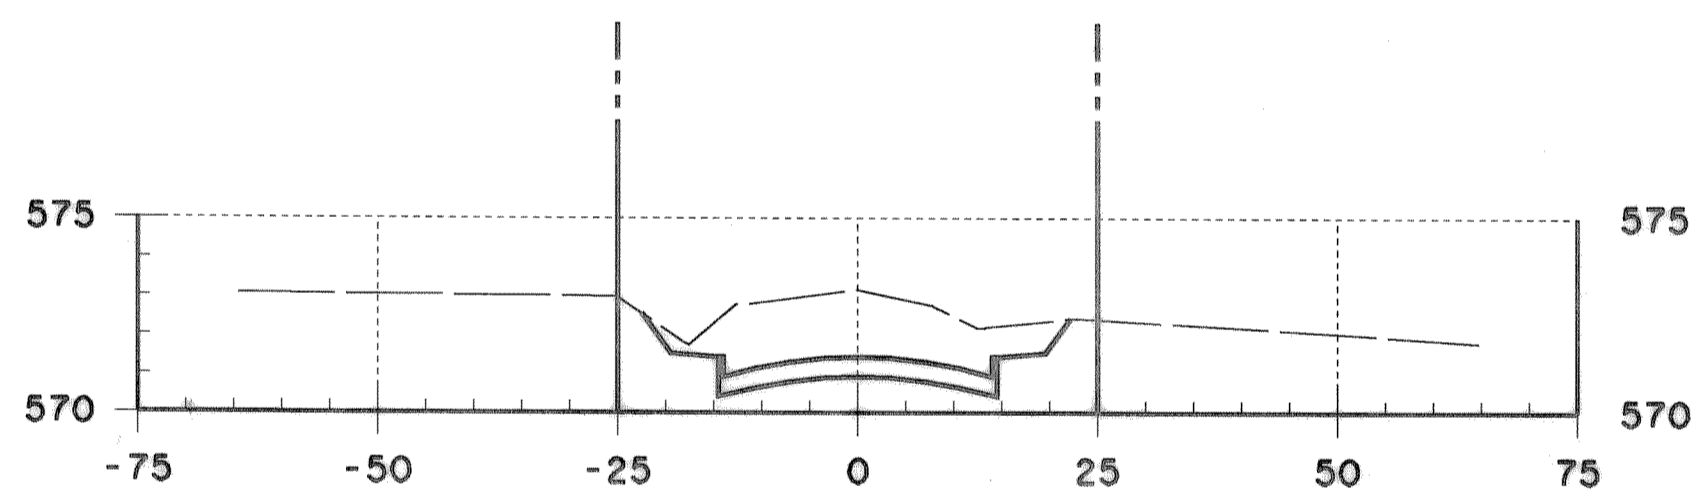


3+00

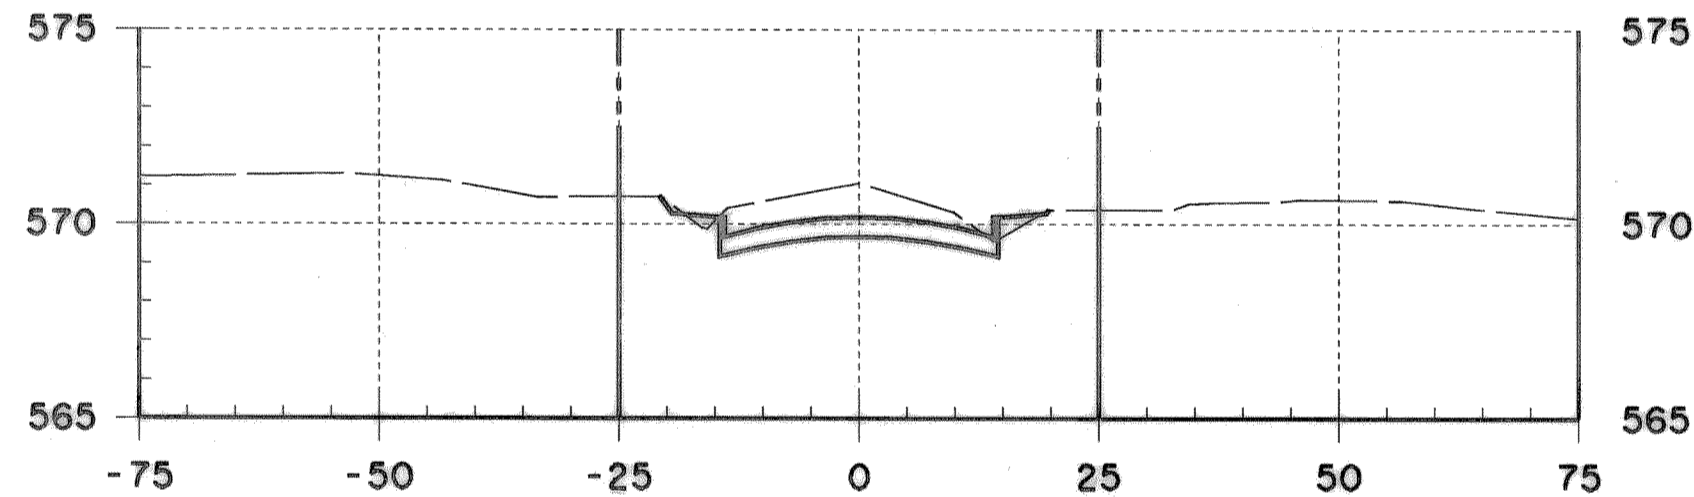


4+00

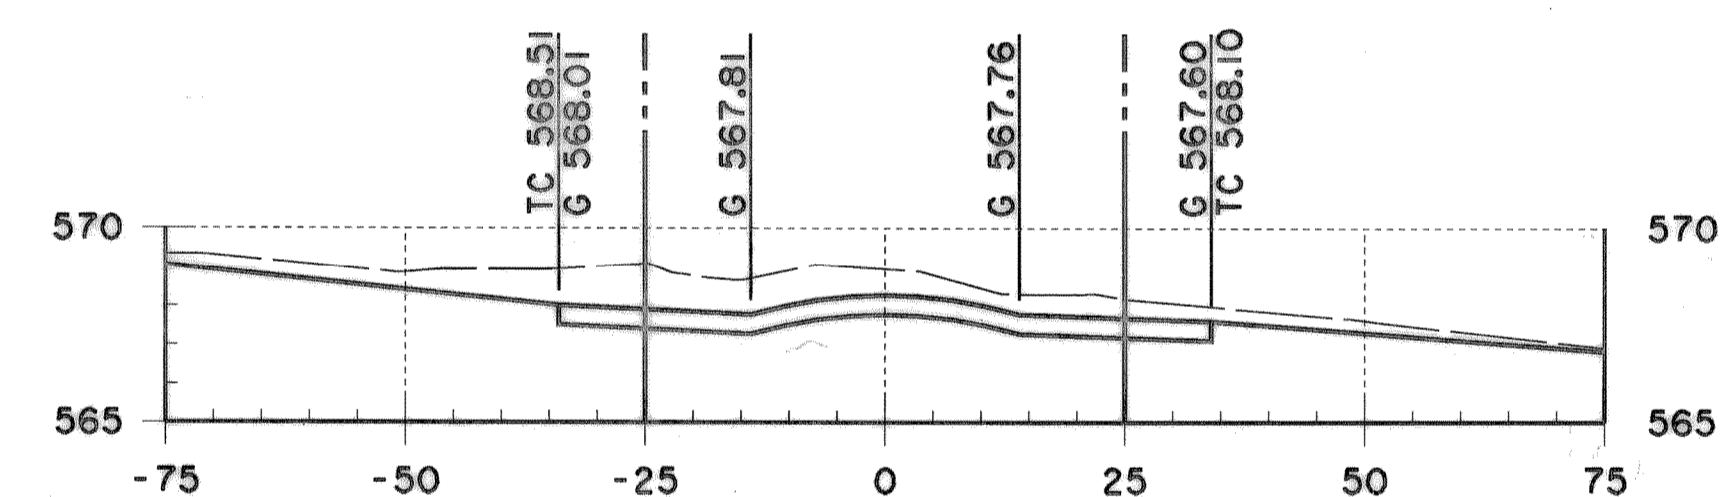


4+80.70
EAST CURB SAM HOUSTON

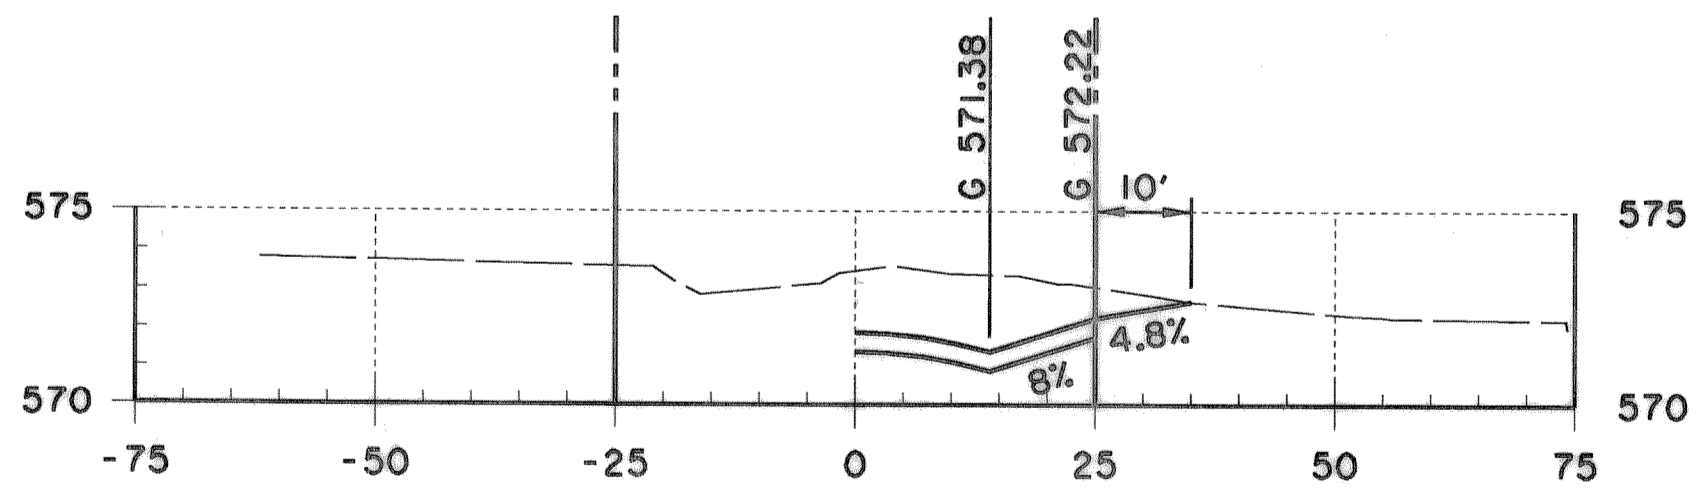

2+63.37
DRIVE RIGHT

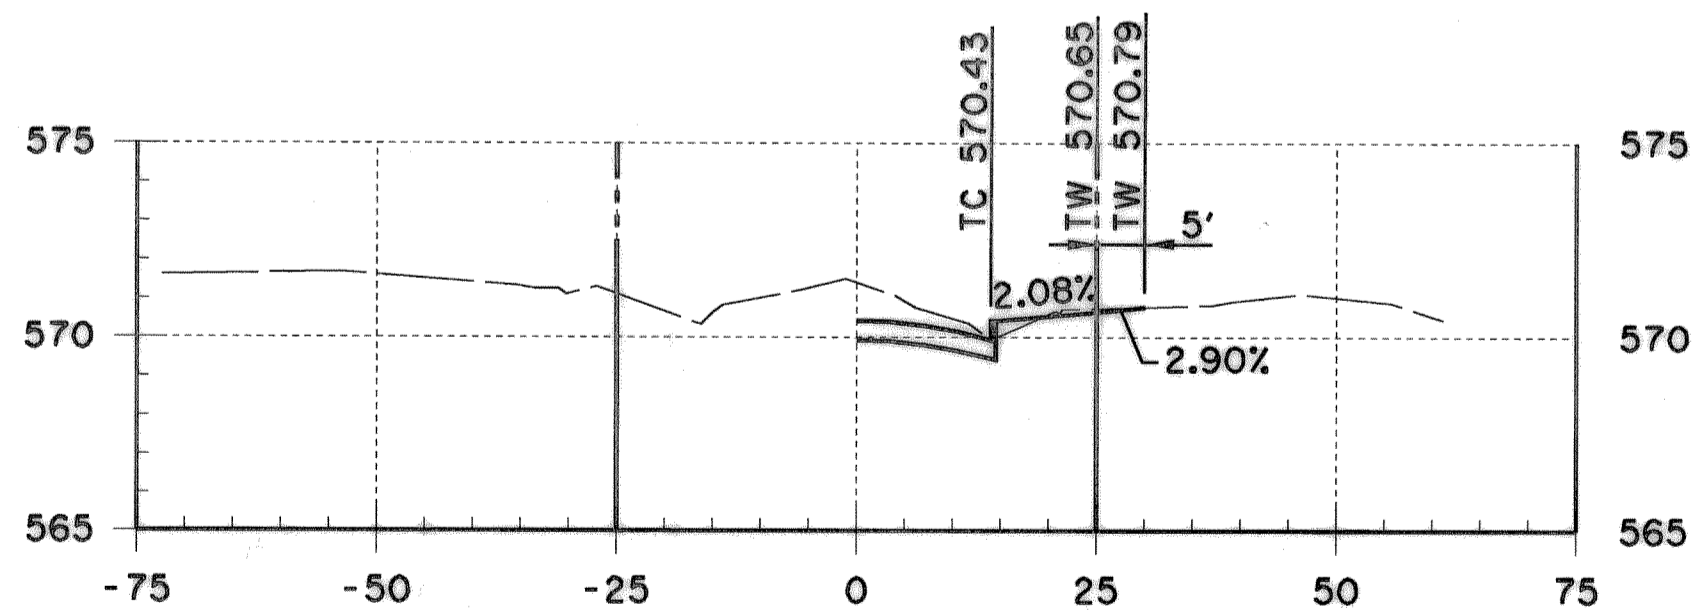


3+79.61
SIDEWALK RIGHT

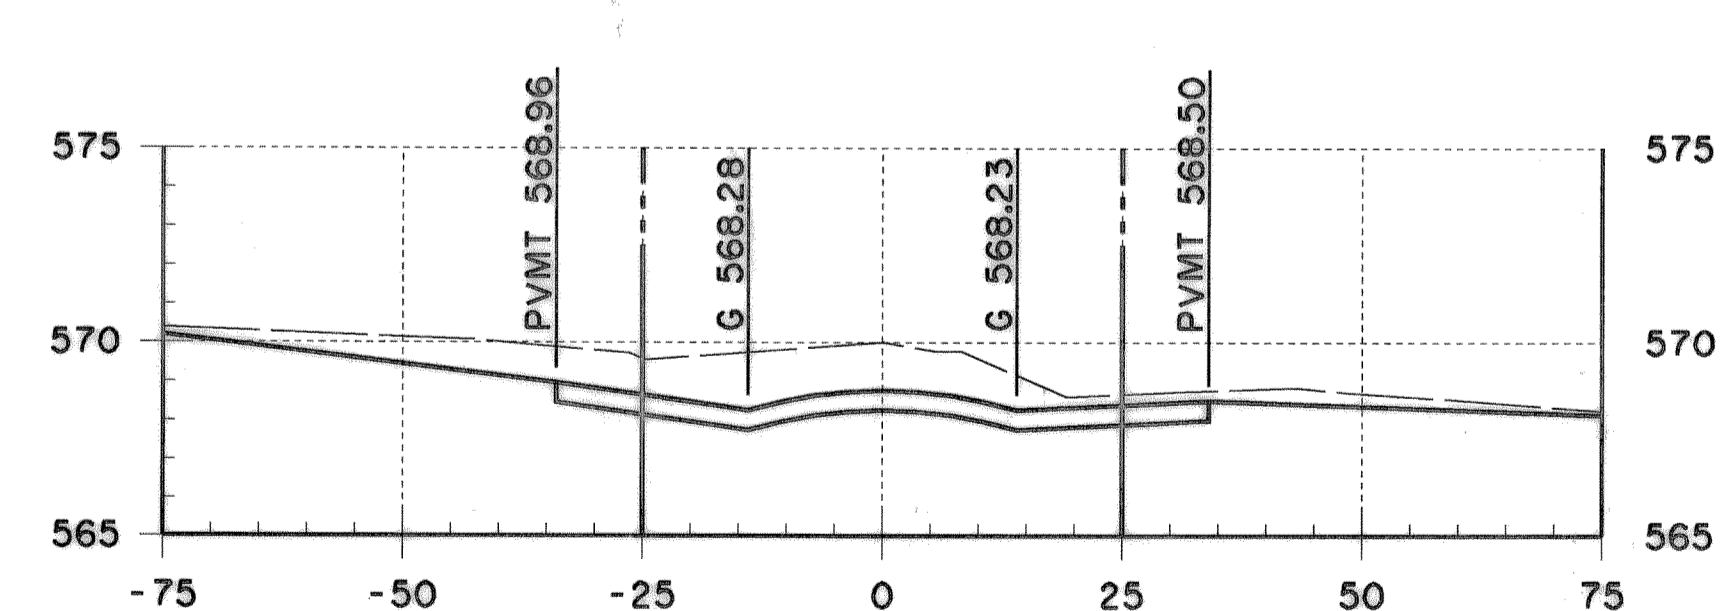


4+65.79
SAM HOUSTON

RECORD DRAWING
2/5/99

RECORD DRAWINGS FEBRUARY 5, 1999
THIS RECORD DOCUMENT HAS BEEN PREPARED IN PART UPON INFORMATION FURNISHED BY OTHERS. THE DESIGN PROFESSIONAL CANNOT ASSURE THE ACCURACY OF OTHERS' INFORMATION AND THIS IS NOT RESPONSIBLE FOR THE ACCURACY OF THIS RECORD DOCUMENT OR FOR ANY ERROR OR OMISSION THAT MAY HAVE BEEN INCORPORATED INTO IT AS A RESULT. THOSE RELYING ON THIS RECORD DOCUMENT ARE ADVISED TO OBTAIN INDEPENDENT VERIFICATION OF ITS ACCURACY BEFORE APPLYING IT FOR ANY PURPOSE.

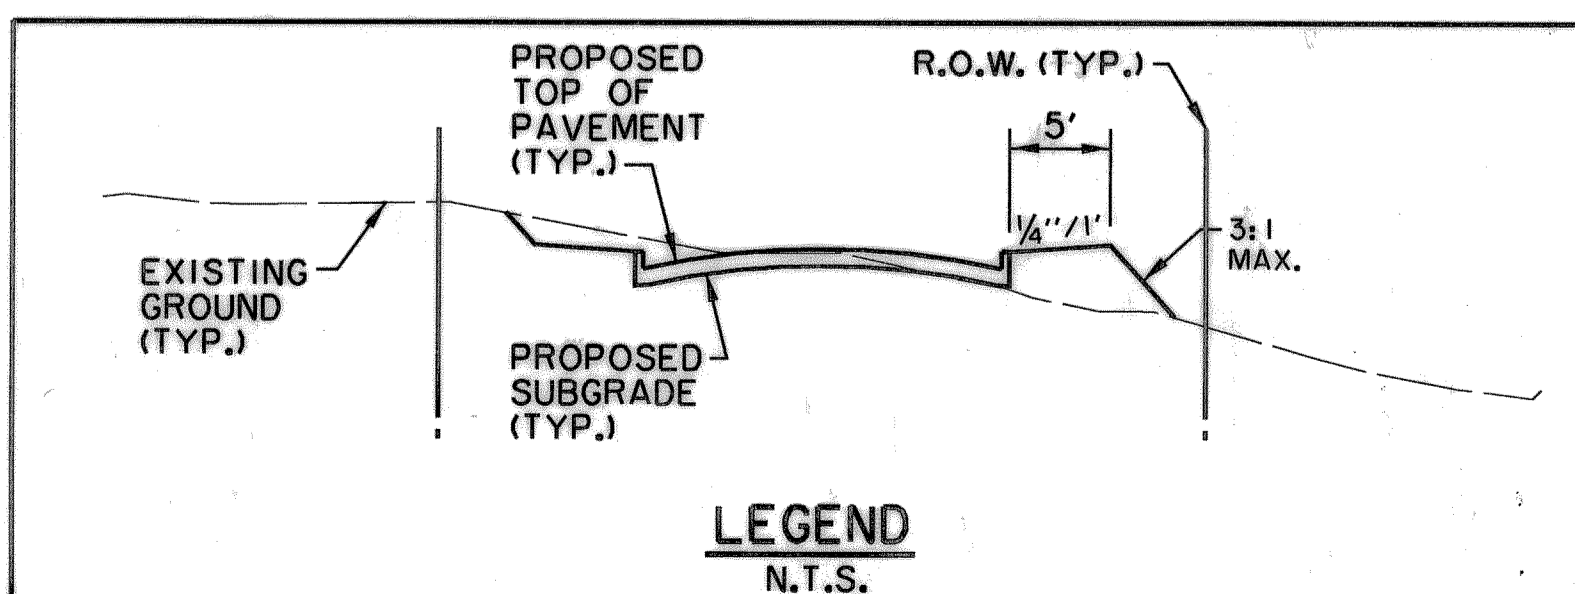

THE SEAL APPEARING ON THIS DOCUMENT WAS AUTHORIZED BY KENNETH A. ROBERTS, P.E. 55446 ON MAY 7, 1998

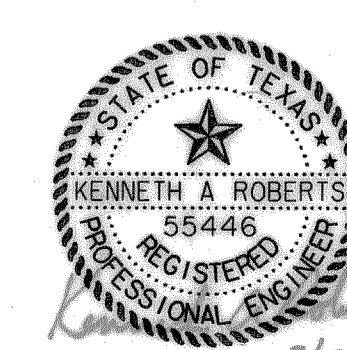

CROSS SECTIONS
STA. 2+63.37 TO STA. 5+38.22

EMMA JANE STREET
SOUTH GOLIAD TO DAVY CROCKETT
CITY OF ROCKWALL, TEXAS

Huff-Zollers, Inc./Consulting Engineers
Dallas, Fort Worth, Houston, Phoenix, Tustin, El Paso, Ontario, Albuquerque

DESIGN	DRAWN	APPR.	SCALE	DATE	PROJECT NO.	NO.
HZI	HZI	KAR	H: 1"=20' V: 1"=5'	MAY 98	01226201	X-2