

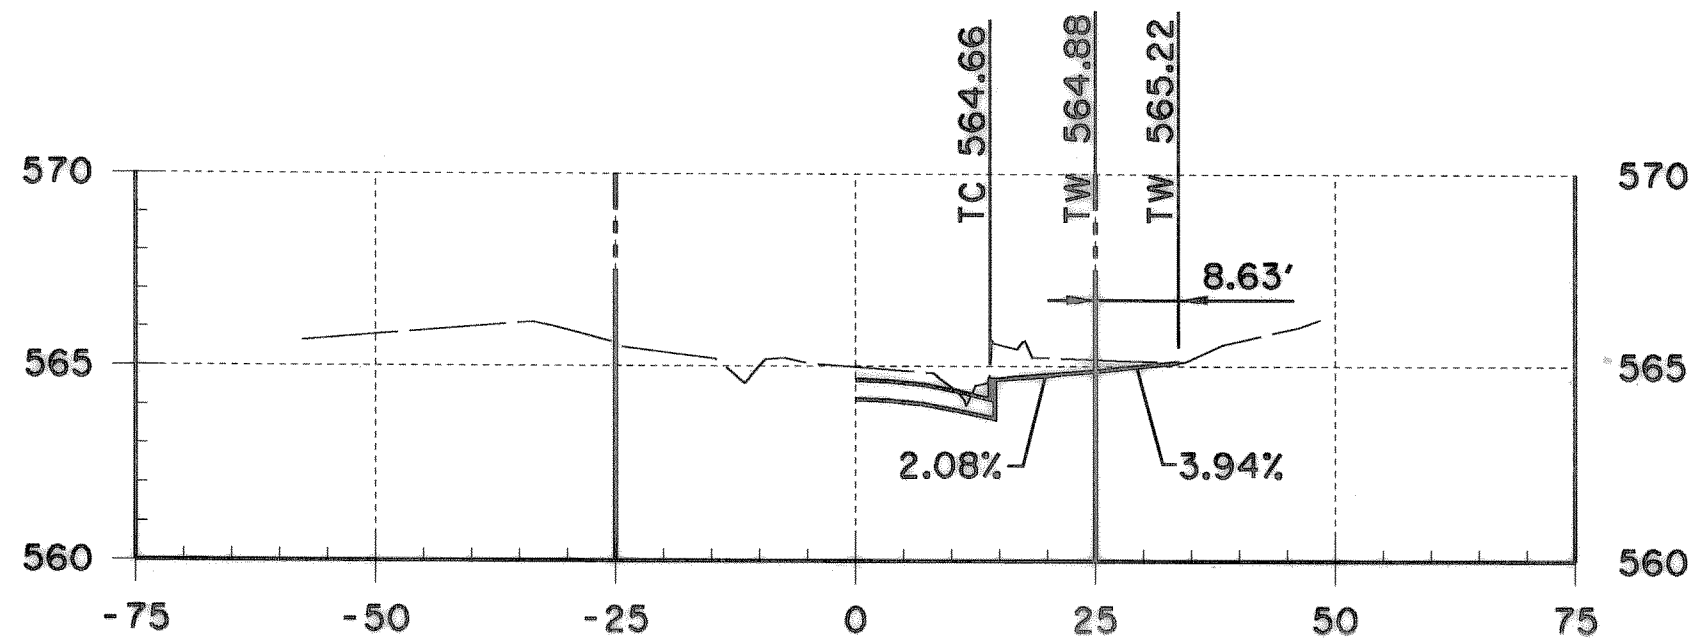



6+00

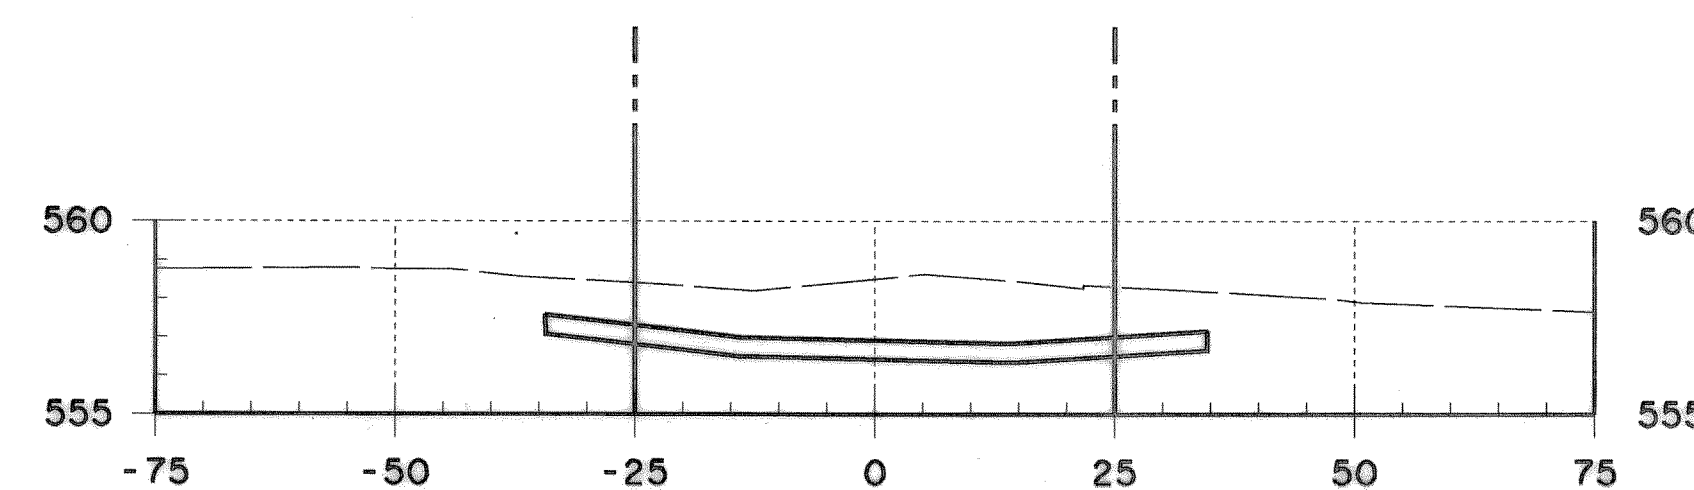


6+91.69
☐ DRIVE RIGHT

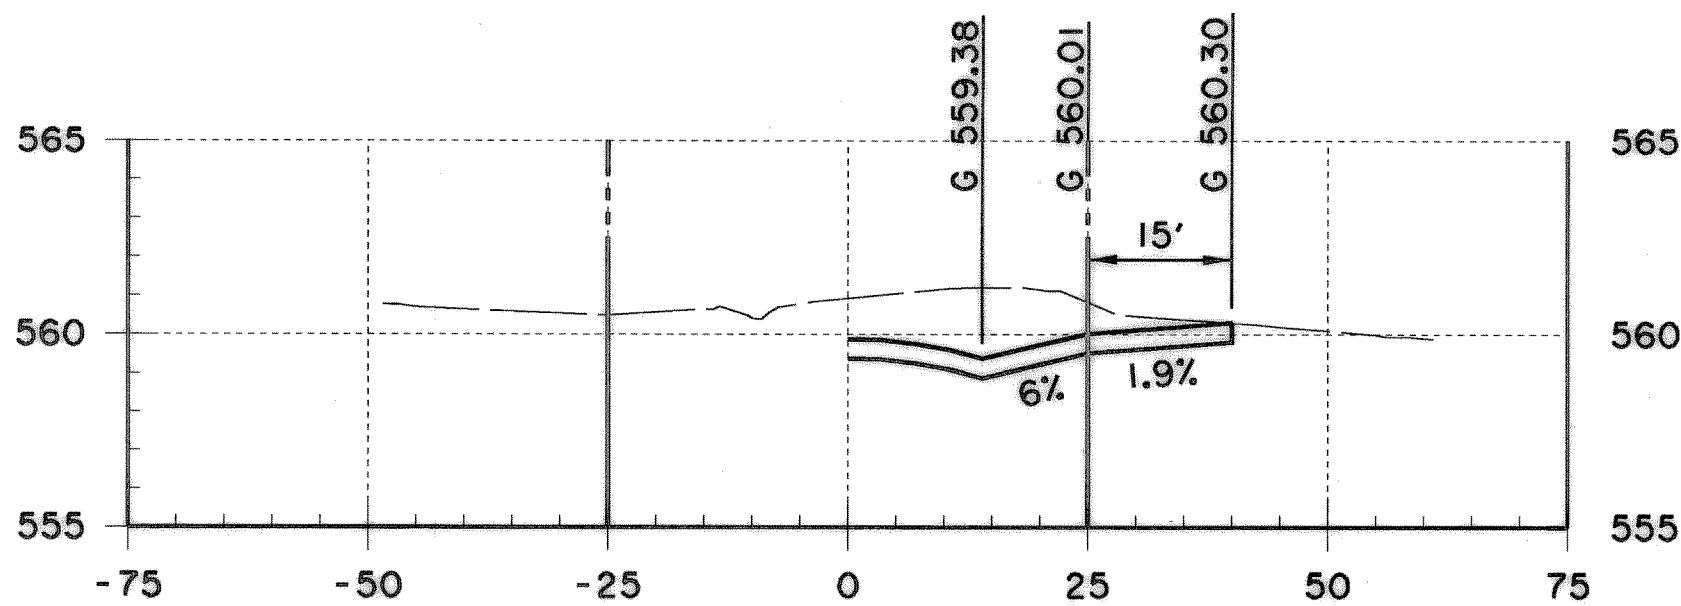


7+55.26
WEST CURB DAVY CROCKETT

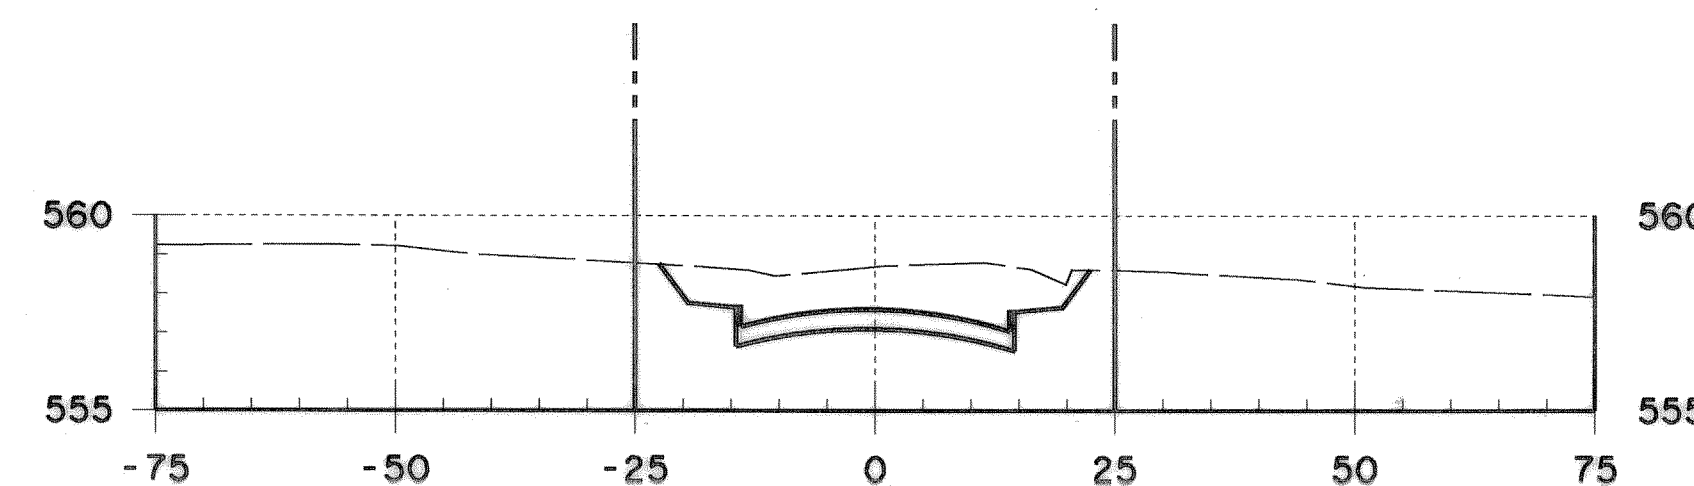


7+50

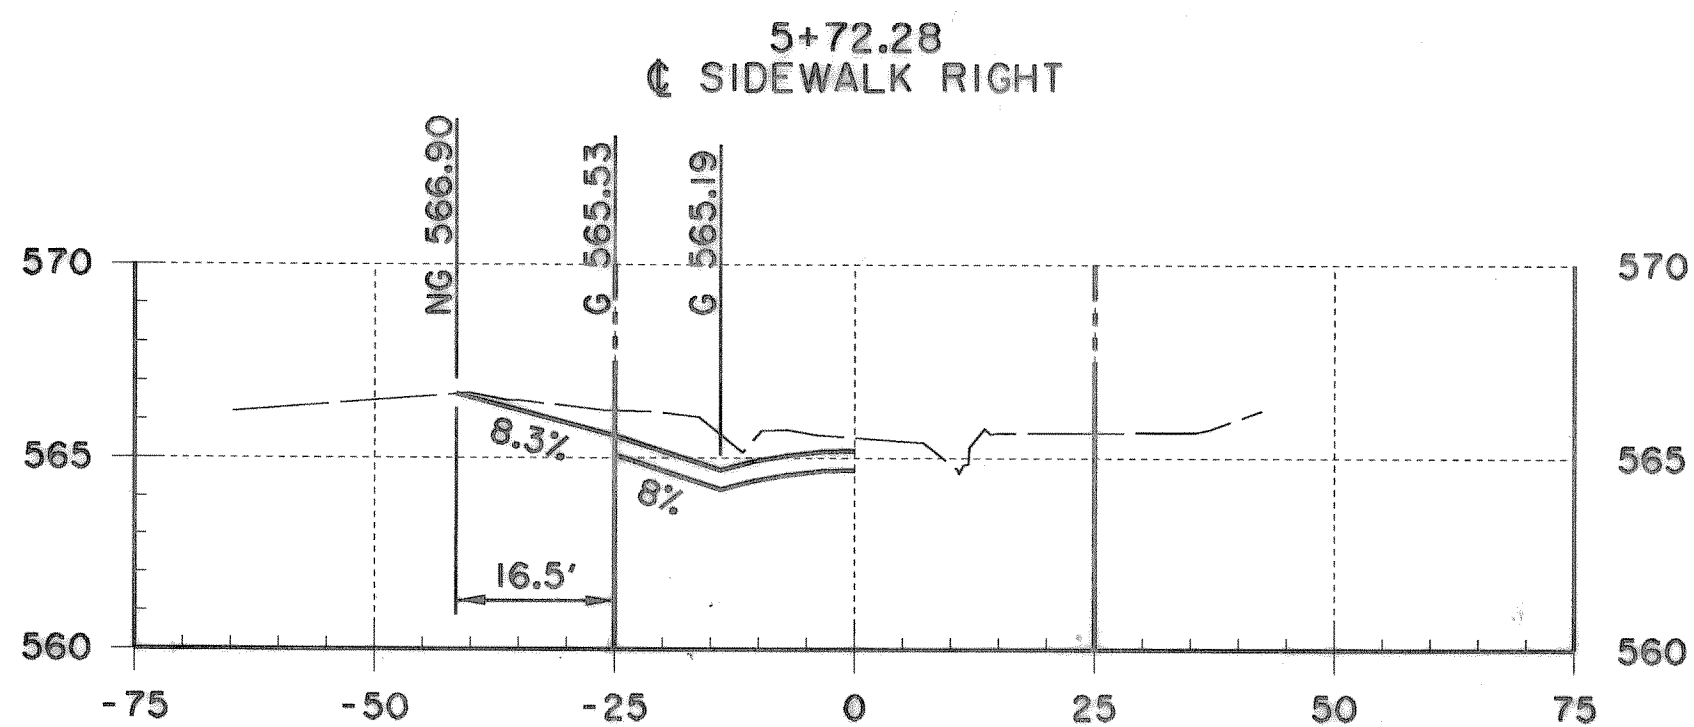


5+72.28
☐ SIDEWALK RIGHT

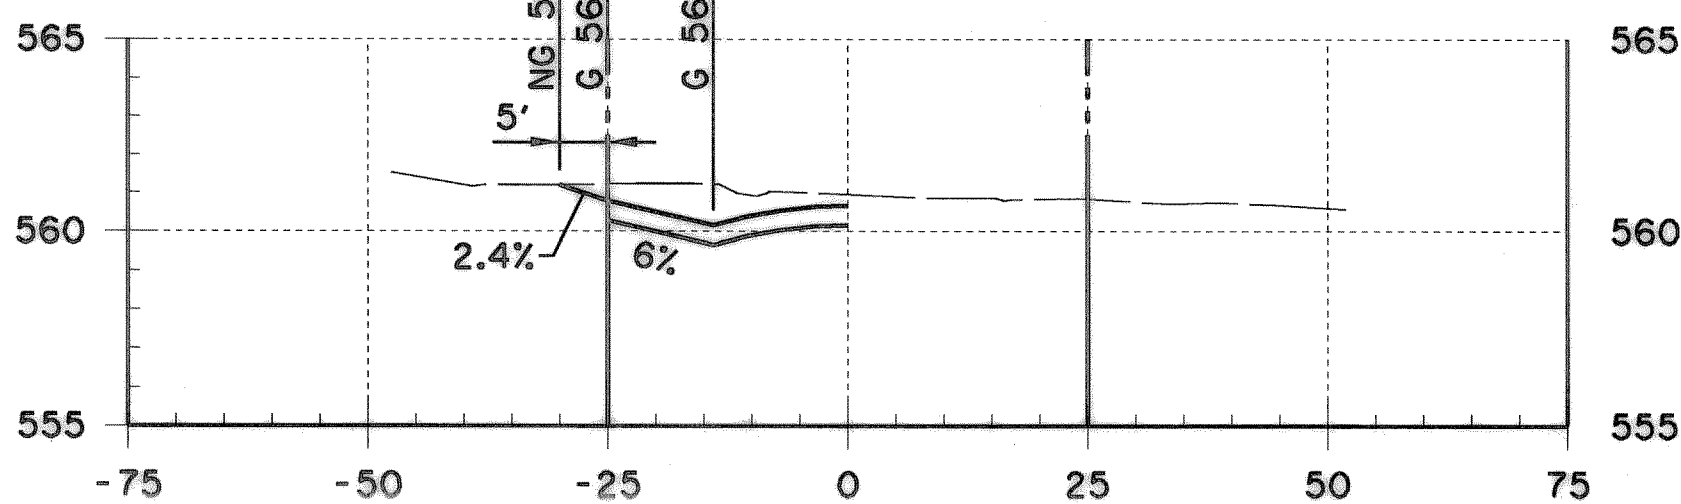


6+72.43
☐ DRIVE LEFT

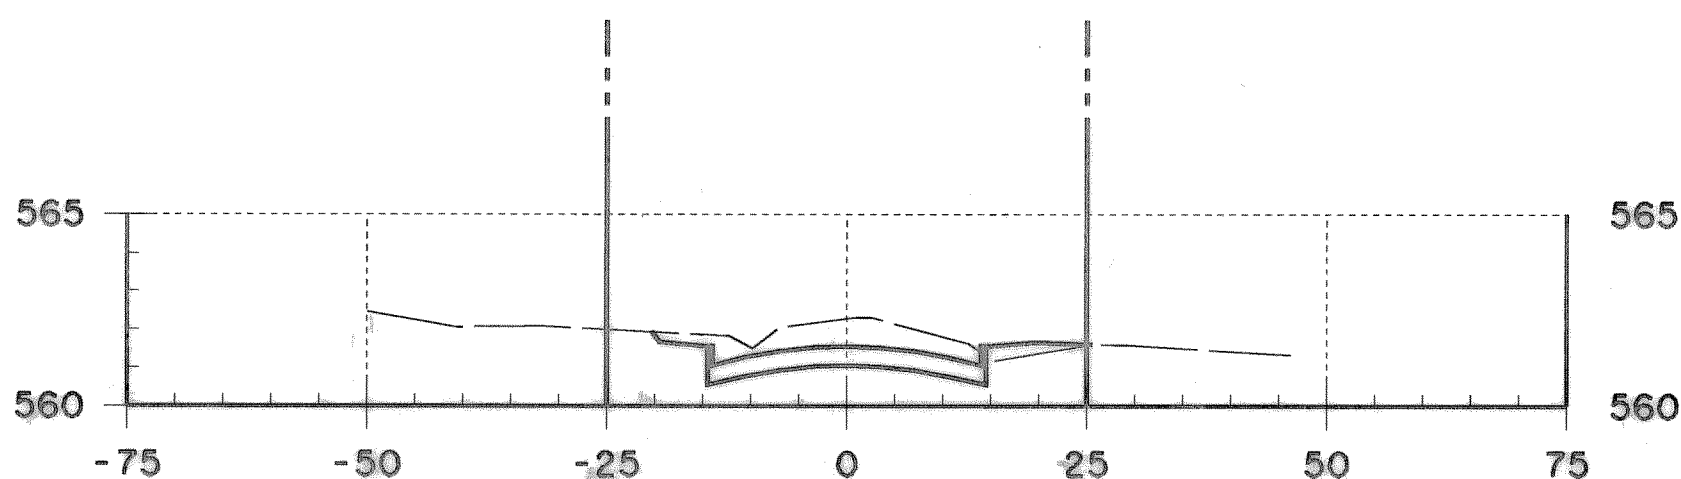

6+50

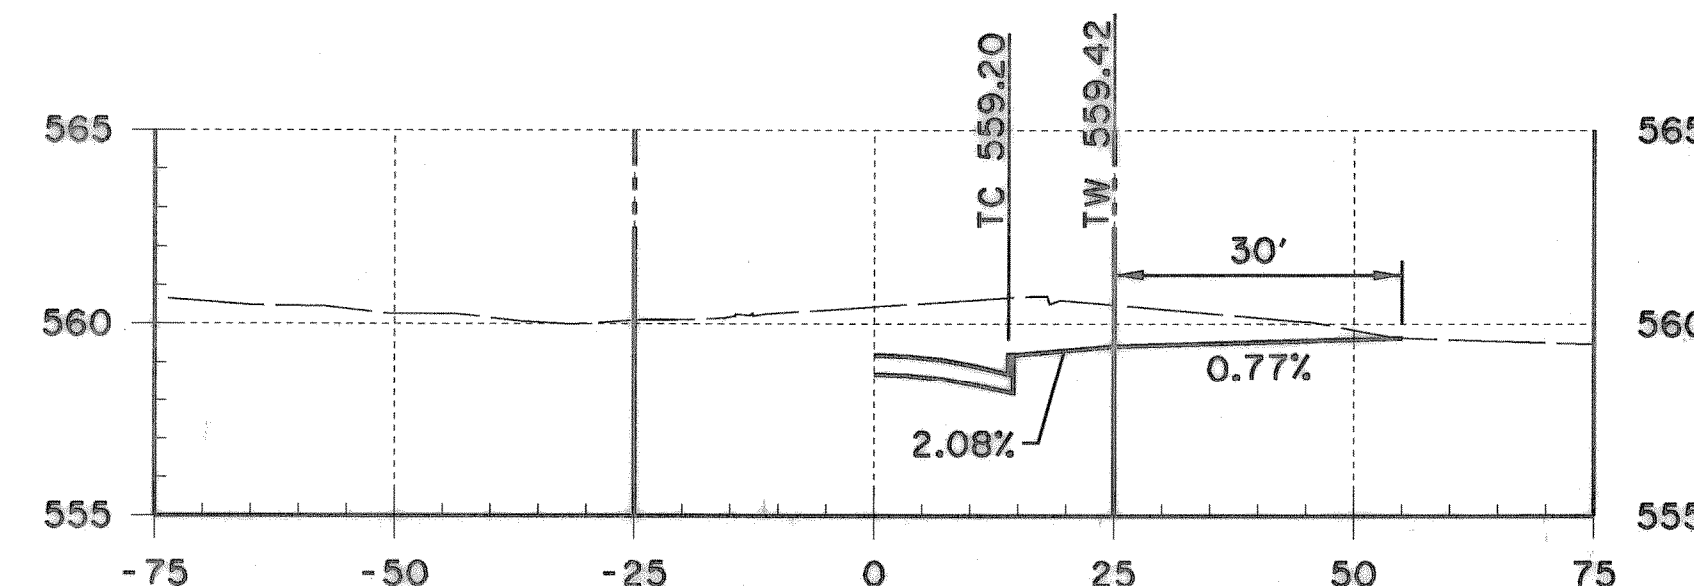


7+08.73
☐ SIDEWALK RIGHT

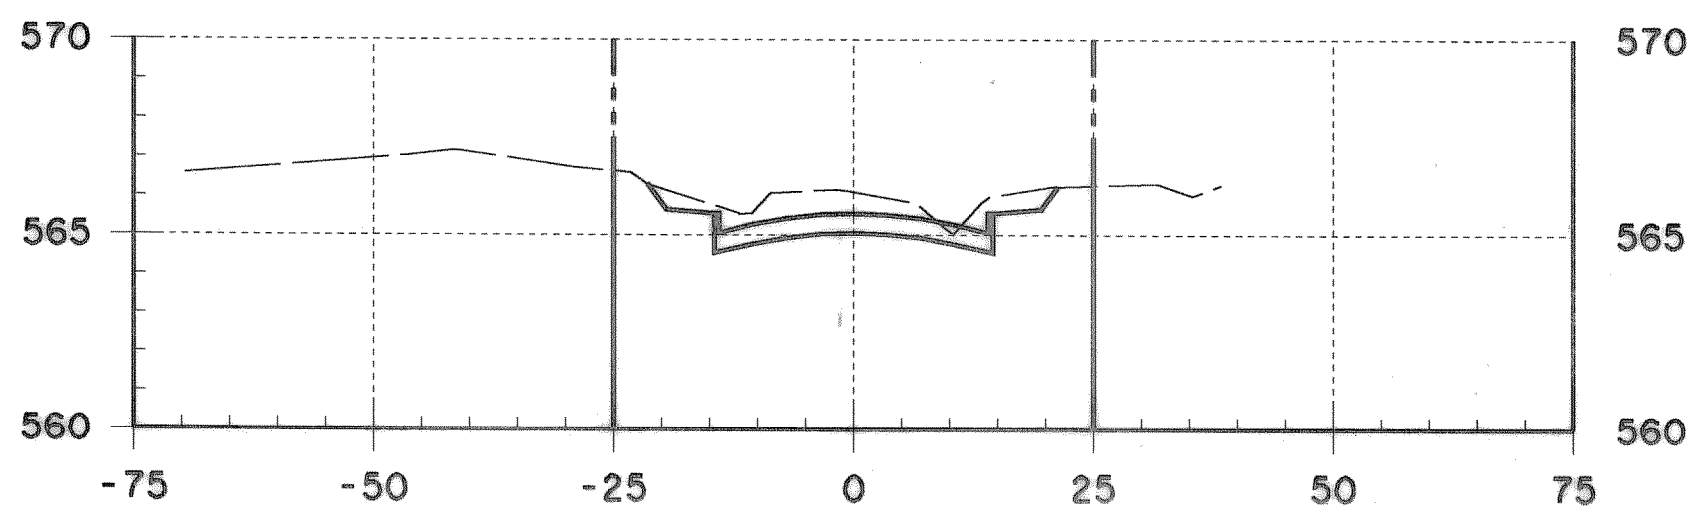


5+59.02
☐ DRIVE LEFT

5+50

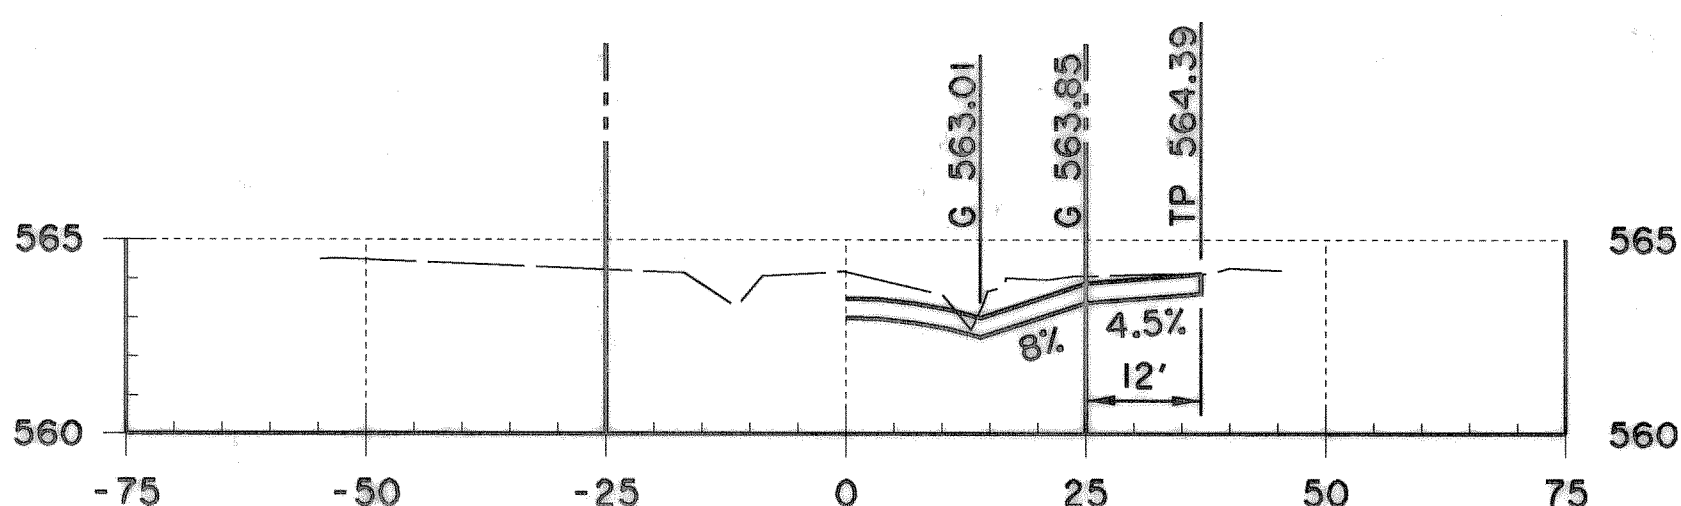


6+01.09
☐ DRIVE RIGHT

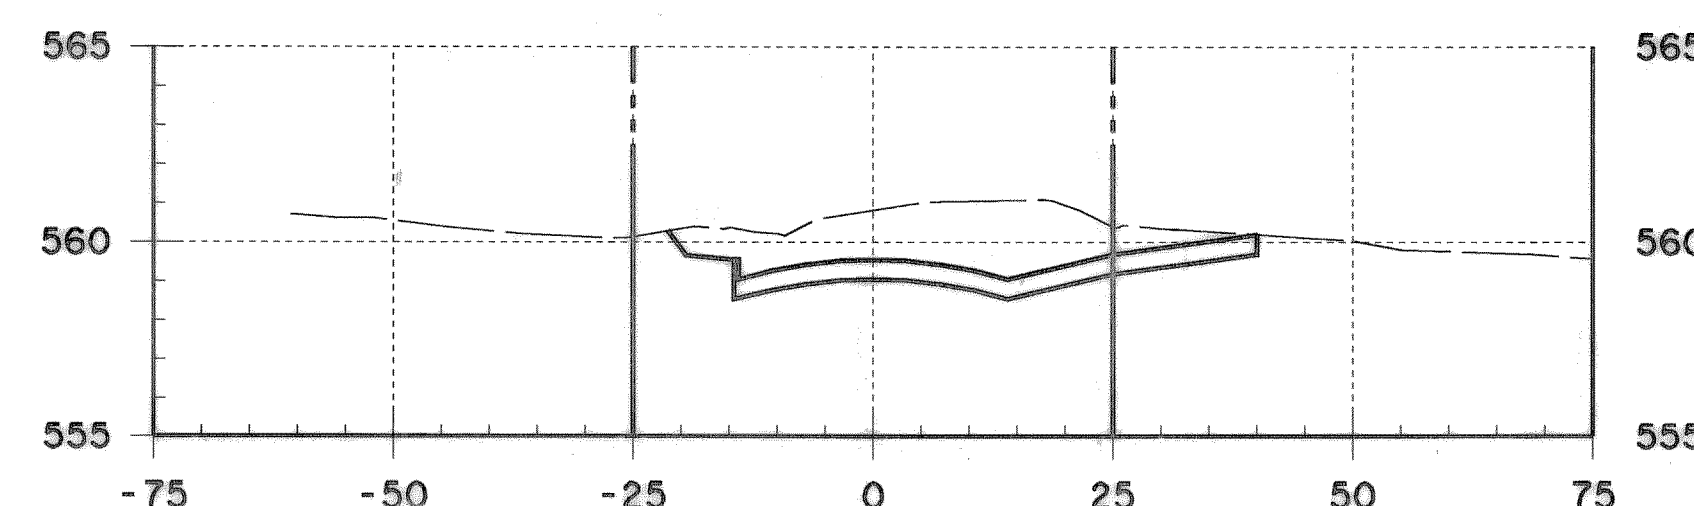


7+00

RECORD DRAWING
2/5/99

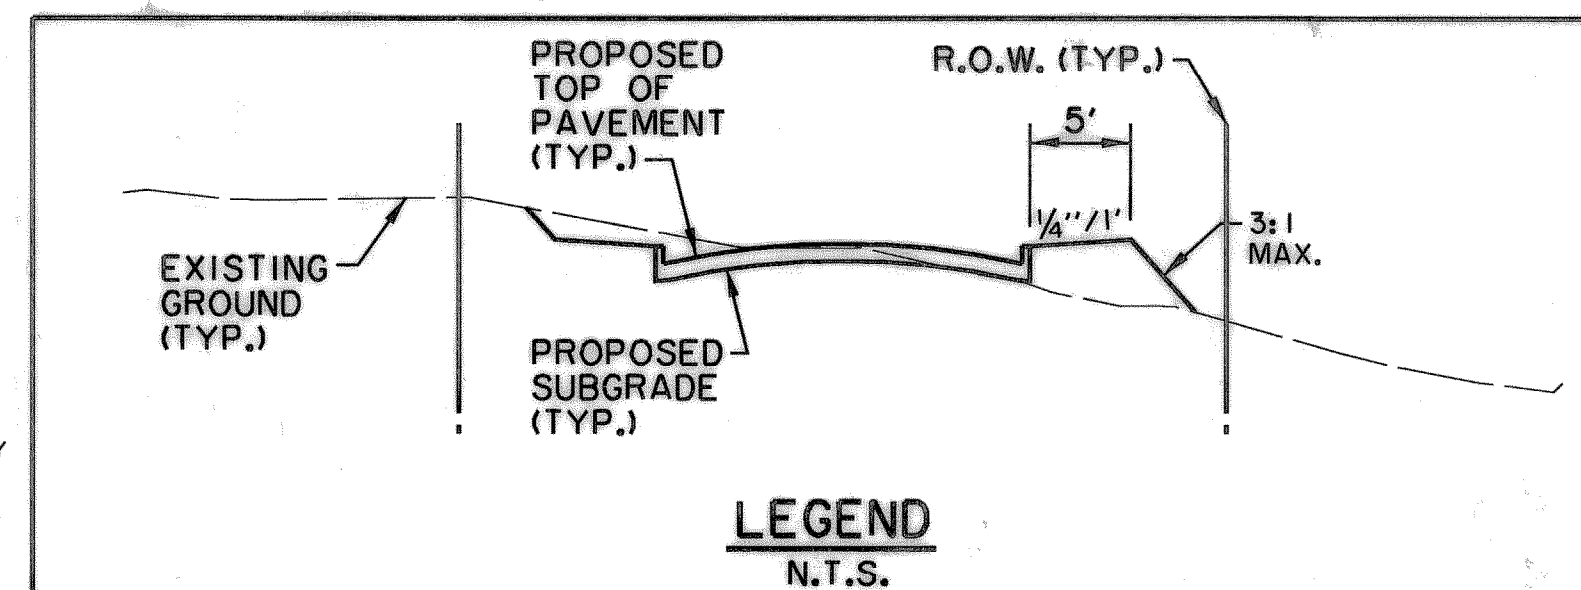

LEGEND
N.T.S.

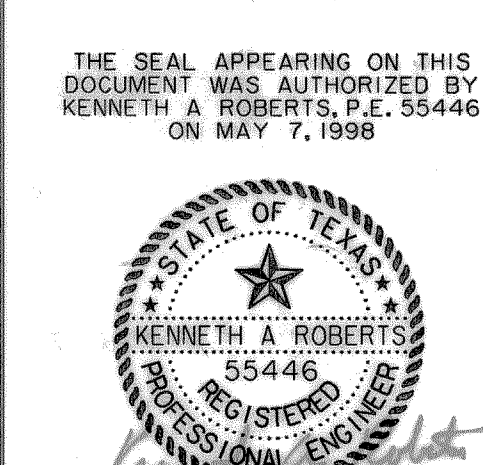

CROSS SECTIONS STA. 5+50 TO STA. 7+55.26						
EMMA JANE STREET						
SOUTH GOLIAD TO DAVY CROCKETT						
CITY OF ROCKWALL, TEXAS						
Huitt-Zollars, Inc./Consulting Engineers Dallas, Fort Worth, Houston, Phoenix, Tustin, El Paso, Ontario, Albuquerque						
DESIGN	DRAWN	APPR.	SCALE	DATE	PROJECT NO.	NO.
HZI	HZI	KAR	H ₁ 1"=20' V ₁ 1"=5'	MAY 98	01226201	X-3

RECORD DRAWINGS FEBRUARY 5, 1999
THIS RECORD DOCUMENT HAS BEEN PREPARED BASED IN PART UPON INFORMATION FURNISHED BY OTHERS. THE DESIGN PROFESSIONAL CANNOT ASSURE THE ACCURACY OF OTHERS' INFORMATION AND THIS IS NOT RESPONSIBLE FOR THE ACCURACY OF THIS RECORD DOCUMENT OR FOR ANY ERROR OR OMISSION THAT MAY HAVE BEEN INCORPORATED INTO IT AS A RESULT. THOSE RELYING ON THIS RECORD DOCUMENT ARE ADVISED TO OBTAIN INDEPENDENT VERIFICATION OF ITS ACCURACY BEFORE APPLYING IT FOR ANY PURPOSE.

X:\proj\01226201\01226201.dwg
 2/5/99
 KENNETH A. ROBERTS
 REGISTERED PROFESSIONAL ENGINEER
 NO. 55446
 STATE OF TEXAS
 EXPIRES MAY 7, 1998
 HUIITT-ZOLLARS, INC.
 CONSULTING ENGINEERS
 DALLAS, FORT WORTH, HOUSTON, PHOENIX, TUSTIN, EL PASO, ONTARIO, ALBUQUERQUE