


REVISED: 11/6/08 - AQUIVAREZ  
PLOT SCALE: 1:4000  
PLOT STYLE: 11x17.ctb  
PLOTTED BY: AQUIVAREZ ON 11/6/2008  
H:\Projects\Rockwall\2004147\Line-D&E\Sheets\2004147-00.dwg

# CITY OF ROCKWALL, TEXAS

## CONSTRUCTION PLANS FOR:

# F.M. 3097 SANITARY SEWER IMPROVEMENTS

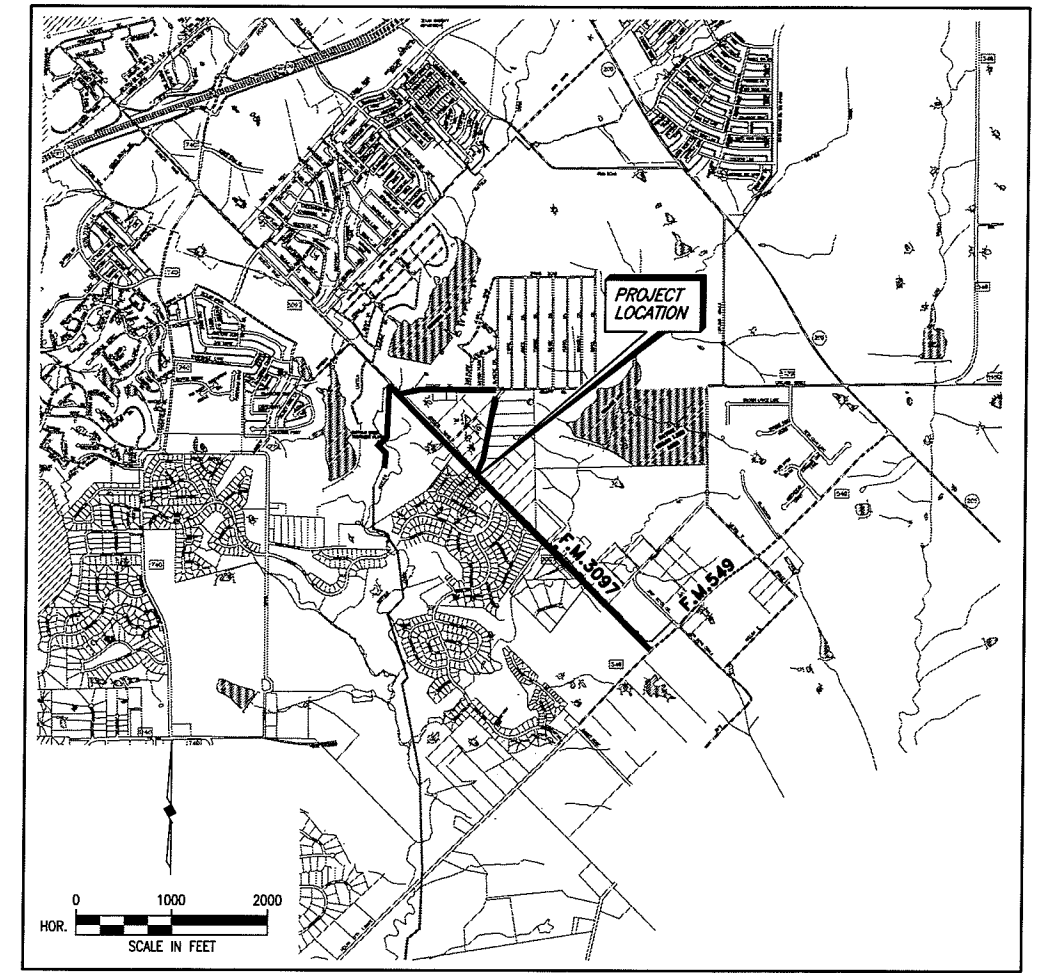

**LOCATION MAP**

### SHEET INDEX

<u>SHEET NO.</u>	<u>SHEET DESCRIPTION</u>
—	COVER SHEET & LOCATION MAP
1	GENERAL NOTES & SERVICE AREA MAP
2-12	SANITARY SEWER LINE 'A' PLAN/PROFILE
13-16	SANITARY SEWER LINE 'D' PLAN/PROFILE & FORCE MAIN LINE 'F'
17-22	SANITARY SEWER LINE 'E' PLAN/PROFILE
23-26	SANITARY SEWER LINE 'B' PLAN/PROFILE
27-29	SANITARY SEWER LINE 'C' PLAN/PROFILE
30-31	FM 3097 LIFT STATION #1 - CIVIL
32-33	FM 3097 LIFT STATION #1 - ELECTRICAL (GEN. SET)
34-35	DETAILS
36	FM 3097 LIFT STATION #2
37	FM 3097 LIFT STATION #2

### COUNCIL MEMBERS

- BILL CECIL, MAYOR
- BOB COTTI, MAYOR PRO-TEM
- STEPHEN STRAUGHAN
- TIM McCALLUM
- JOHN KING
- MATT SCOTT
- MARGO NIELSEN

### CITY MANAGER


JULIE COUCH

### ASSISTANT CITY MANAGER

RICHARD CROWLEY

### CITY ENGINEER

CHUCK TODD, P.E.

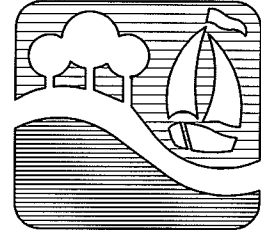

DECEMBER, 2005

THESE DOCUMENTS ARE FOR  
BIDDING, CONSTRUCTION,  
AND PERMIT PURPOSES.  
DATE: 12/7/05



*This record drawing is a compilation of the sealed engineering drawing for this project; modified by addenda, change orders and information furnished by the contractor. The information shown on the record drawings that was provided by the contractor or others not associated with the design engineer cannot be verified for accuracy or completeness. This original sealed drawings are on file at the offices of Birkhoff, Hendricks & Conway, L.L.P.*  
BY P.A.C. DATE 11/06/08