



REVISID: 1/13/06 - WHAYS
 H:\Projects\Rockwall\2004147\Basedwgs\Common_Details\2004147 DTO2.dwg
 PLOT SCALE: 1:2.01
 PLOT STYLE: 11x17.ctb
 PLOTTED BY: AULVAREZ ON 11/16/2008

- FENCE NOTES:**
- FENCE SHALL BE MADE OF WELDED STEEL.
 - WELDED STEEL GATES SHALL BE DOUBLE 6 FOOT WIDE, MANUAL SWING OPENING GATES WITH LATCH PLATE FOR LOCKING & PADLOCK.
 - SHOP DRAWINGS FOR GATES, ALL FENCING AND PAINT COLOR SHALL BE SUBMITTED TO ENGINEER FOR APPROVAL PRIOR TO FABRICATION.

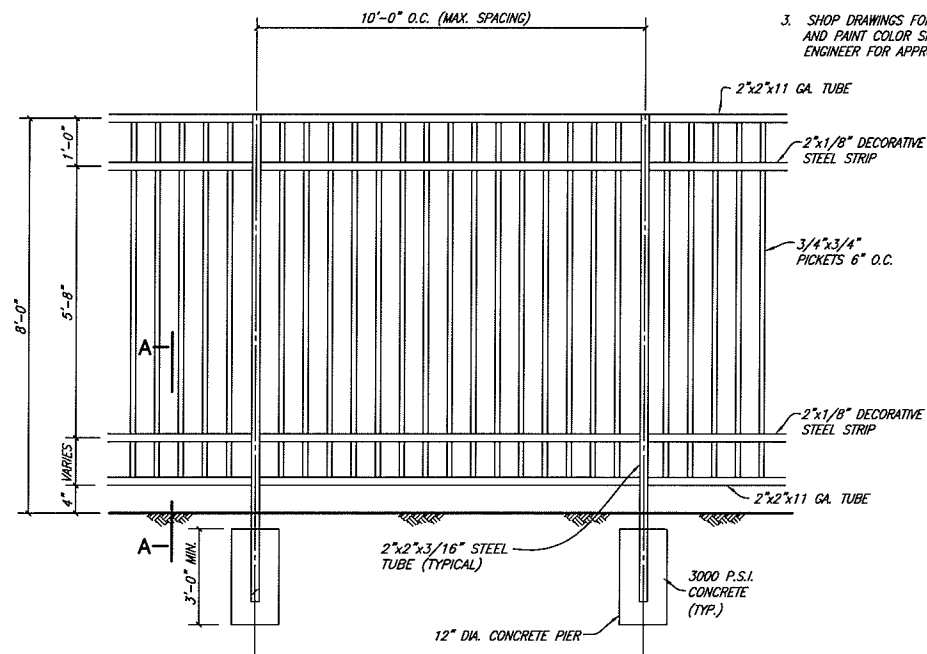


WELDED STEEL FENCE ELEVATION
 NO SCALE

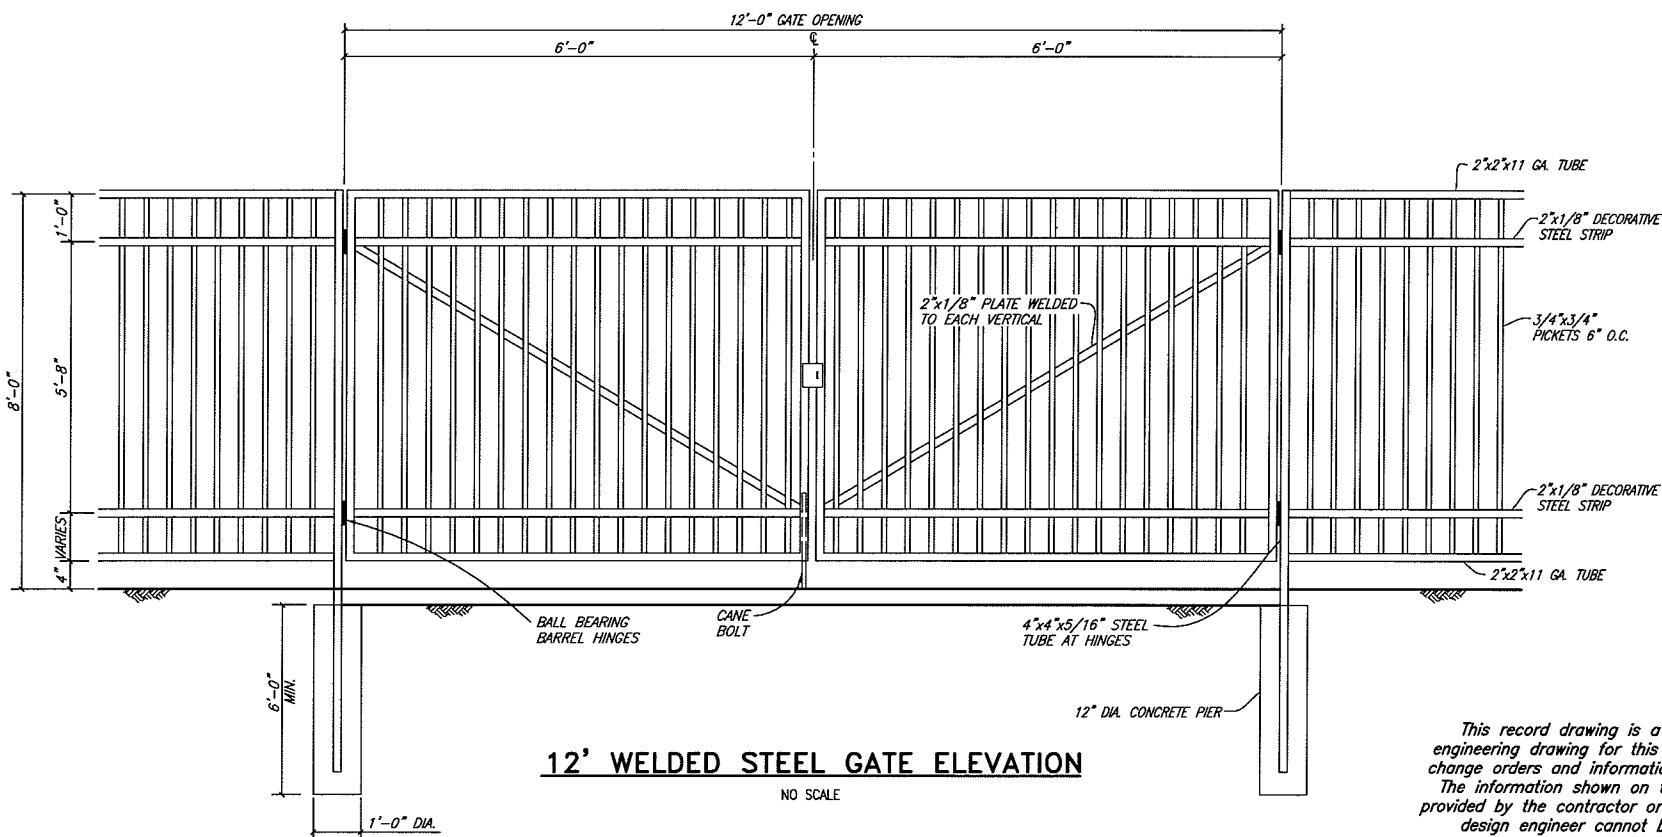


12' WELDED STEEL GATE ELEVATION
 NO SCALE

This record drawing is a compilation of the sealed engineering drawing for this project; modified by addenda, change orders and information furnished by the contractor. The information shown on the record drawings that was provided by the contractor or others not associated with the design engineer cannot be verified for accuracy or completeness. This original sealed drawings are on file at the offices of Birkhoff, Hendricks & Conway, L.L.P.

BY P.A.C. DATE 11/06/08

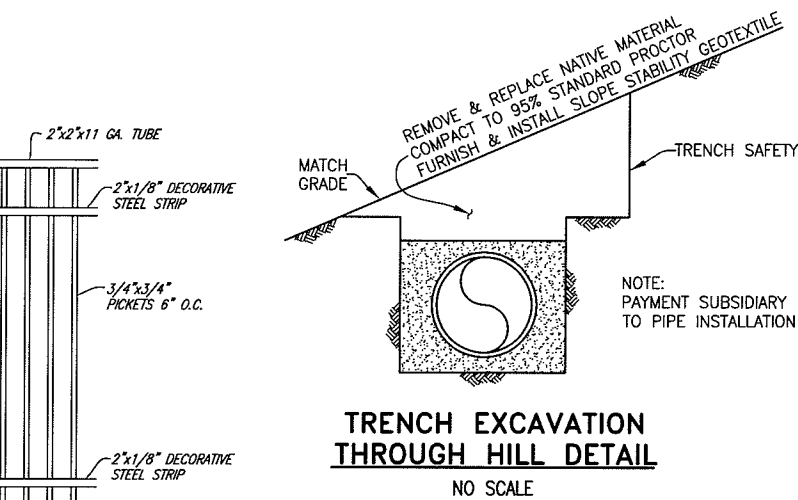

TRENCH EXCAVATION THROUGH HILL DETAIL
 NO SCALE

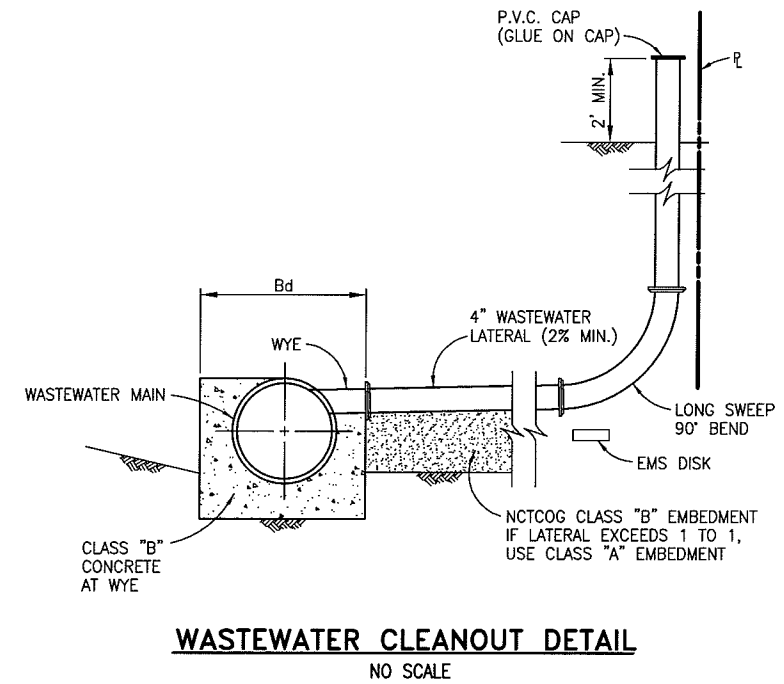


WASTEWATER CLEANOUT DETAIL
 NO SCALE

These plans and related specifications were prepared for construction of this specific project only. Reuse of these documents is not permitted without written authorization of Birkhoff, Hendricks & Conway, L.L.P.

ADDENDUM NO. 1
 1/13/06
 INCORPORATED
 TXDOT COMMENTS

THESE DOCUMENTS ARE FOR
 BIDDING, CONSTRUCTION,
 AND PERMIT PURPOSES.
 DATE: 11/13/08

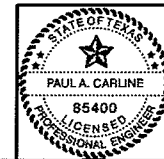

CITY OF ROCKWALL, TEXAS			
F.M. 3097 SAN. SEW. IMPROVEMENTS			
DETAILS			
BIRKHOFF, HENDRICKS & CONWAY, L.L.P. CONSULTING ENGINEERS Dallas, Texas			
DESIGNED BY: <u>P.A.C.</u>	PROJECT: <u>2004-147</u>	SHEET NO. <u>35</u>	
DRAWN BY: <u>B.H.C.</u>	DATE: <u>DECEMBER, 2005</u>	OF <u>35</u> SHEETS	