


REVISED: 11/16/08 - AQUIVAZ  
 H:\Projects\Rockwall\2004\147\Basewgns\Common\southern\_area.dwg  
 PLOT SCALE: 1:2010  
 PLOT STYLE: 11x17.ctb  
 PLOTTED BY: AQUIVAZ ON 11/16/2008

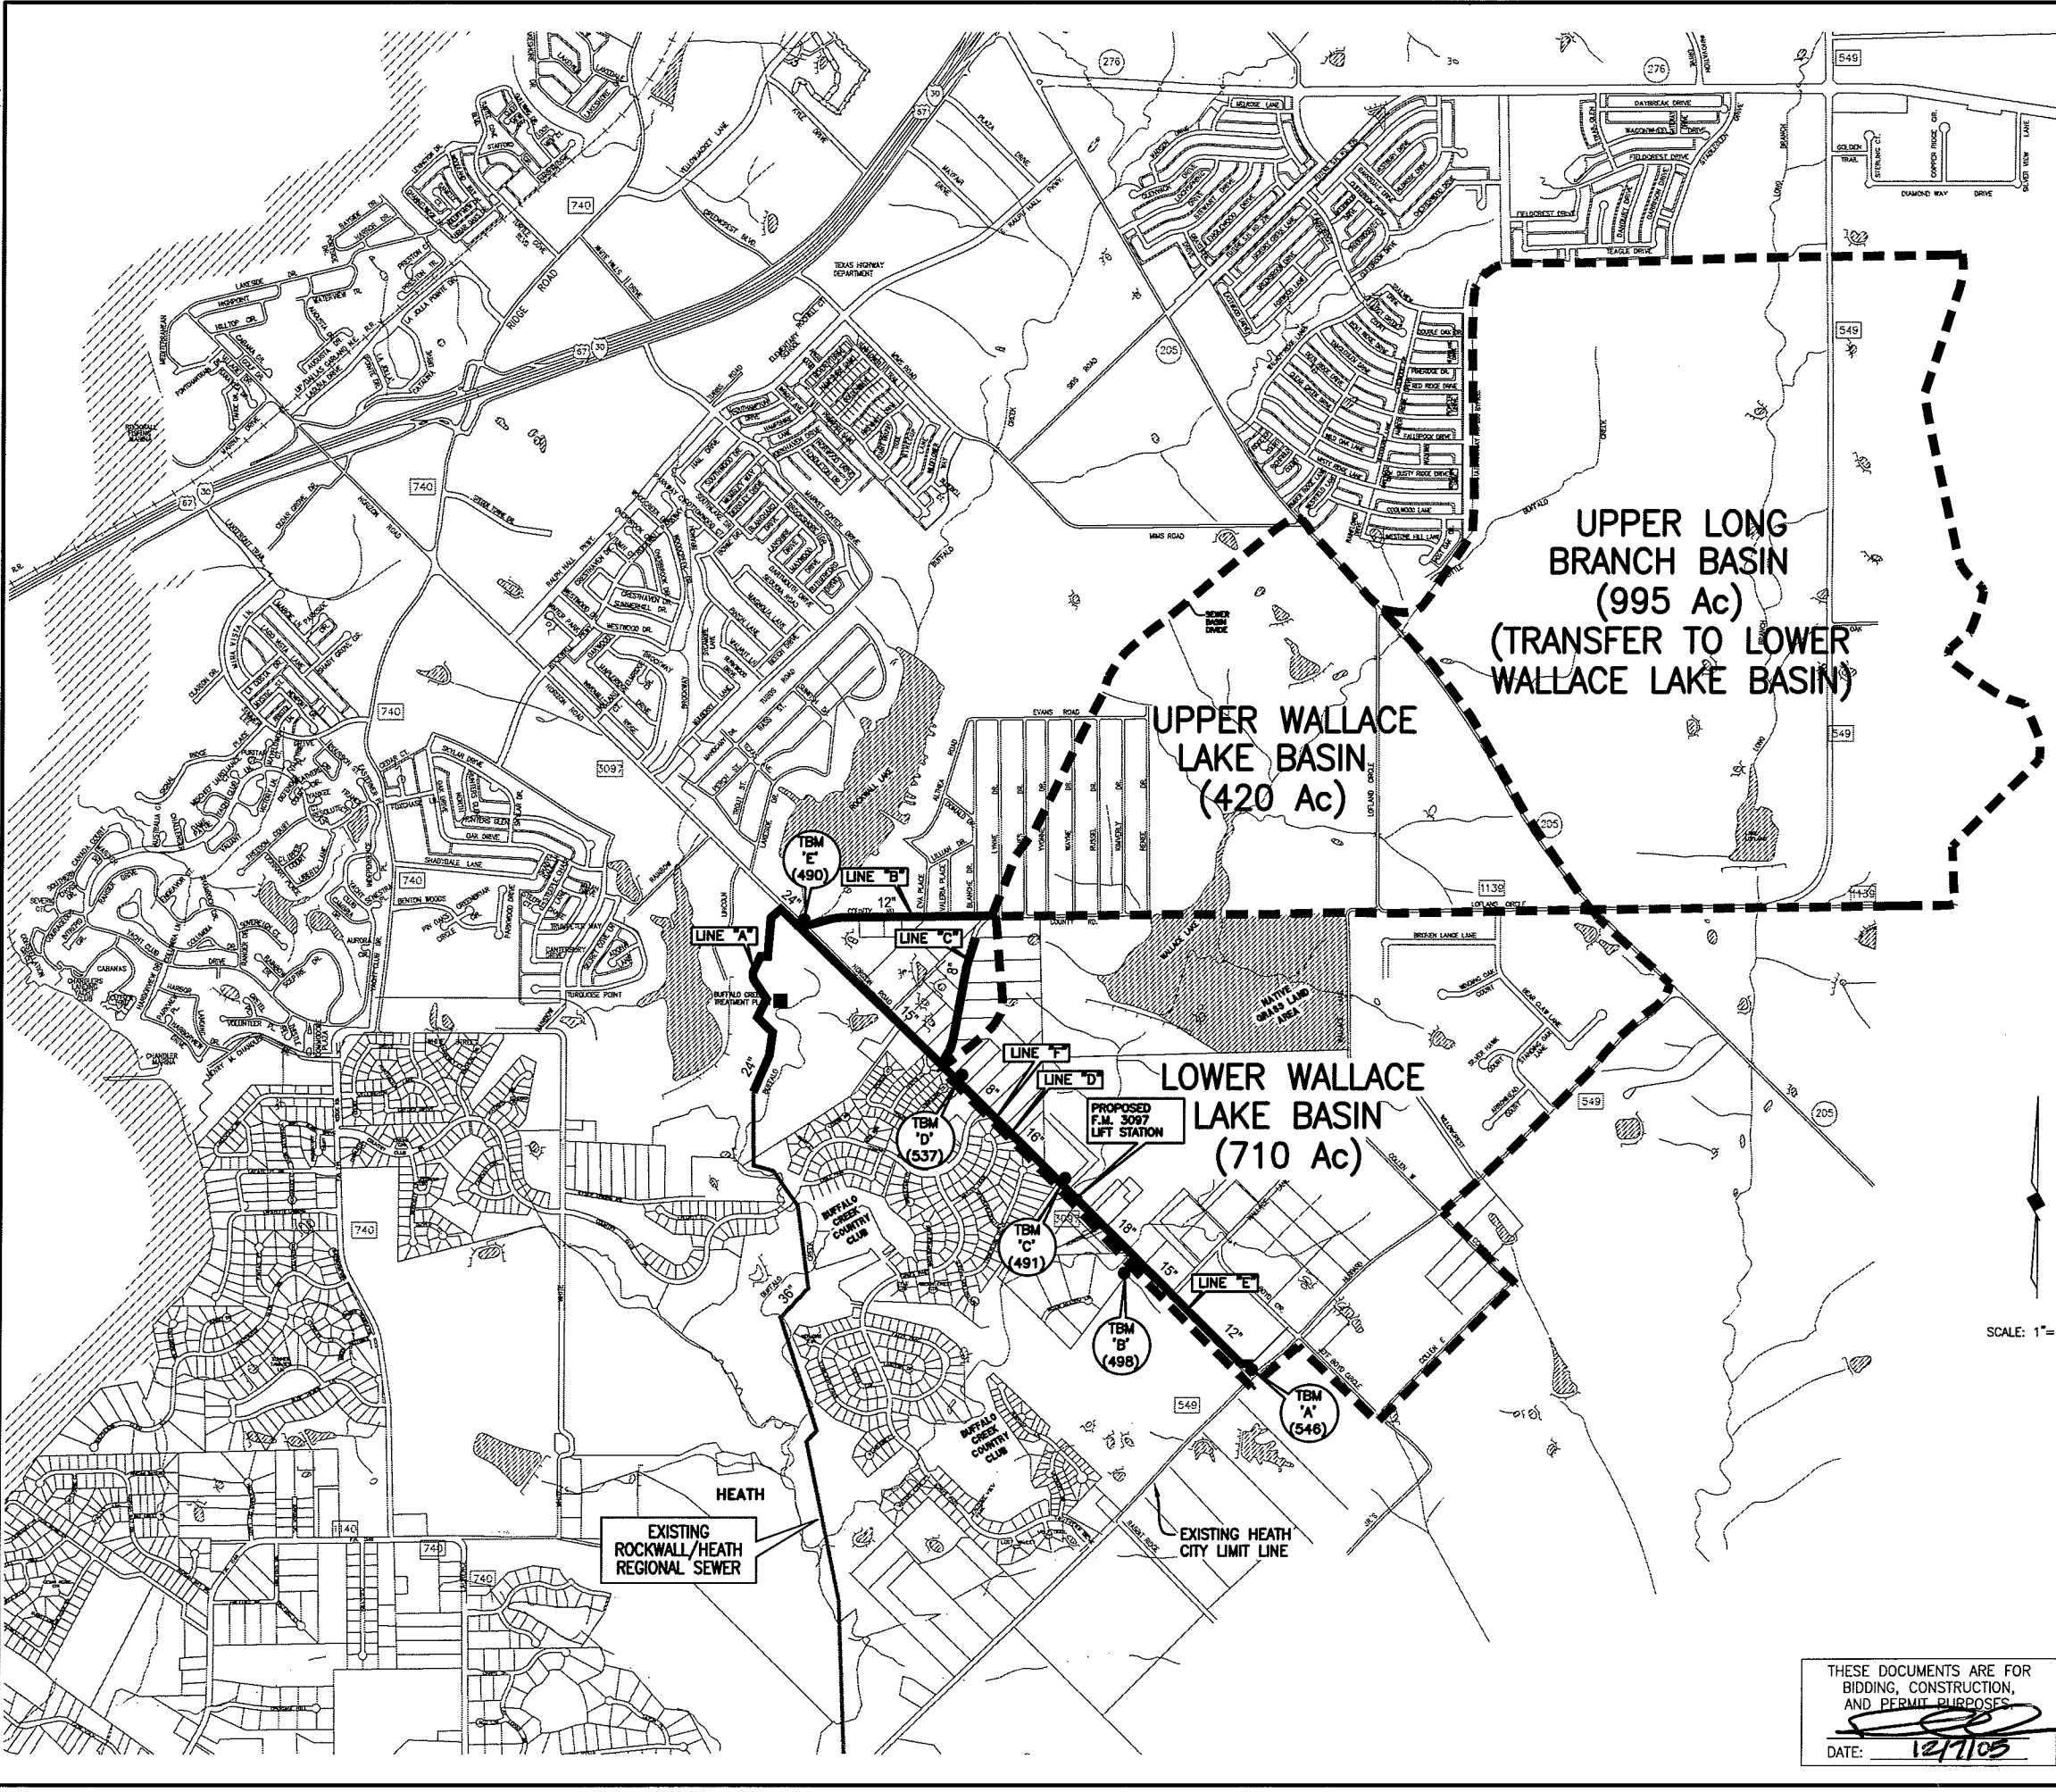

**GENERAL NOTES**

- CONTRACTOR SHALL PROTECT TREES NOT SHOWN TO BE REMOVED.
- THE FOLLOWING PIPE MATERIAL IS ACCEPTABLE FOR THIS PROJECT IN ACCORDANCE WITH NCTCOG STANDARD SPECIFICATIONS & AWWA STANDARD DESIGNATION:
  - GRAVITY SEWER**
    - POLYVINYL CHLORIDE (PVC), NCTCOG ITEM 2.12.14 4" THROUGH 15" DIAMETER - SDR26 DIAMETERS LARGER THAN 15" - SDR35
    - FIBERGLASS REINFORCED PIPE 12" DIAMETER & LARGER PRESSURE CLASS 0, SN 46 ASTM D3262, NCTCOG ITEM 2.12.23 PIPE MANUFACTURER SHALL HAVE A MINIMUM 2-YEARS SUCCESSFUL PRODUCTION IN THE UNITED STATES.
  - FORCE MAIN**
    - POLYVINYL CHLORIDE (PVC), NCTCOG ITEM 2.12.20, AWWA C905 DR 25, CLASS 165.
    - FIBERGLASS REINFORCED PIPE PRESSURE CLASS 150, SN46, ASTM D3754, NCTCOG ITEM 2.12.23 PIPE MANUFACTURER SHALL HAVE A MINIMUM 2-YEARS SUCCESSFUL PRODUCTION IN THE UNITED STATES.

This record drawing is a compilation of the sealed engineering drawing for this project, modified by addenda, change orders and information furnished by the contractor. The information shown on the record drawings that was provided by the contractor or others not associated with the design engineer cannot be verified for accuracy or completeness. This original sealed drawings are on file at the offices of Birkhoff, Hendricks & Conway, L.L.P.  
 BY P.A.C. DATE 11/06/08

These plans and related specifications were prepared for construction of this specific project only. Reuse of these documents is not permitted without written authorization of Birkhoff, Hendricks & Conway, L.L.P.

**CITY OF ROCKWALL, TEXAS**  
**F.M. 3097 SAN. SEW. IMPROVEMENTS**  
**GENERAL NOTES & SERVICE AREA MAP**

**BIRKHOFF, HENDRICKS & CONWAY, L.L.P.**  
 CONSULTING ENGINEERS  
 Dallas, Texas

THESE DOCUMENTS ARE FOR BIDDING, CONSTRUCTION, AND PERMIT PURPOSES.  
 DATE: 12/1/05



DESIGNED BY: P.A.C.	PROJECT: 2004-147	SHEET NO. 1
DRAWN BY: B.H.C.	DATE: DECEMBER, 2005	OF 35 SHEETS