

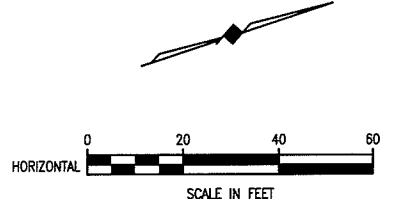


REVISION: 2/27/07 - WHAYS  
 H:\Projects\Rockwall\2004147\Line-C\Sheets\2004147\_PP01.dwg  
 PLOT SCALE: 1:40  
 PLOT STYLE: 11x17.ctb  
 PLOTTED BY: AQUIVAZ ON 11/6/2008

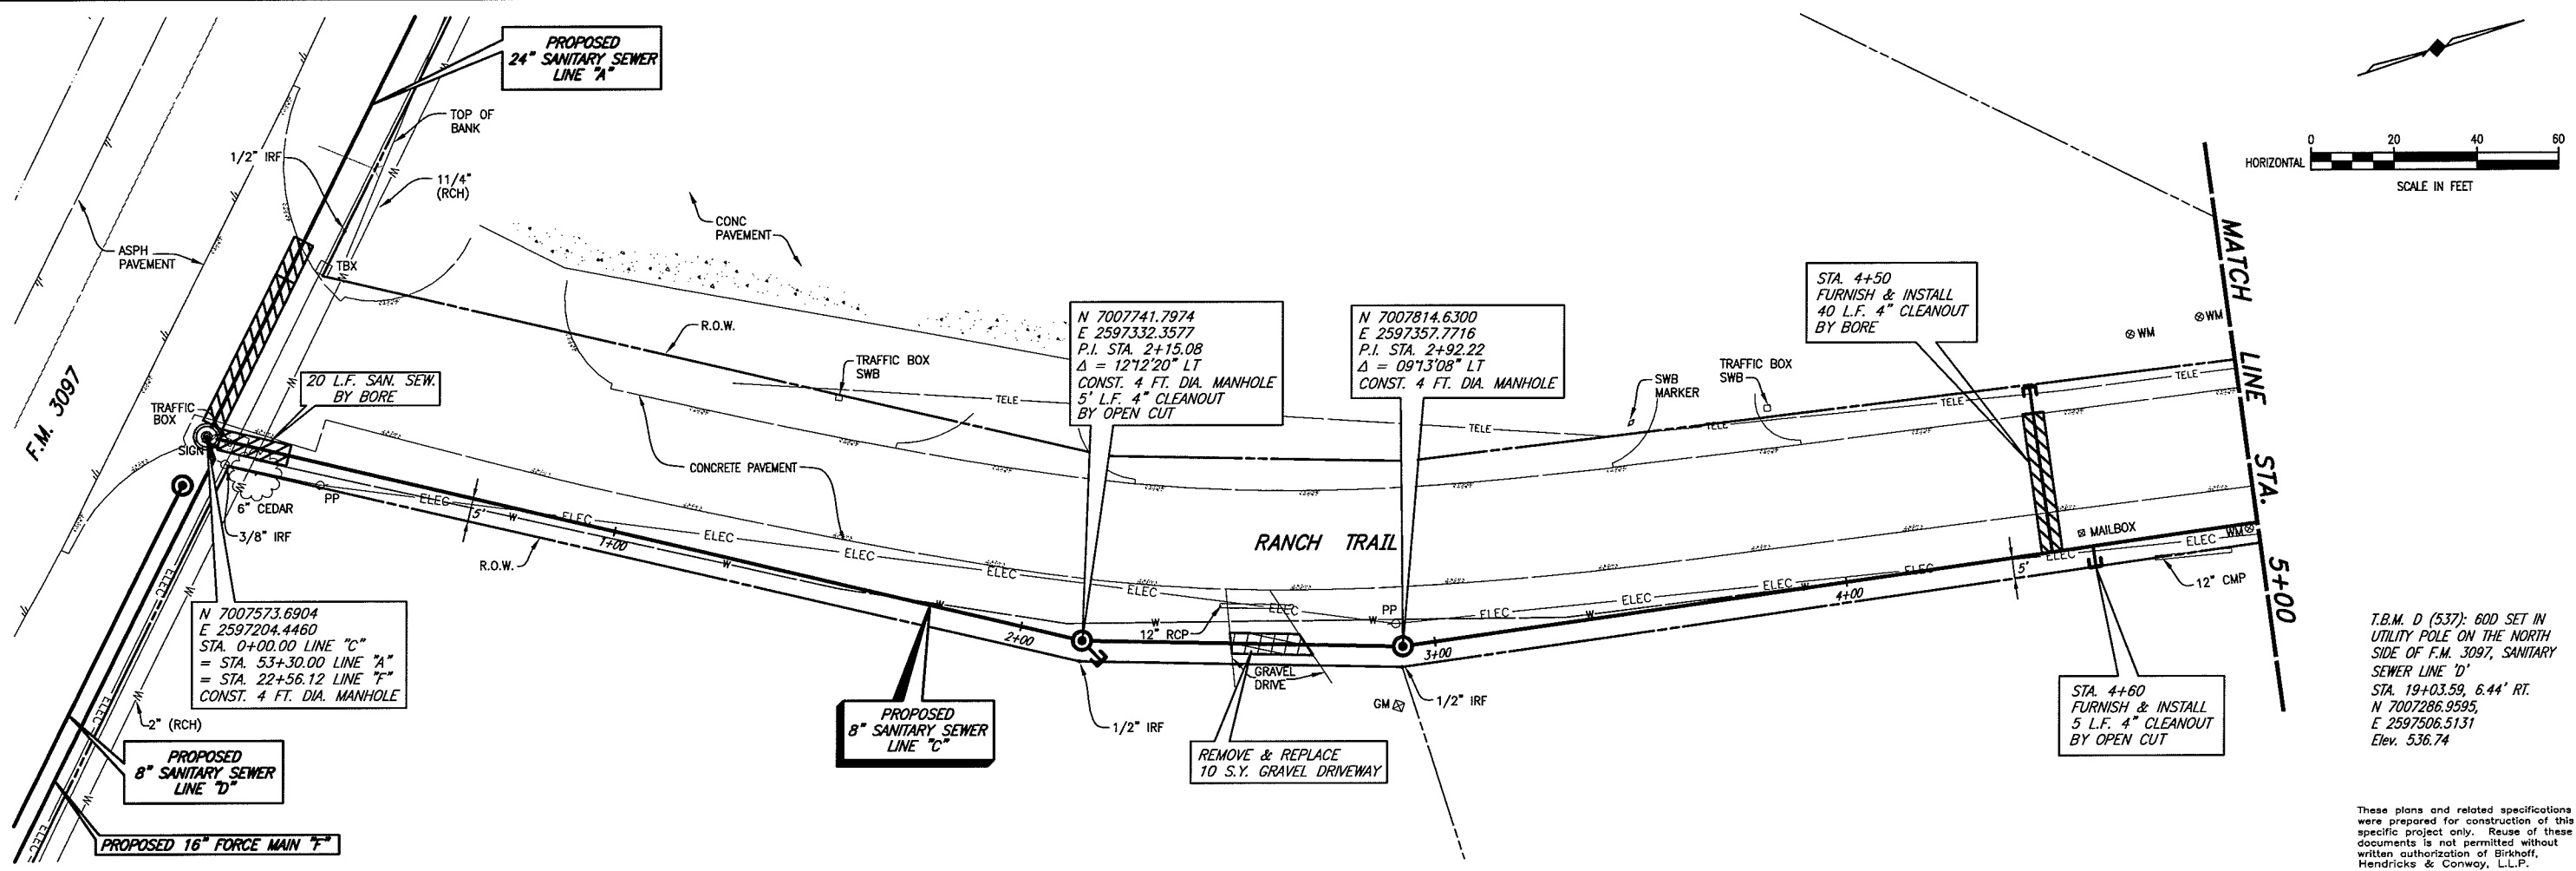

T.B.M. D (537): 60D SET IN UTILITY POLE ON THE NORTH SIDE OF F.M. 3097, SANITARY SEWER LINE "D"  
 STA. 19+03.59, 6.44' RT.  
 N 7007286.9595, E 2597506.5131 Elev. 536.74

These plans and related specifications were prepared for construction of this specific project only. Reuse of these documents is not permitted without written authorization of Birkhoff, Hendricks & Conway, L.L.P.

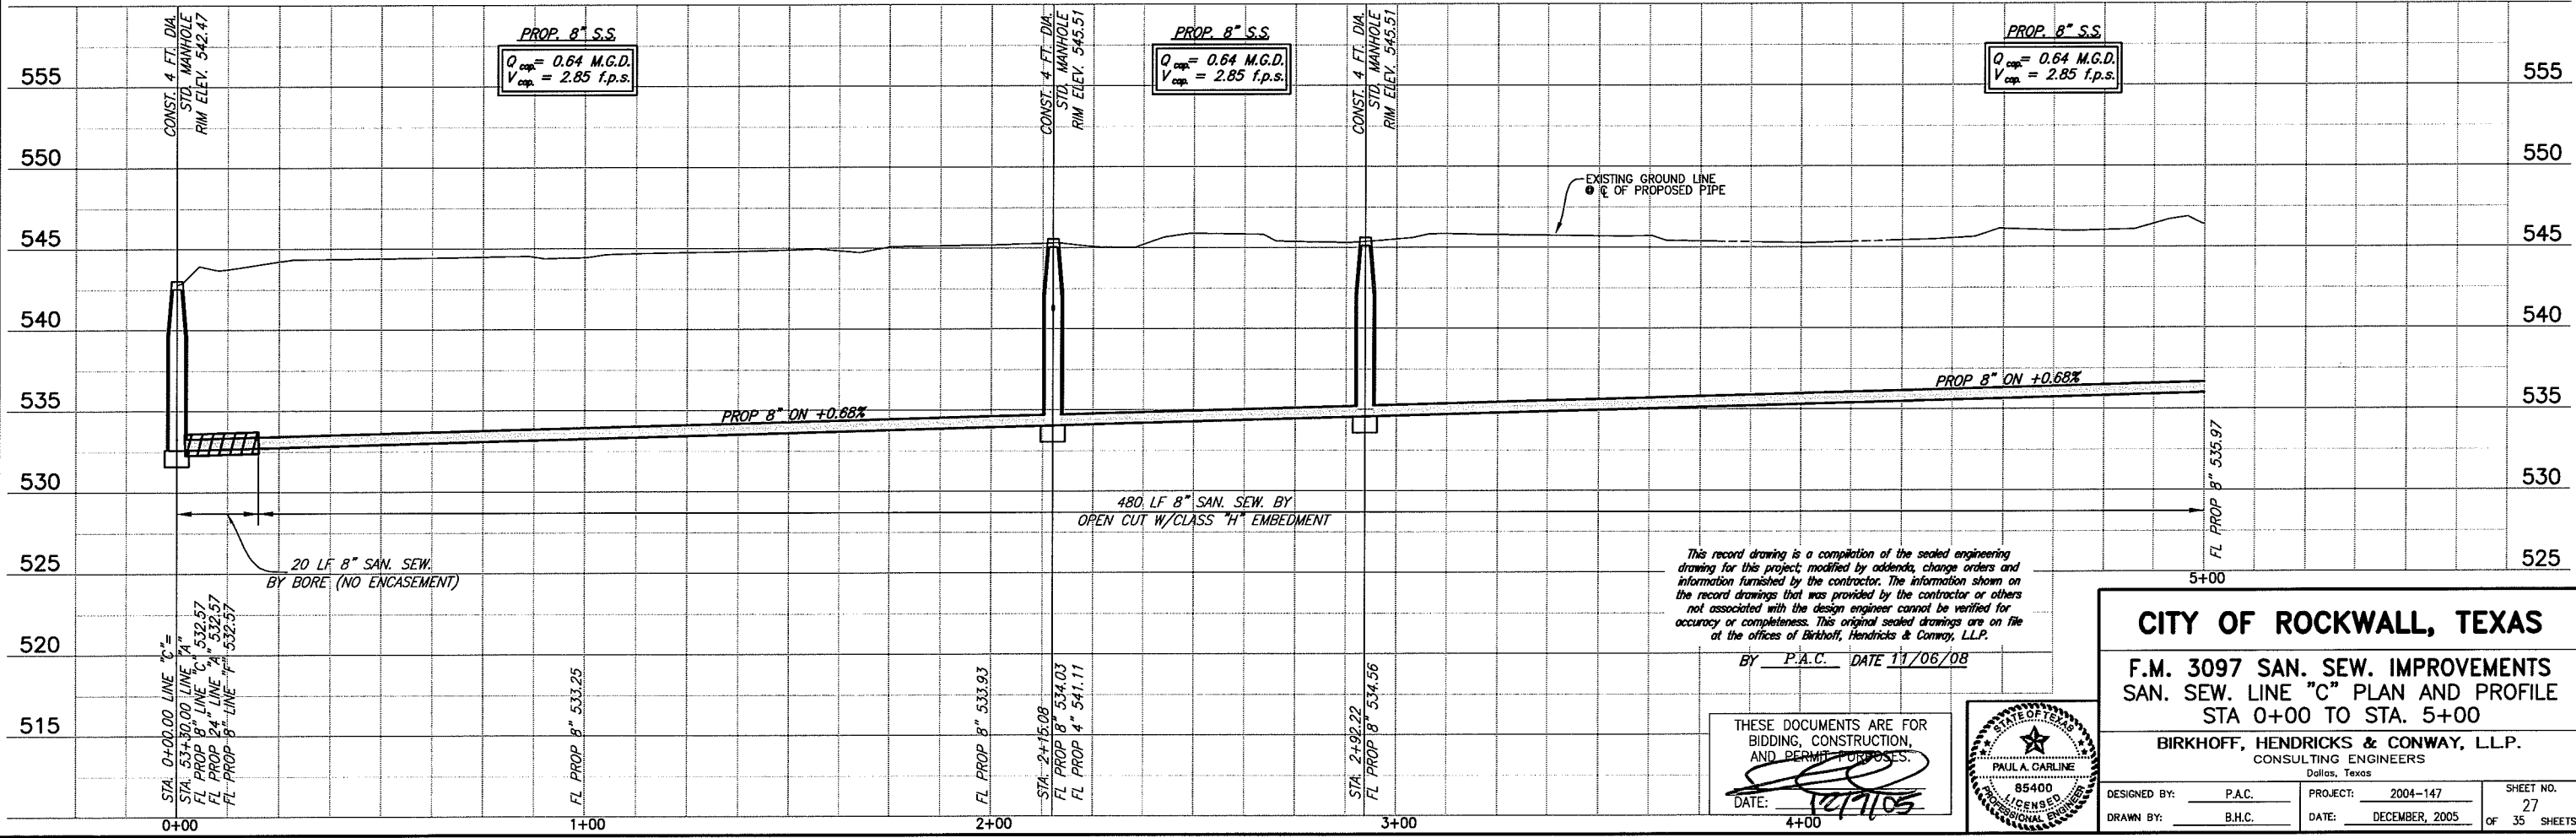

This record drawing is a compilation of the sealed engineering drawing for this project; modified by addenda, change orders and information furnished by the contractor. The information shown on the record drawings that was provided by the contractor or others not associated with the design engineer cannot be verified for accuracy or completeness. This original sealed drawings are on file at the offices of Birkhoff, Hendricks & Conway, L.L.P.

BY P.A.C. DATE 11/06/08

THESE DOCUMENTS ARE FOR BIDDING, CONSTRUCTION, AND PERMIT PURPOSES.  
 DATE: 11/10/08



**CITY OF ROCKWALL, TEXAS**

**F.M. 3097 SAN. SEW. IMPROVEMENTS**  
**SAN. SEW. LINE "C" PLAN AND PROFILE**  
**STA 0+00 TO STA. 5+00**

**BIRKHOFF, HENDRICKS & CONWAY, L.L.P.**  
 CONSULTING ENGINEERS  
 Dallas, Texas

DESIGNED BY: P.A.C.	PROJECT: 2004-147	SHEET NO. 27
DRAWN BY: B.H.C.	DATE: DECEMBER, 2005	OF 35 SHEETS