


CONSTRUCTION PLANS FOR FM 3097 WATERLINE RELOCATIONS (3 LOCATIONS BETWEEN RIDGE RD AND ROCKWALL PKWY) CITY OF ROCKWALL, TEXAS

MAYOR:
DAVID SWEET

CITY MANAGER:
RICK CROWLEY

COUNCIL MEMBERS:

- DAVID WHITE, MAYOR PRO TEM, PLACE 1
- JIM PRUITT, PLACE 2
- BENNIE DANIELS, PLACE 3
- DENNIS LEWIS, PLACE 4
- SCOTT MILDER, PLACE 5
- MIKE TOWNSEND, PLACE 6

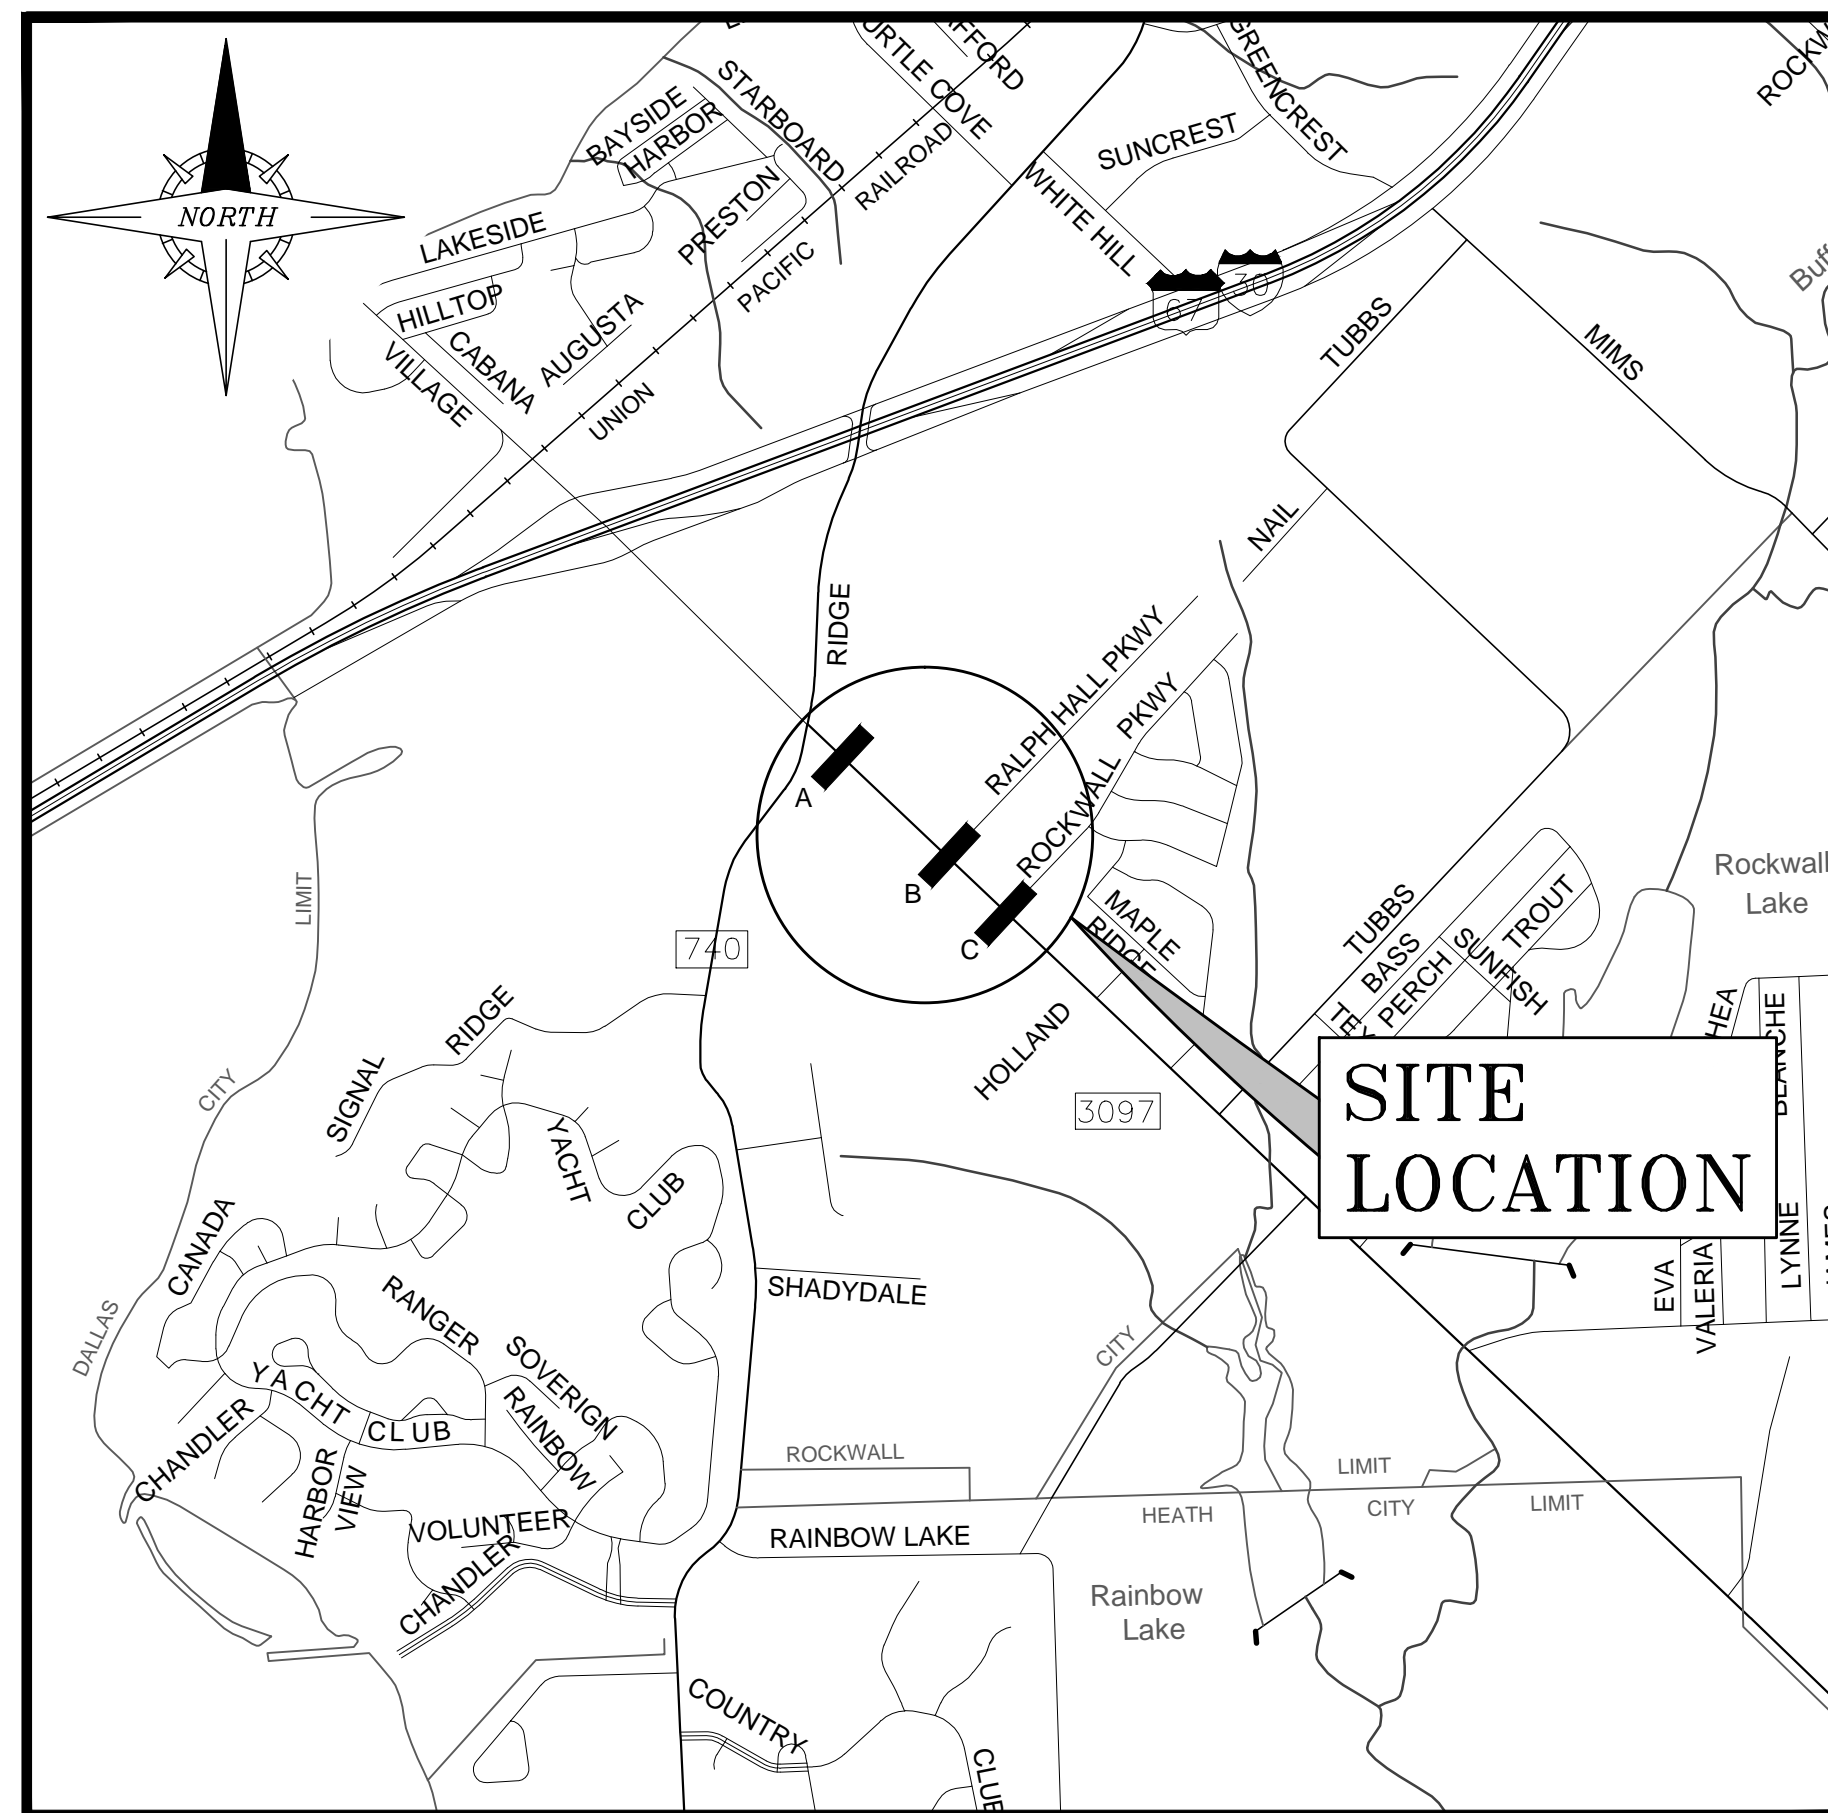

VICINITY MAP
N.T.S.

INDEX OF SHEETS

- 1 COVER SHEET
- 2 GENERAL NOTES
- 3 PROJECT LAYOUT
- 4-5 WATERLINE PLAN & PROFILE

NOTE: ALL CONSTRUCTION SHALL COMPLY WITH THE LATEST CITY OF ROCKWALL DESIGN STANDARDS AND NCTCOG 3RD EDITION SPECIFICATIONS.

RECORD DRAWINGS

THESE PLANS ARE A RECORD SET OF THE CONSTRUCTED PROJECT, AND REFLECT REVISIONS AND CONSTRUCTION-RELATED CHANGES AS MADE BY THE CONTRACTOR. CHANGES MADE FROM THE ORIGINAL CONSTRUCTION DOCUMENTS DO NOT DEPICT ENGINEERING AND ARE NOT THE RESPONSIBILITY OF VERDUNITY, INC. OR THE ENGINEER ON RECORD ON THE ORIGINAL DOCUMENTS. ORIGINAL PLANS RELEASED FOR CONSTRUCTION WERE SEALED BY KEVIN M. SHEPHERD, PE NO. 88642

Engineer:



VERDUNITY, INC.
17000 PRESTON ROAD, SUITE 110
DALLAS, TEXAS 75248
TEXAS FIRM NO. 13496
www.verdunity.com
(214) 425-6720



City of Rockwall
The New Horizon

CITY OF ROCKWALL
ENGINEERING DEPARTMENT
385 S. GOLIAD STREET
ROCKWALL, TX 75087

RECORD DRAWINGS