

NOTE:
 ROADWAY ALIGNMENT, STATIONING AND
 RIGHT-OF-WAY TAKEN FROM TXDOT
 PLANS FOR FM 3097 WIDENING
 PREPARED BY CP&Y DATED NOVEMBER
 2013.

VERDUNITY
A better future, by design.
 17000 Preston Road, Suite 110, Dallas Tx. 75248
 (214)729-8733
 www.verdunity.com
 Texas P.E. Firm Registration No. F-13496

**RECORD
 DRAWINGS**


| ISSUE | DATE | DESCRIPTION |
|-------|------------|-----------------|
| 1 | 10/01/2014 | RECORD DRAWINGS |

DESIGNED BY: DRAWN BY:
 K. GREEN K. GREEN
 CHECKED BY: DATE:
 K. SHEPHERD 9/30/14
 JOB NUMBER: 004-003

RECORD DRAWINGS
 THESE PLANS ARE A RECORD SET OF THE CONSTRUCTED PROJECT, AND REFLECT REVISIONS AND CONSTRUCTION-RELATED CHANGES AS MADE BY THE CONTRACTOR. CHANGES MADE FROM THE ORIGINAL CONSTRUCTION DOCUMENTS DO NOT DEPICT ENGINEERING AND ARE NOT THE RESPONSIBILITY OF VERDUNITY, INC. OR THE ENGINEER ON RECORD ON THE ORIGINAL DOCUMENTS. ORIGINAL PLANS RELEASED FOR CONSTRUCTION WERE SEALED BY KRISTIN D. GREEN, PE NO. 100168


 City of Rockwall
The New Horizon
FM 3097 WATERLINE RELOCATIONS

PROJECT LAYOUT

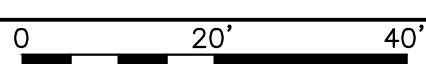

SHEET **03**