
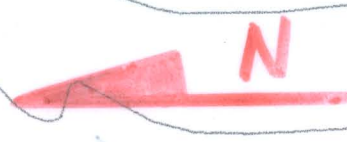


NOTE: 1. EXISTING 6" WATER  
ON EAST SIDE OF FM 549.  
2. VERIFY EXISTING UTILITIES.  
3. MINIMUM COVER IS 48" ON WATERLINE.

F.M. 549 WATERLINE  
EXTENSION

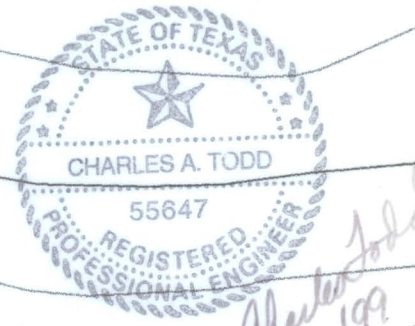

1"=100'