


CITY OF ROCKWALL, TEXAS

CONSTRUCTION PLANS FOR:

780 SERVICE AREA F.M. 549 WATER LINE IMPROVEMENTS



BIRKHOFF, HENDRICKS & CONWAY, L.L.P.
CONSULTING ENGINEERS
Dallas, Texas

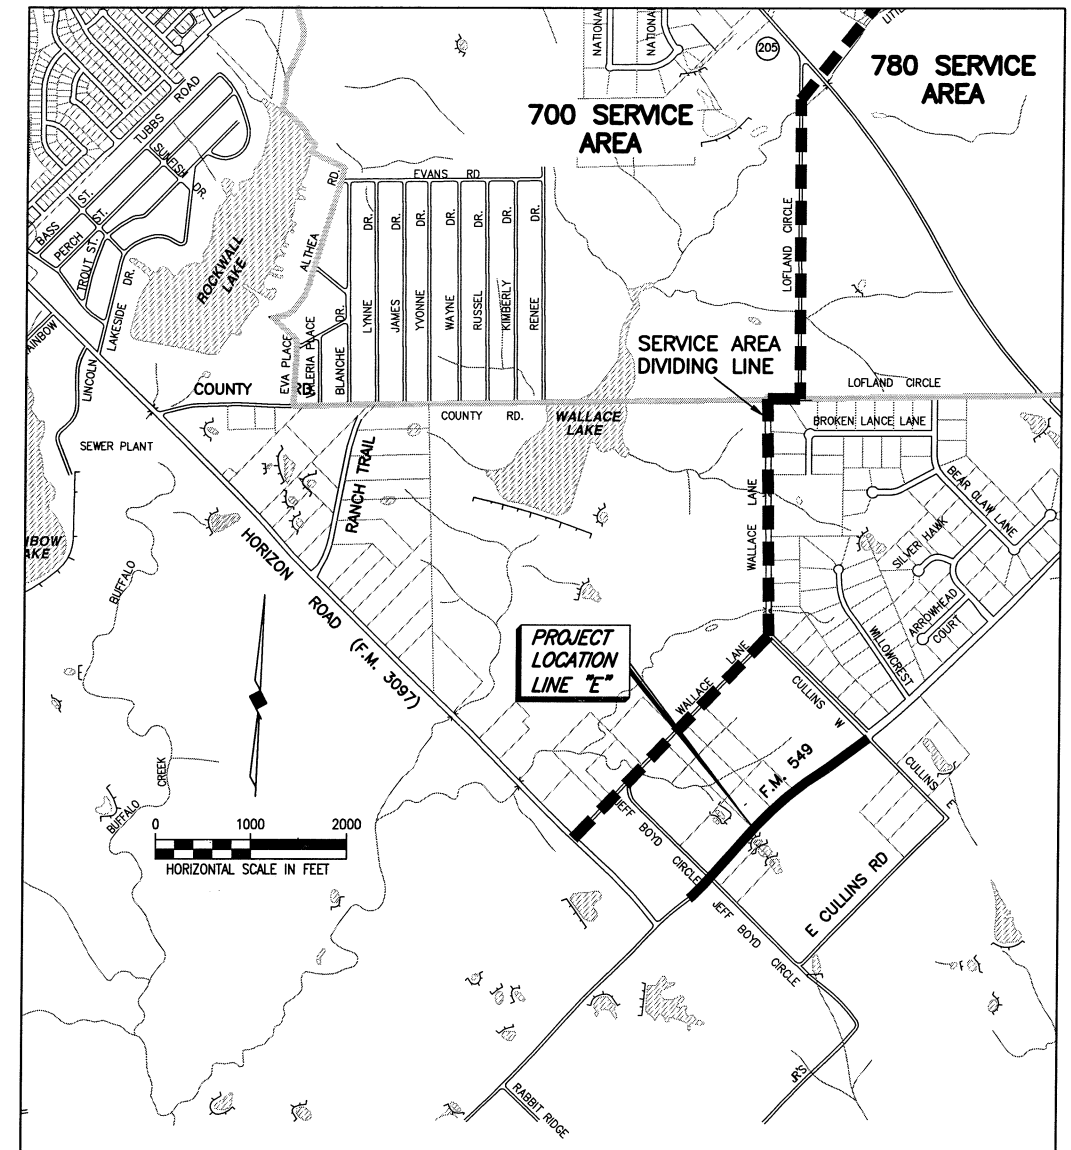

LOCATION MAP

COUNCIL MEMBERS

BILL CECIL, MAYOR
STEPHEN STRAUGHAN, MAYOR PRO-TEM
MATT SCOTT
DAVID SWEET
GLEN FERRIS
MARGO NIELSEN
CLIFFORD "CLIFF" SEVIER

CITY MANAGER


JULIE COUCH

ASSISTANT CITY MANAGER

RICK CROWLEY

CITY ENGINEER

CHUCK TODD, P.E.

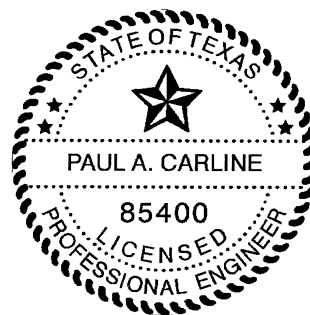

THESE DOCUMENTS ARE FOR
BIDDING, CONSTRUCTION,
AND PERMIT PURPOSES.

DATE: 12/10/07

DECEMBER, 2007

SHEET NO.

-
1-6
7

SHEET DESCRIPTION

COVER SHEET AND LOCATION MAP
LINE A PLAN- PROFILE STA. 0+00 TO STA. 37+74.11
NOTES & DETAILS

This record drawing is a compilation of the sealed engineering drawing for this project; modified by addenda, change orders and information furnished by the contractor. The information shown on the record drawings that was provided by the contractor or others not associated with the design engineer cannot be verified for accuracy or completeness. This original sealed drawings are on file at the offices of Birkhoff, Hendricks & Conway, L.L.P.
BY PAC DATE 11/20/09