


CITY OF ROCKWALL, TEXAS

CONSTRUCTION PLANS FOR: SECTION 1

F.M. 552 WATER LINE IMPROVEMENTS

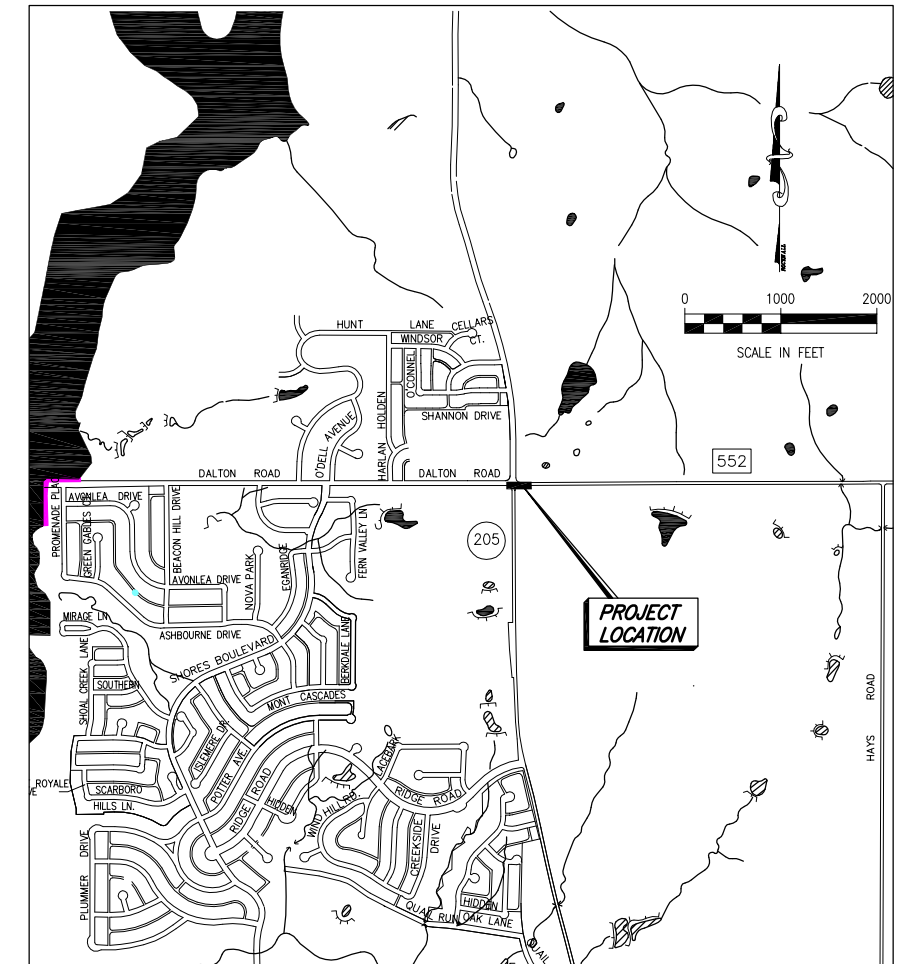

LOCATION MAP

SHEET INDEX

<u>SHEET NO.</u>	<u>SHEET DESCRIPTION</u>
1	COVER SHEET AND LOCATION MAP
2	PLAN- PROFILE STA. 0+10.44 TO STA. 1+83.57
3	DETAILS

COUNCIL MEMBERS

BILL CECIL, MAYOR
MATT SCOTT, MAYOR PRO-TEM
TIM McCALLUM
STEPHEN STRAUGHAN
BOB COTTI
CLIFF SEVIER
MARGO NIELSEN

CITY MANAGER

JULIE COUCH

ASSISTANT CITY MANAGER


RICHARD CROWLEY

CITY ENGINEER

CHUCK TODD, P.E.

This record drawing is a compilation of the sealed engineering drawing for this project; modified by addenda, change orders and information furnished by the contractor. The information shown on the record drawings that was provided by the contractor or others not associated with the design engineer cannot be verified for accuracy or completeness. This original sealed drawings are on file at the offices of Birkhoff, Hendricks & Conway, L.L.P.

BY PAC DATE 08/22/07

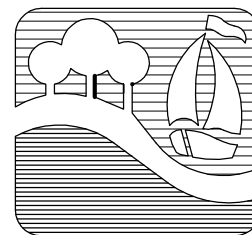

BIRKHOFF, HENDRICKS & CONWAY, L.L.P.
CONSULTING ENGINEERS
Dallas, Texas

JULY, 2006

THESE DOCUMENTS ARE FOR
BIDDING, CONSTRUCTION,
AND PERMIT PURPOSES.

DATE: _____

