
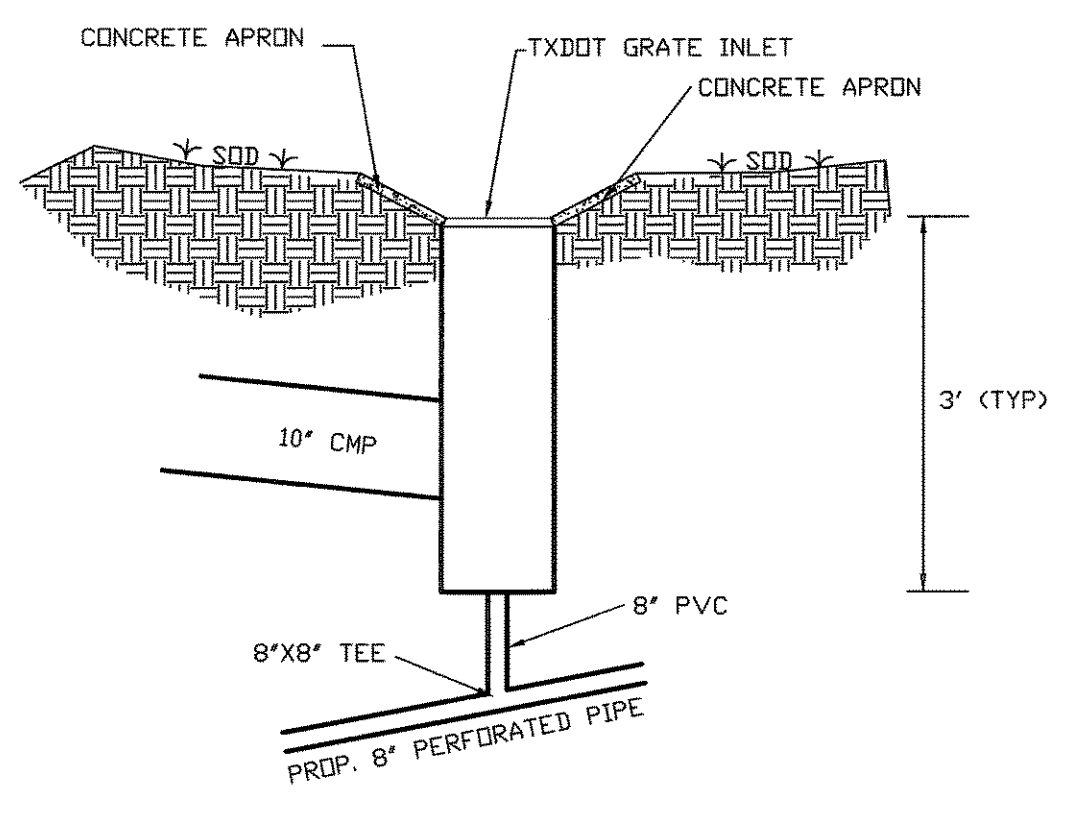
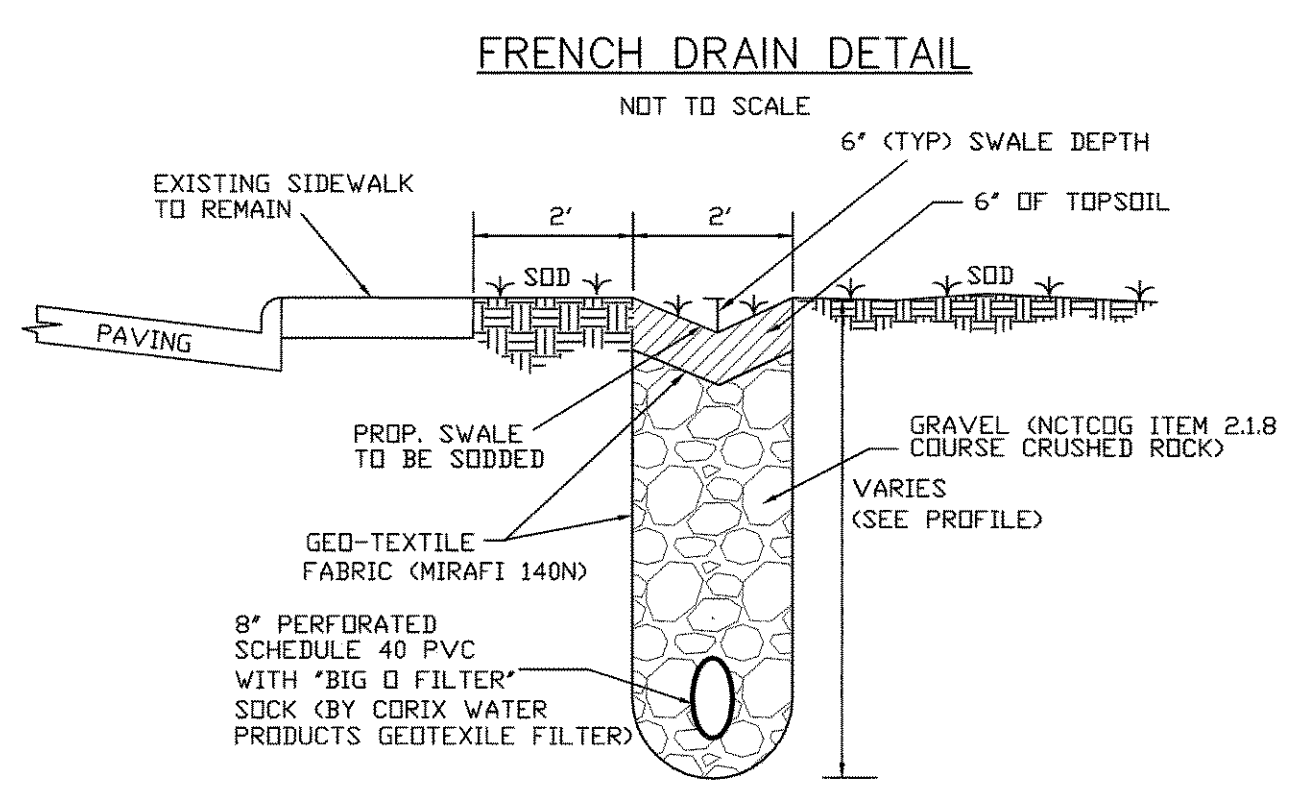


NOTES

- ALL DISTURBED AREAS TO BE SODDED
- CONTRACTOR TO VERIFY ALL EXISTING UTILITIES PRIOR TO CONSTRUCTION
- CONTRACTOR TO PROTECT ALL EXISTING UTILITIES INCLUDING ALL UTILITY SERVICES AND MUST KEEP ALL UTILITIES IN SERVICE
- ALL FILL TO BE COMPACTED TO 95% STD DENSITY
- DURING CONSTRUCTION NO SURFACE WATER TO DRAIN INTO RIDGE ROAD
- CONTRACTOR PROTECT ALL EXISTING TREES
- CONTRACTOR TO SUPPORT WATER SERVICES/METER BOXES (SUBSIDIARY/EXCEPT AS NOTED)
- SWALE SHALL HAVE A MINIMUM OF 1% SLOPE
- SWALE SIDE SLOPE VARIES
- ACCESS TO PROPERTIES TO BE MAINTAINED DURING CONSTRUCTION
- TRAFFIC CONTROL PLAN (IF WORK IN FM-740 IS NEEDED) TO MEET TXDOT STANDARDS (SUBSIDIARY)

- ① FL 10" CMP = 506.0
TOP OF SLOT DRAIN = 507.5
- ② FL 10" CMP = 505.86
TOP OF SLOT DRAIN = 508.6
- ③ FL 10" CMP = 505.8
TOP OF GRATE DRAIN = 507.5
- ④ FL 10" CMP = 509.5
TOP OF GRATE DRAIN = 512.0
- ⑤ FL 10" CMP = 511.0
TOP OF SLOT DRAIN = 513.5
- ⑥ FL 10" CMP = 512.7
TOP OF SLOT DRAIN = 514.2
- ⑦ FL 10" CMP = 518.3
TOP OF SLOT DRAIN = 519.8
- ⑧ FL 10" CMP = 518.0
TOP OF SLOT DRAIN = 520.7
- ⑨ FL 10" CMP = 517.9
TOP OF GRATE DRAIN = 519.8

H'	4	5	6	7	8	9	10	11	12	13	14	15	16	17	18	19	20	H'
Y'	10	12	14	17	19	22	24	27	29	31	34	36	39	41	43	46	48	Y'

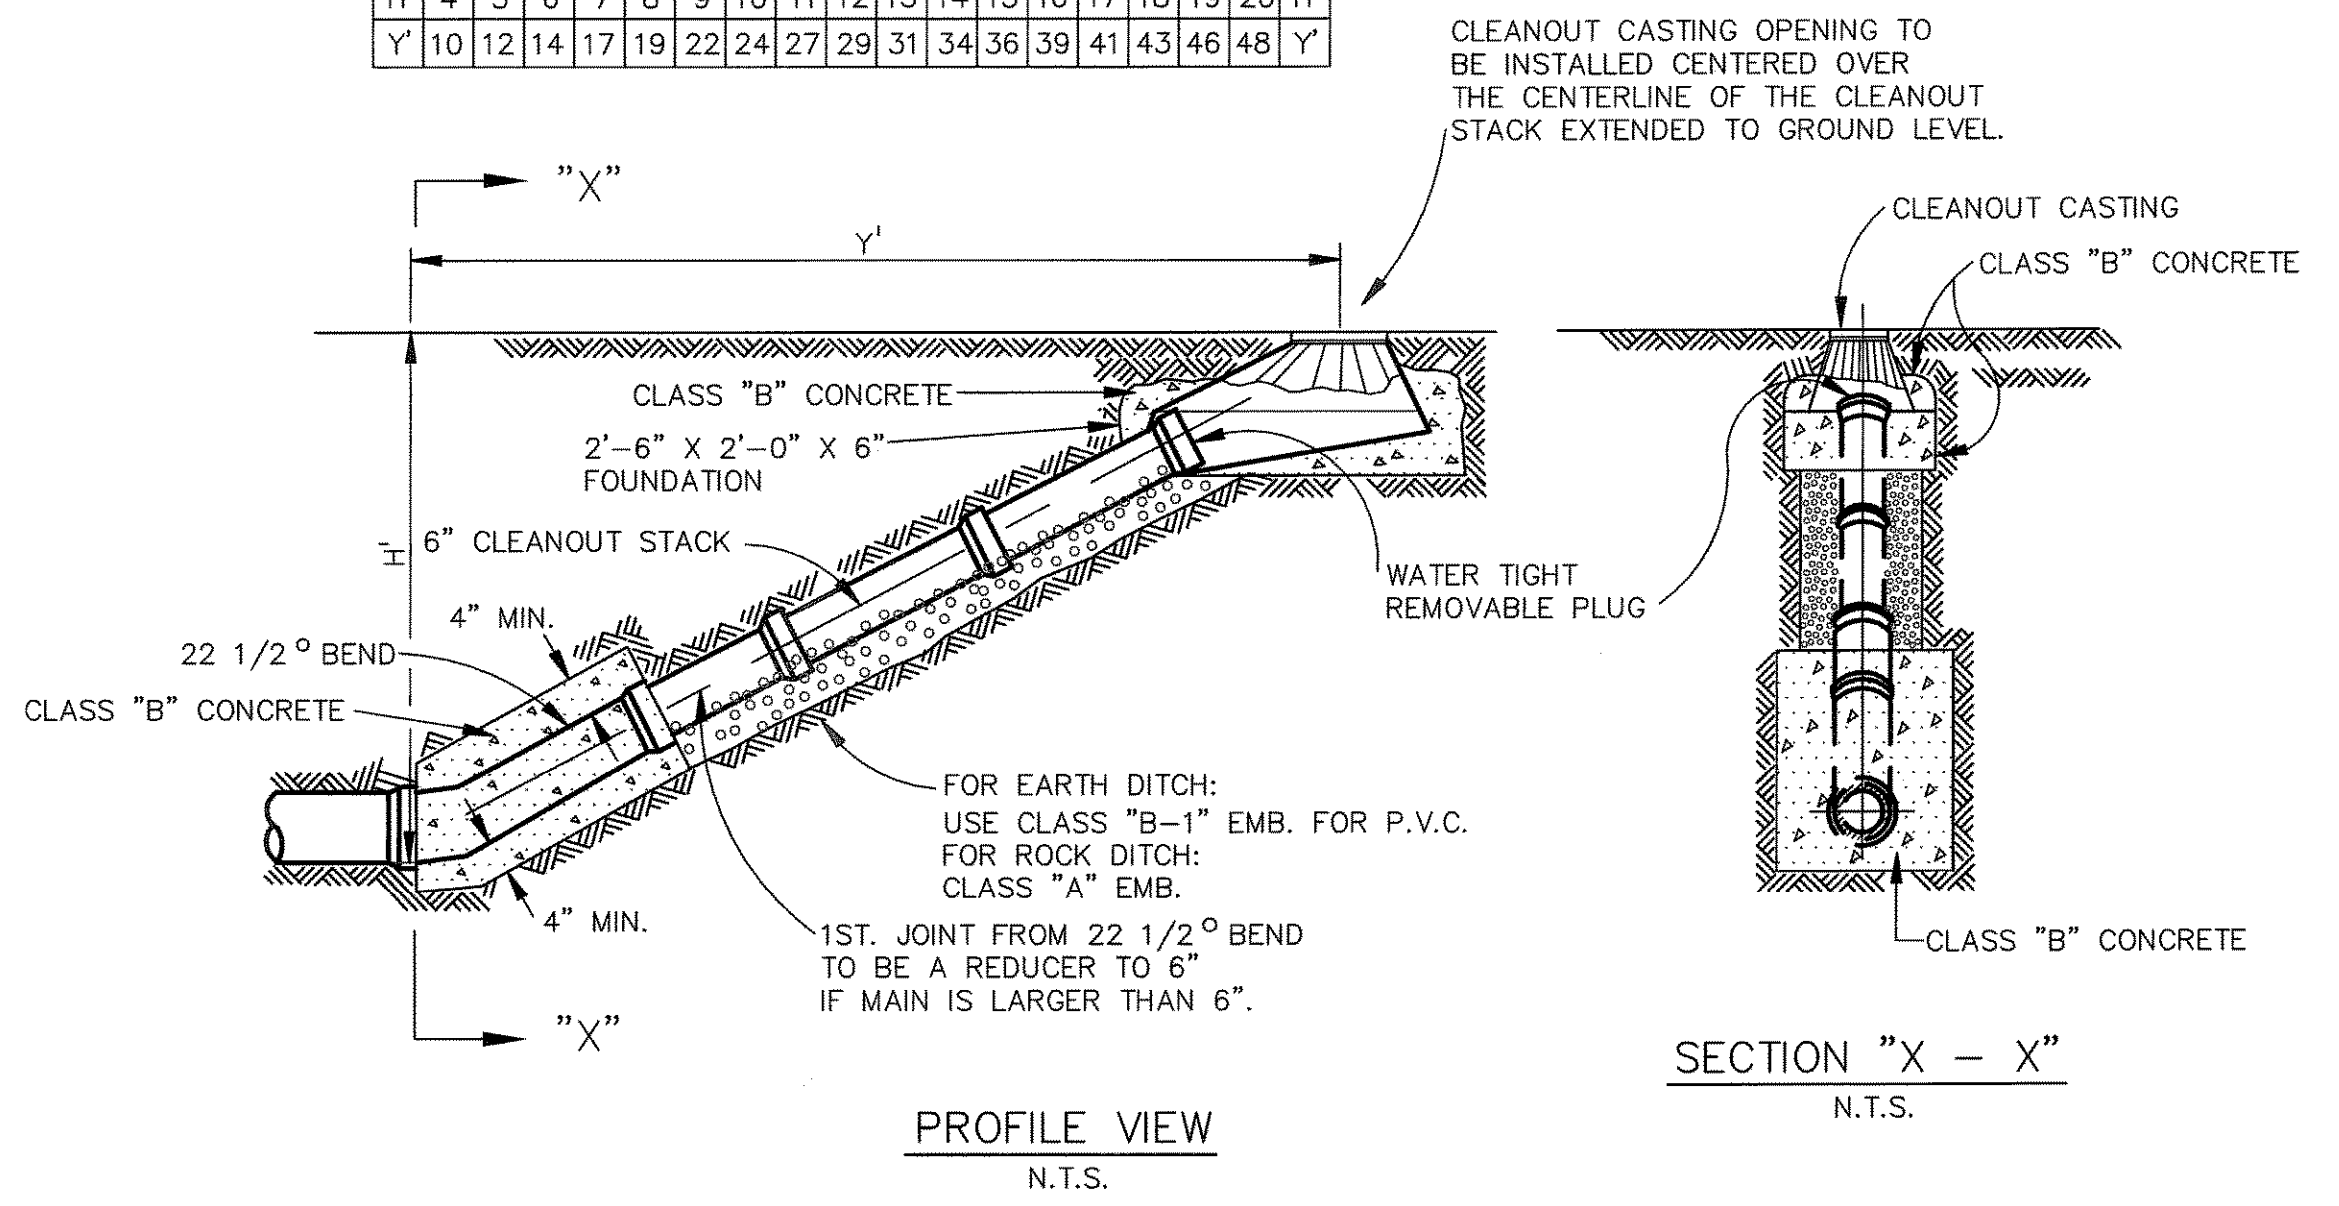

LEGEND

IRF	Iron Rod Found
IRS	Iron Rod Set
PP	Power Pole
GW	Guy Wire
FH	Fire Hydrant
WV	Water Valve
WM	Water Meter
SSMH	Sanitary Sewer Manhole
EM	Electric Meter
A/C	Air Conditioner
LP	Light Pole
CV	Control Valve
CO	Sanitary Sewer Cleanout
CMP	Corrugated Metal Pipe
TMRK	Telephone Marker
TP	Telephone Pedestal
OHE	Overhead Electric
TMH	Telephone Manhole
SS	Sanitary Sewer Line
W	Water Line
UE	Underground Electric
C	Conduit
GAS	Gas Line
TSB	Traffic Signal Box
SP	Sign Pole
FL	Flow Line of Proposed Swale

**FM 740 PARKWAY DRAINAGE
PLAN SHEET**

ROCKWALL, TEXAS

CITY OF ROCKWALL
"THE NEW HORIZON"

DESIGNED:	A.J.W.	THE SEAL APPEARING ON THIS DOCUMENT WAS AUTHORIZED BY AMY J. WILLIAMS TEXAS P.E.
DRAWN:	ACAD	NO. 99406 ON
JOB NO.		DATE: 9/16/2010 SHEET NO. 1

REVISION NO.	REMARKS	DATE