

CITY OF ROCKWALL

"THE NEW HORIZON"

FM 740

WATER & WASTEWATER IMPROVEMENTS

MAYOR

Bill Cecil

CITY COUNCIL

David Sweet


Mark Russo

Glen Ferris

Cliff Sevier

Matt Scott

Margo Nielsen

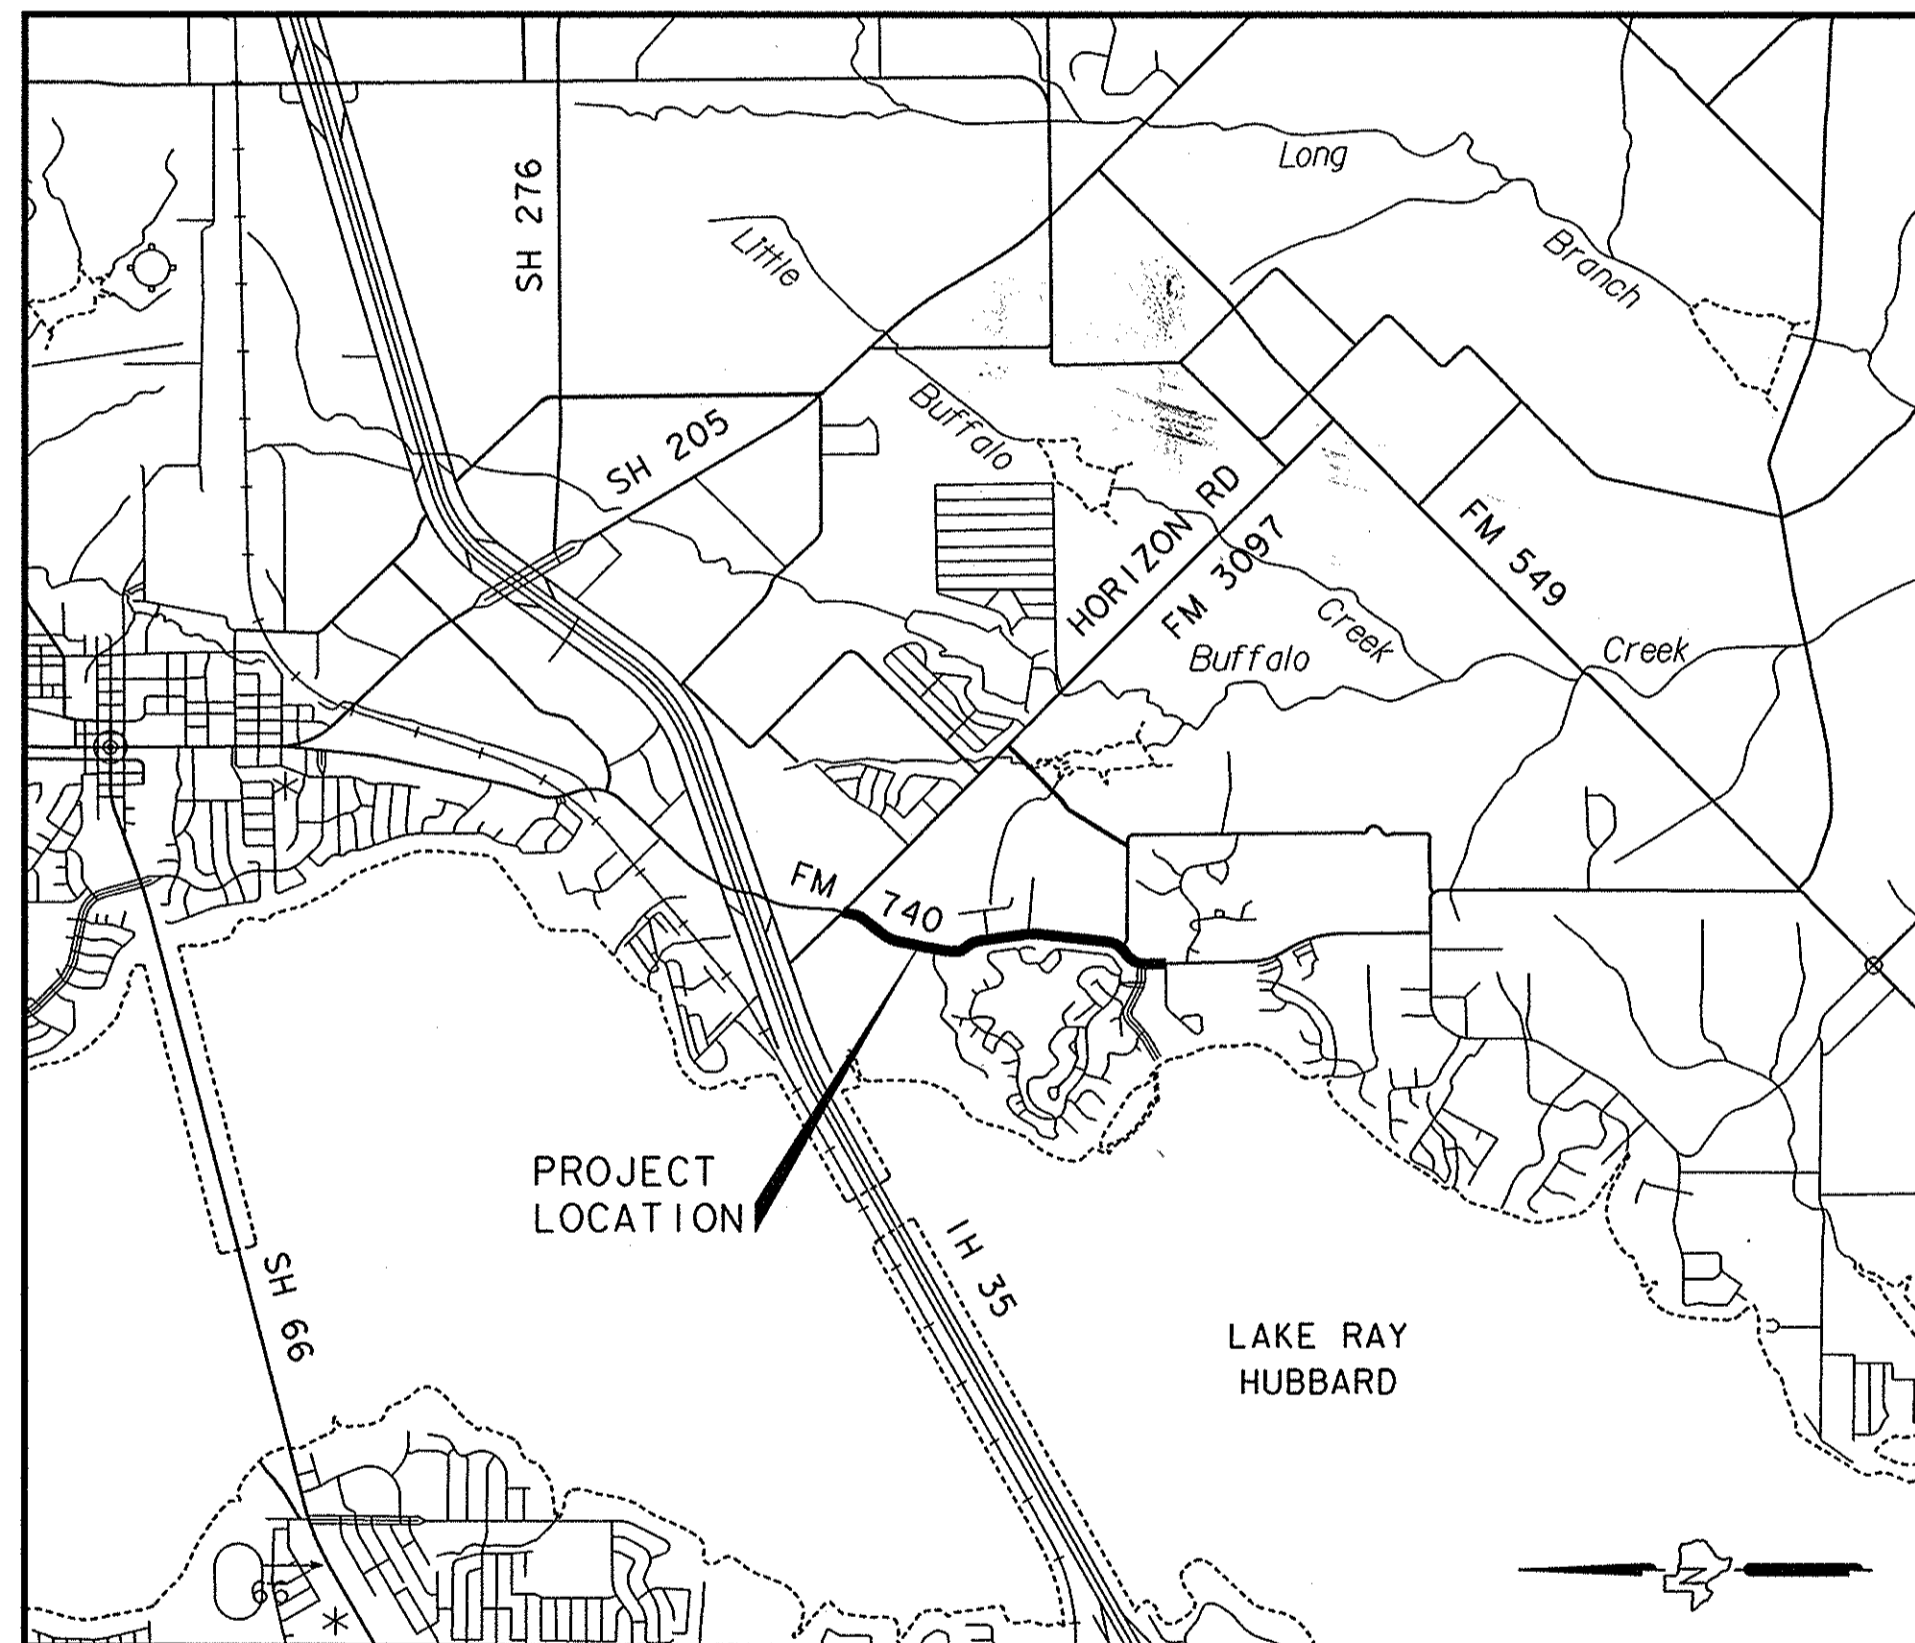

CONTRACTOR SHALL OBTAIN COPIES OF THE LATEST CITY OF ROCKWALL STANDARD DETAILS AND NORTH CENTRAL TEXAS COUNCIL OF GOVERNMENT STANDARD SPECIFICATIONS FOR PUBLIC WORKS CONSTRUCTION WITH ROCKWALL AMENDMENTS. CONTRACTOR SHALL HAVE ONE COPY ON THE PROJECT AT ALL TIMES.

INDEX OF DRAWINGS

SHEET NO.	TITLE
1	COVER SHEET
2	QUANTITY SUMMARY
3	GENERAL NOTES
4-7	HORIZONTAL CONTROL
8-23	WATER PLAN & PROFILE
24	WATER CROSSING PROFILES
25	WASTEWATER PROFILES
26	8" WATER AT PARKWOOD DR

RECORD DRAWINGS AUGUST 13, 2010 *KAR*
THIS RECORD DOCUMENT HAS BEEN PREPARED BASED ON INFORMATION PROVIDED BY OTHERS. THE CONSULTANT HAS NOT VERIFIED THE ACCURACY AND/OR COMPLETENESS OF THIS INFORMATION AND SHALL NOT BE RESPONSIBLE FOR ANY ERRORS OR OMISSIONS THAT MAY BE INCORPORATED AS A RESULT OF ERRONEOUS INFORMATION PROVIDED BY OTHERS.



ROCKWALL, TEXAS

OWNER:

CITY OF ROCKWALL
ENGINEERING DEPARTMENT
385 SOUTH GOLIAD
ROCKWALL, TEXAS 75087
(972) 771-7746

ENGINEER:

HUITT-ZOLLARS

HUITT-ZOLLARS, INC.
3131 MCKINNEY AVE., SUITE 600
DALLAS, TEXAS 75204
(214) 871-3311

THE SEAL APPEARING ON THIS DOCUMENT WAS AUTHORIZED BY KENNETH A. ROBERTS, P.E. 55446 ON AUGUST 24, 2009



FIRM REGISTRATION NO. F-761