


OWNER: KROGER TEXAS LP

OWNER: REGENCY CENTERS LP

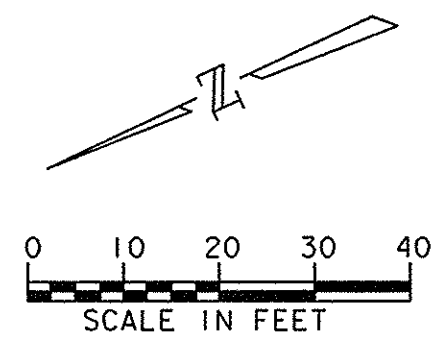

PAV. STA 27+21.55,
39.00' RT., 16" WATER
INSTALL:
1- 1" SERVICE OUTLET
11 L.F. 1" SERVICE PIPE
CONNECT TO EX. SERVICE

CURVE DATA
16" WATER
Δ = 2° 51' 55"
R = 1239.00'
T = 30.99'
L = 61.96'

PROP. 16" WATER
CUT & PLUG EX. WATER

PAV. STA 27+13.92,
39.00' RT., 16" WATER
INSTALL:
1- 1" SERVICE OUTLET
11 L.F. 1" SERVICE PIPE
CONNECT TO EX. SERVICE

PAV. STA 27+32.19,
39.00' RT., 16" WATER
INSTALL:
1- 16" 45° COMB. BEND
CONC. BLOCKING
CONNECT TO EX. 16"

PAV. STA 27+38.93,
32.55' RT., 16" WATER
INSTALL:
1- 16" 45° COMB. BEND
CONC. BLOCKING
CONNECT TO EX. 16"

OWNER: ROBERT J. HUGHES,
& PATRICK HUGHES
& SANDRA FERGUSON


INSTALL 50 LF CONC
ENCASEMENT AROUND
EX. 16" WATER MAIN

OWNER: MICHAEL SEALOCK
& KAY SONIA


OWNER: LISA K. ATTAWAY

MATCH LINE STA 27+00

MATCH LINE STA 31+50

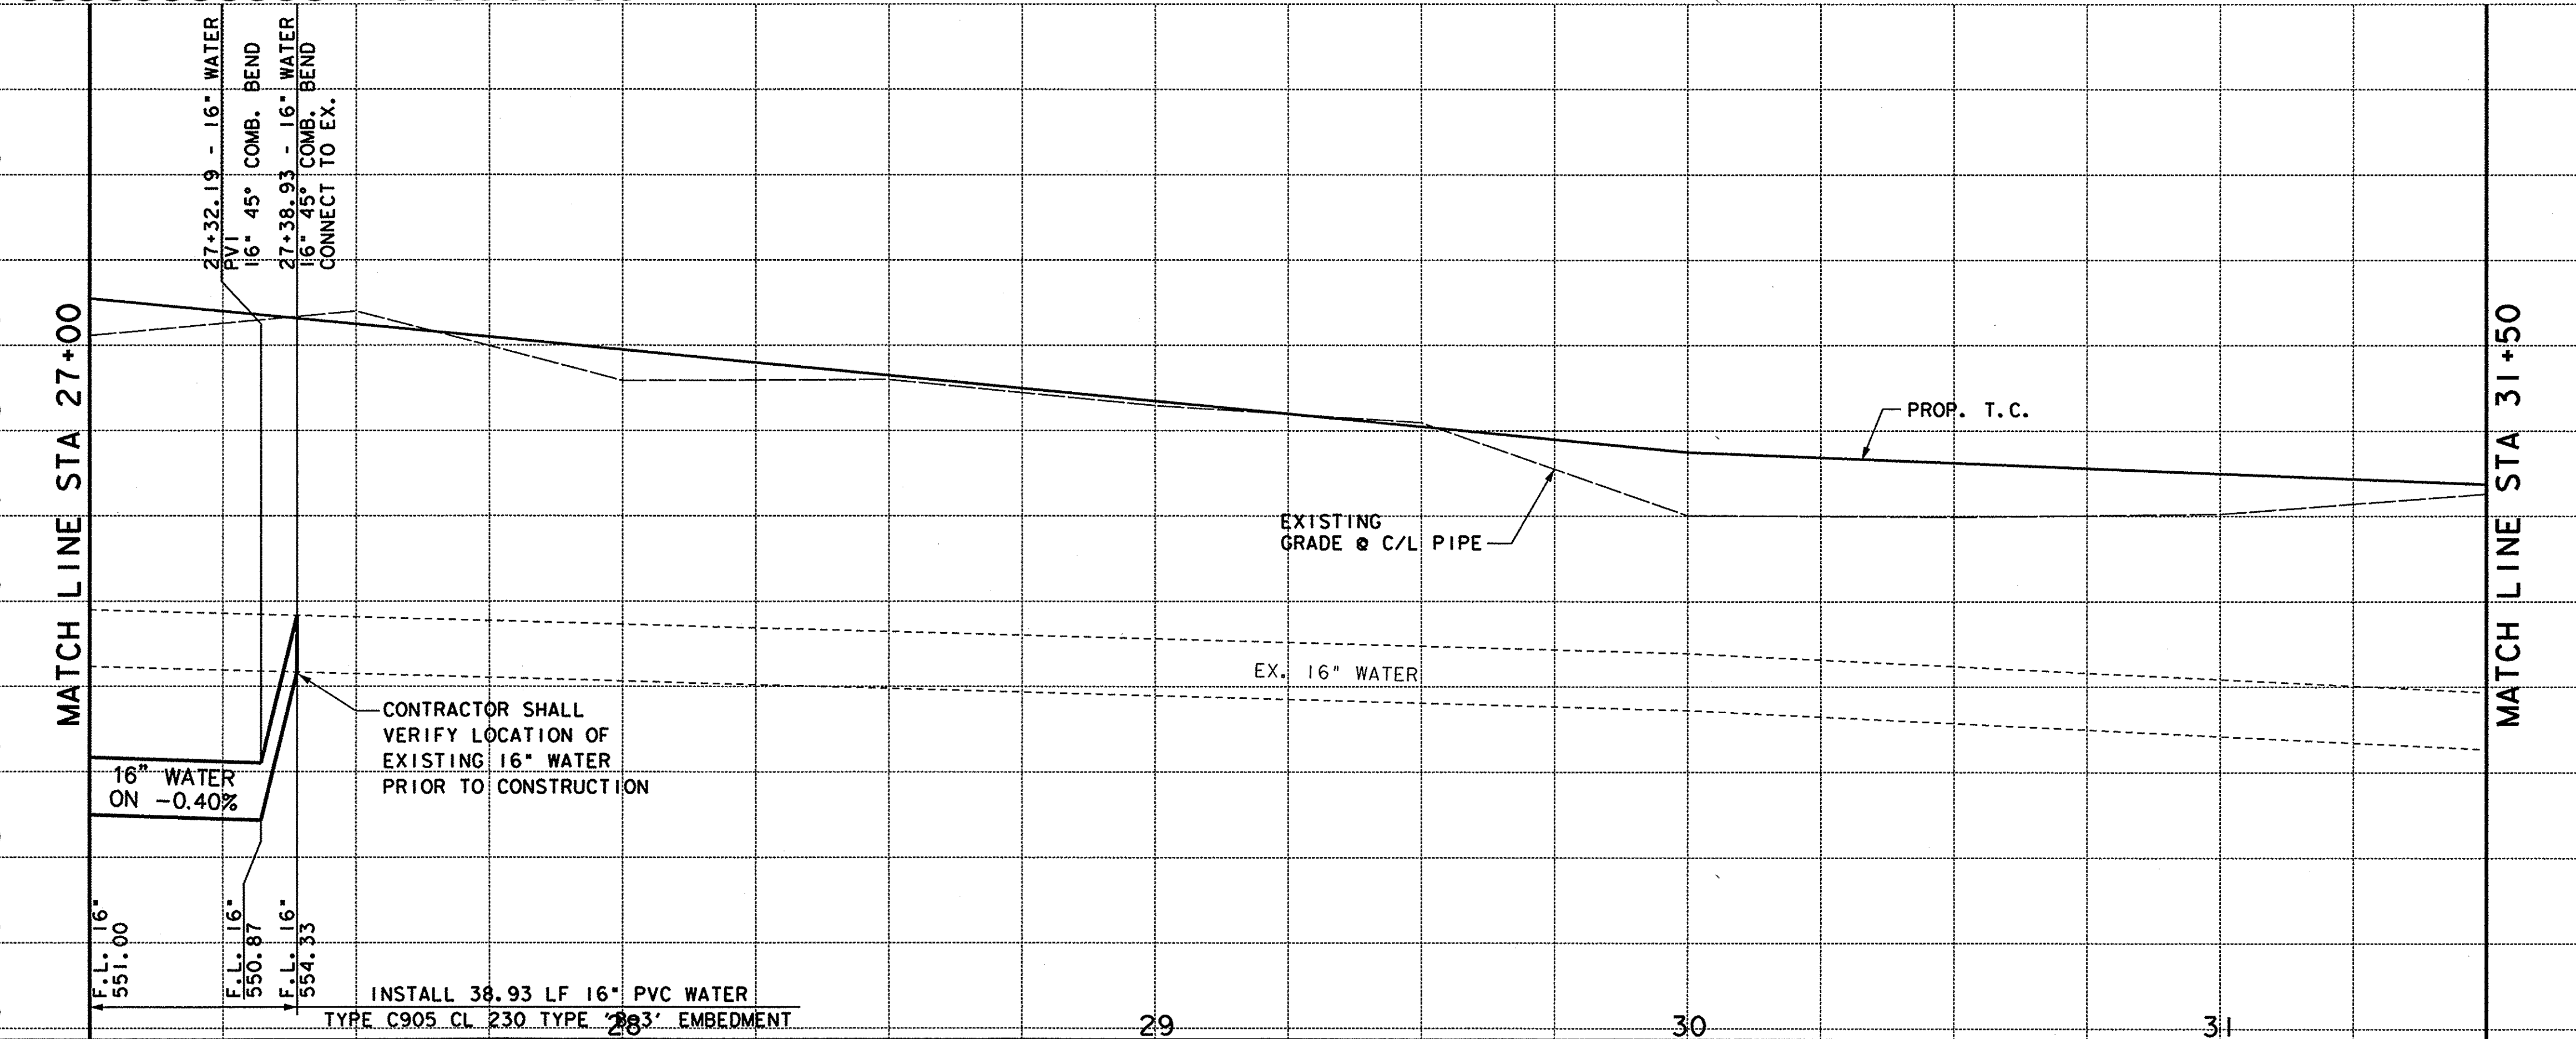

THE SEAL APPEARING ON THIS DOCUMENT WAS AUTHORIZED BY KENNETH A. ROBERTS, P.E., 55446 ON AUGUST 24, 2009

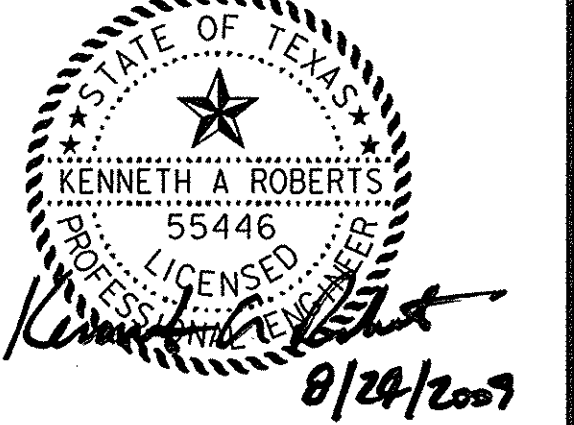

FIRM REGISTRATION NO. F-761

RECORD DRAWINGS AUGUST 13, 2010
THIS RECORD DOCUMENT HAS BEEN PREPARED BASED ON INFORMATION PROVIDED BY OTHERS. THE CONSULTANT HAS NOT VERIFIED THE ACCURACY AND/OR COMPLETENESS OF THIS INFORMATION AND SHALL NOT BE RESPONSIBLE FOR ANY ERRORS OR OMISSIONS THAT MAY BE INCORPORATED AS A RESULT OF ERRONEOUS INFORMATION PROVIDED BY OTHERS.

FM 740

WATER PLAN & PROFILE

STA 27+00 TO STA 31+50

HORIZON ROAD TO WELLINGTON LANE

HUNT-ZOLLARS Hunt-Zollars, Inc. Reg. No. F-761
3131 McKinney Avenue, Suite 600
Dallas, Texas 75204-2489
Phone (214) 871-3311 Fax (214) 871-0757

CITY OF ROCKWALL, TEXAS

DESIGN	DRAWN	APPR.	SCALE	DATE	PROJECT NO.	NO.
HZI	HZI	KAR	H: 1"=20' V: 1"=2.5'	AUGUST 2009	01-3713-01	10

USER: THERESA
SCALE: SCALE=50, 00000
FILE: V8HWITFULL.TBL

1:\p\proj\01371301\dgn\371301\UW03.DGN 8/13/2010 10:52:27