
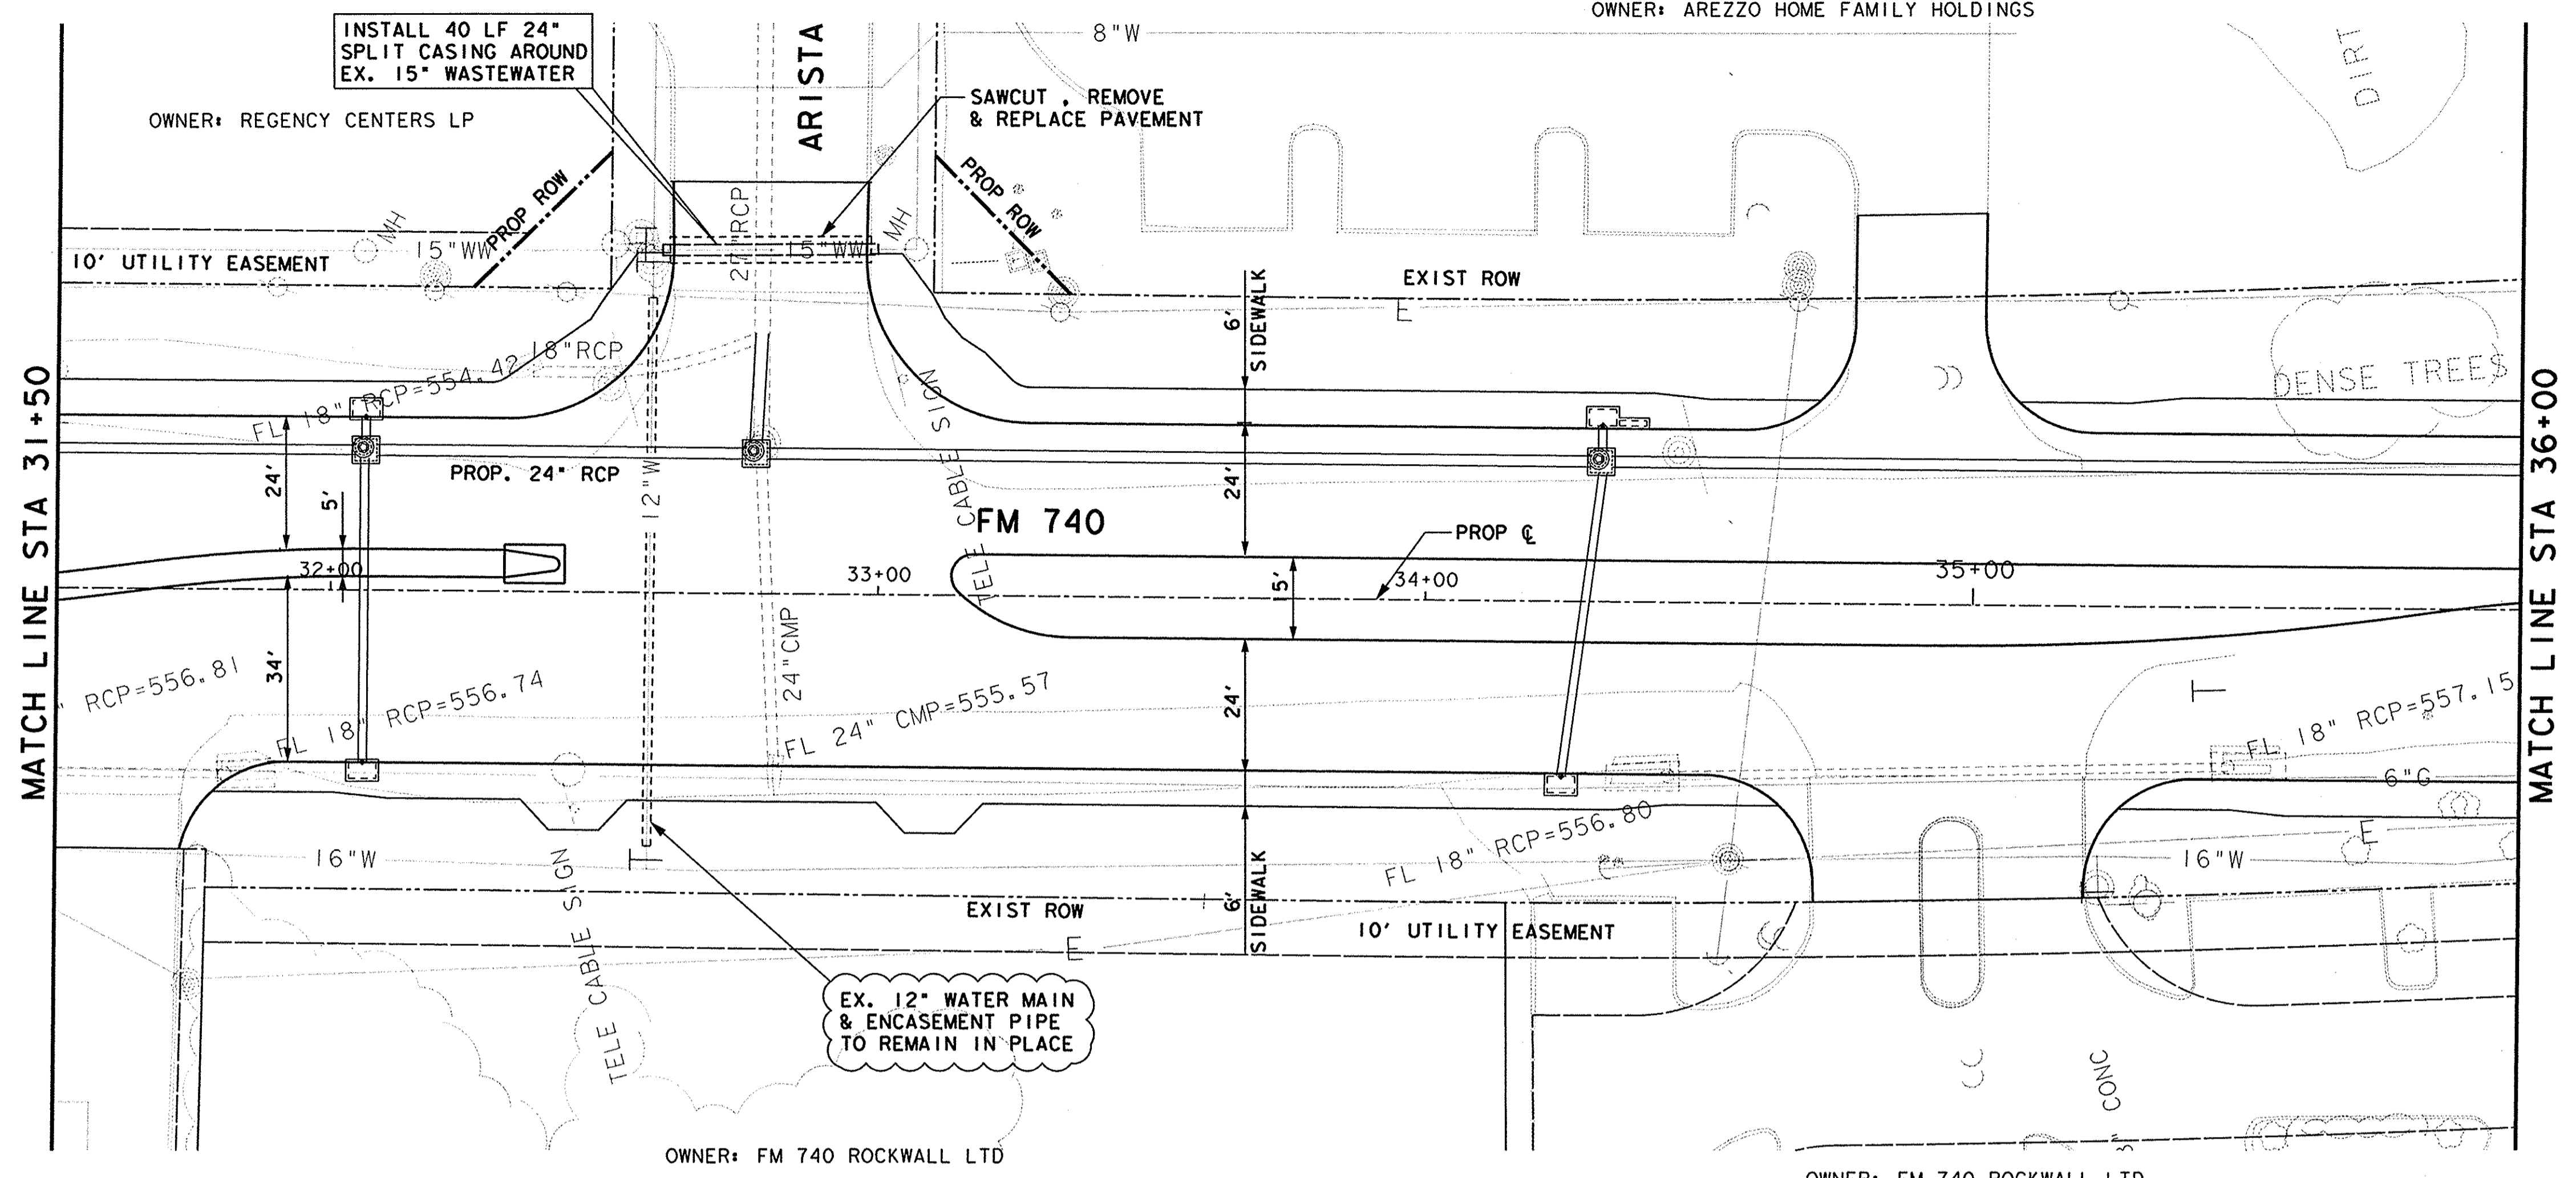


OWNER: AREZZO HOME FAMILY HOLDINGS

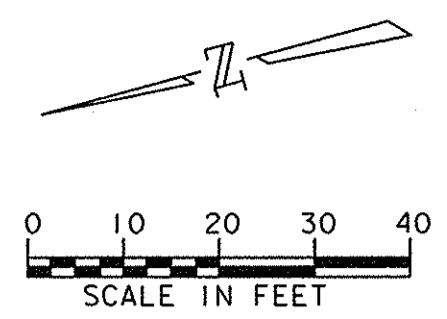

MATCH LINE STA 31+50


MATCH LINE STA 36+00

OWNER: FM 740 ROCKWALL LTD

OWNER: FM 740 ROCKWALL LTD

USER: THERESA
SCALE: SCALE=50.000000
F:\1\BL\W8\H\FULL.LIBL


I:\AP\01\371301\dgn\371301\UW04.dgn
8/13/2010
10:52:53

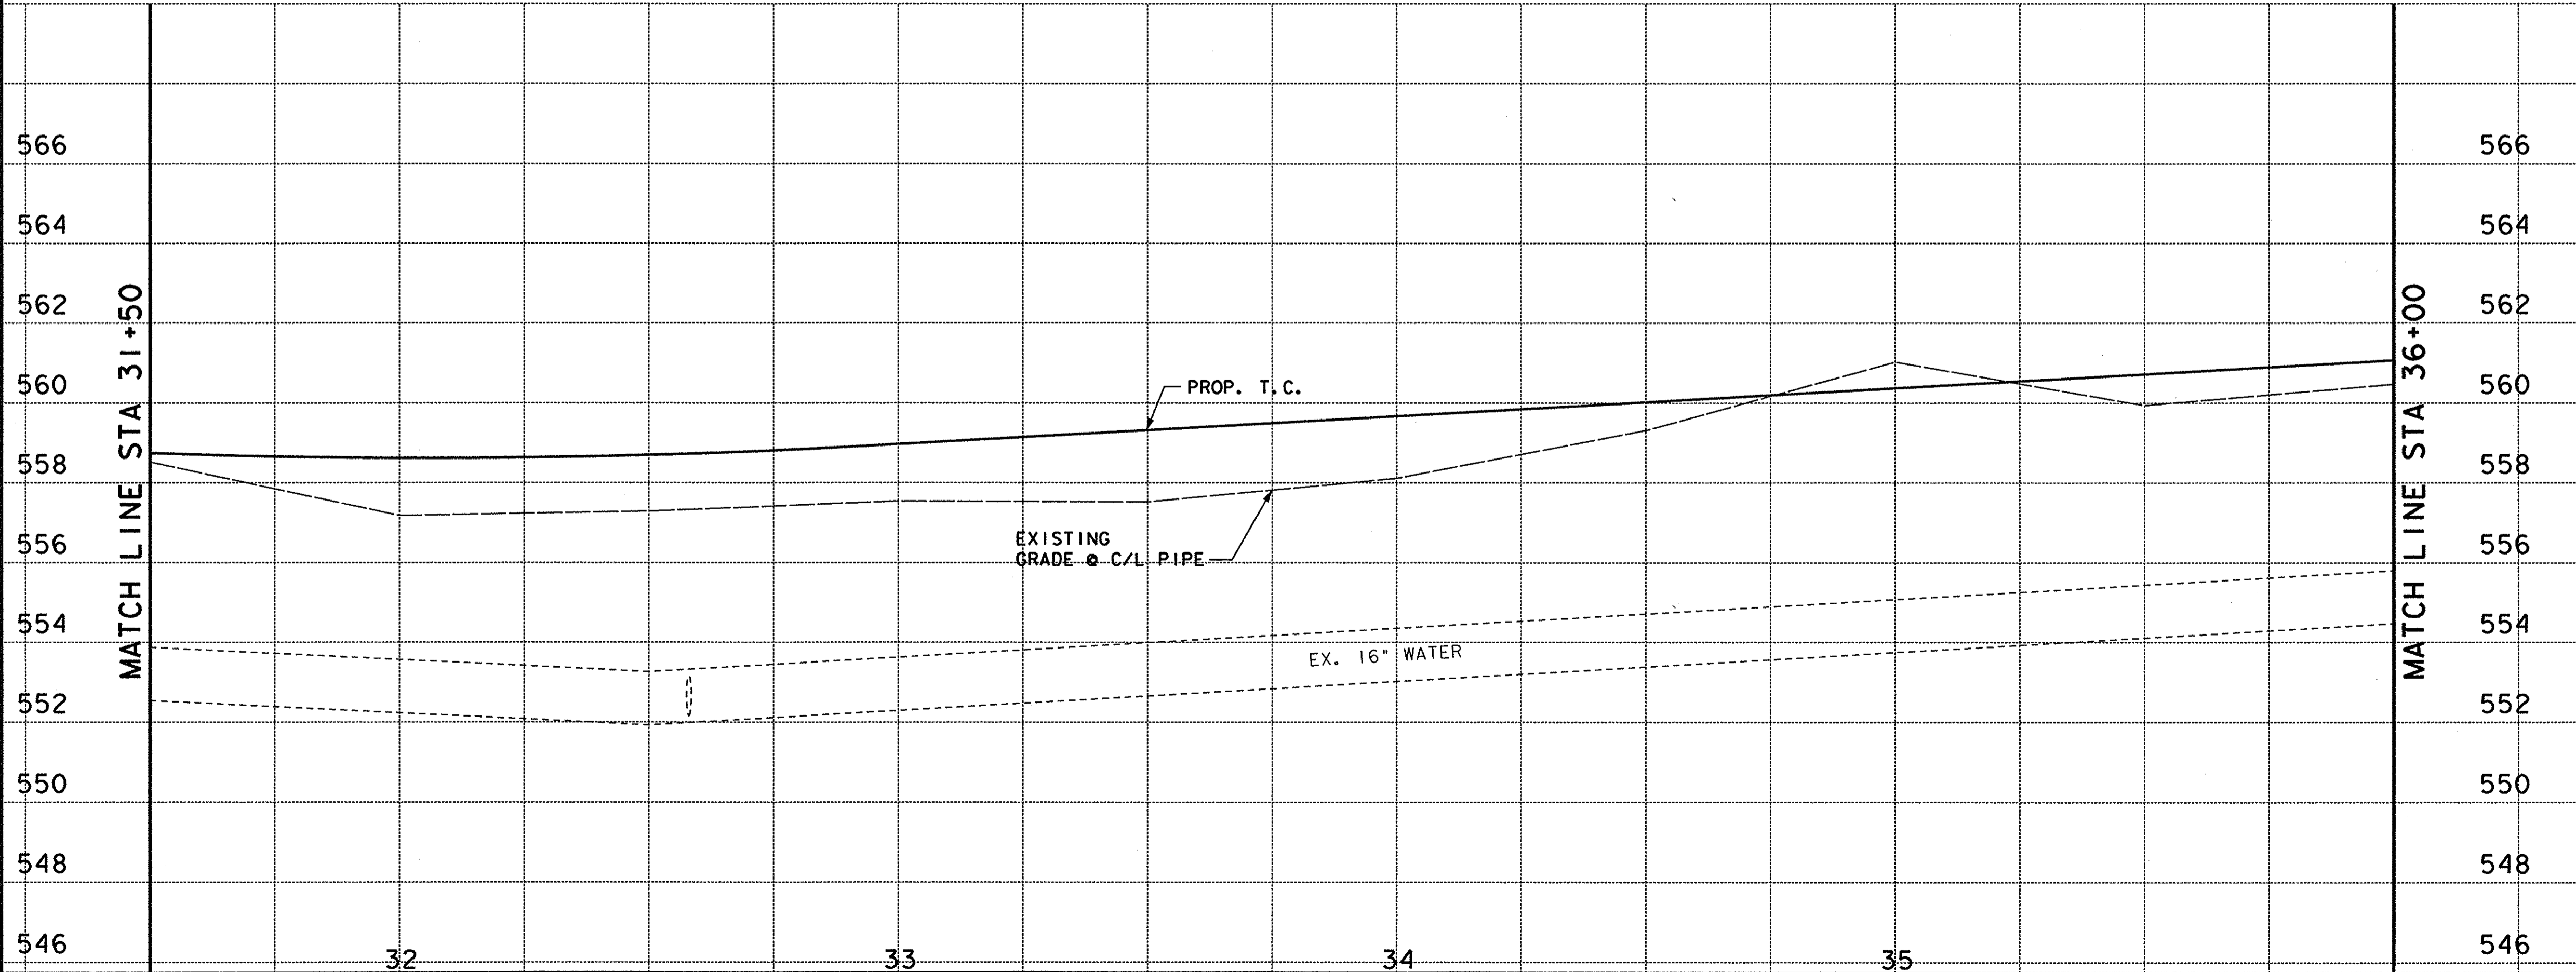

MATCH LINE STA 31+50

MATCH LINE STA 36+00

THE SEAL APPEARING ON THIS DOCUMENT WAS AUTHORIZED BY KENNETH A. ROBERTS, P.E. 55446 ON AUGUST 24, 2009

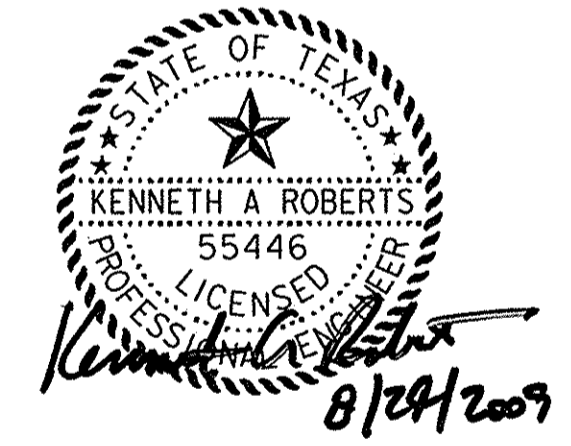

FIRM REGISTRATION NO. F-761

RECORD DRAWINGS AUGUST 13, 2010
THIS RECORD DOCUMENT HAS BEEN PREPARED BASED ON INFORMATION PROVIDED BY OTHERS. THE CONSULTANT HAS NOT VERIFIED THE ACCURACY AND/OR COMPLETENESS OF THIS INFORMATION AND SHALL NOT BE RESPONSIBLE FOR ANY ERRORS OR OMISSIONS THAT MAY BE INCORPORATED AS A RESULT OF ERRONEOUS INFORMATION PROVIDED BY OTHERS.

FM 740

WATER PLAN & PROFILE

STA 31+50 TO STA 36+00

HORIZON ROAD TO WELLINGTON LANE

HUITT-ZOLLARS Huitt-Zollars, Inc. Reg. No. F-761
3131 McKinney Avenue, Suite 600
Dallas, Texas 75204-2489
Phone (214) 871-3311 Fax (214) 871-0757

CITY OF ROCKWALL, TEXAS

DESIGN	DRAWN	APPR.	SCALE	DATE	PROJECT NO.	NO.
HZI	HZI	KAR	H: 1"=20' V: 1"=2.5'	AUGUST 2009	01-3713-01	11

I:\AP\01\371301\dgn\371301\UW04.dgn 8/13/2010 10:52:53