
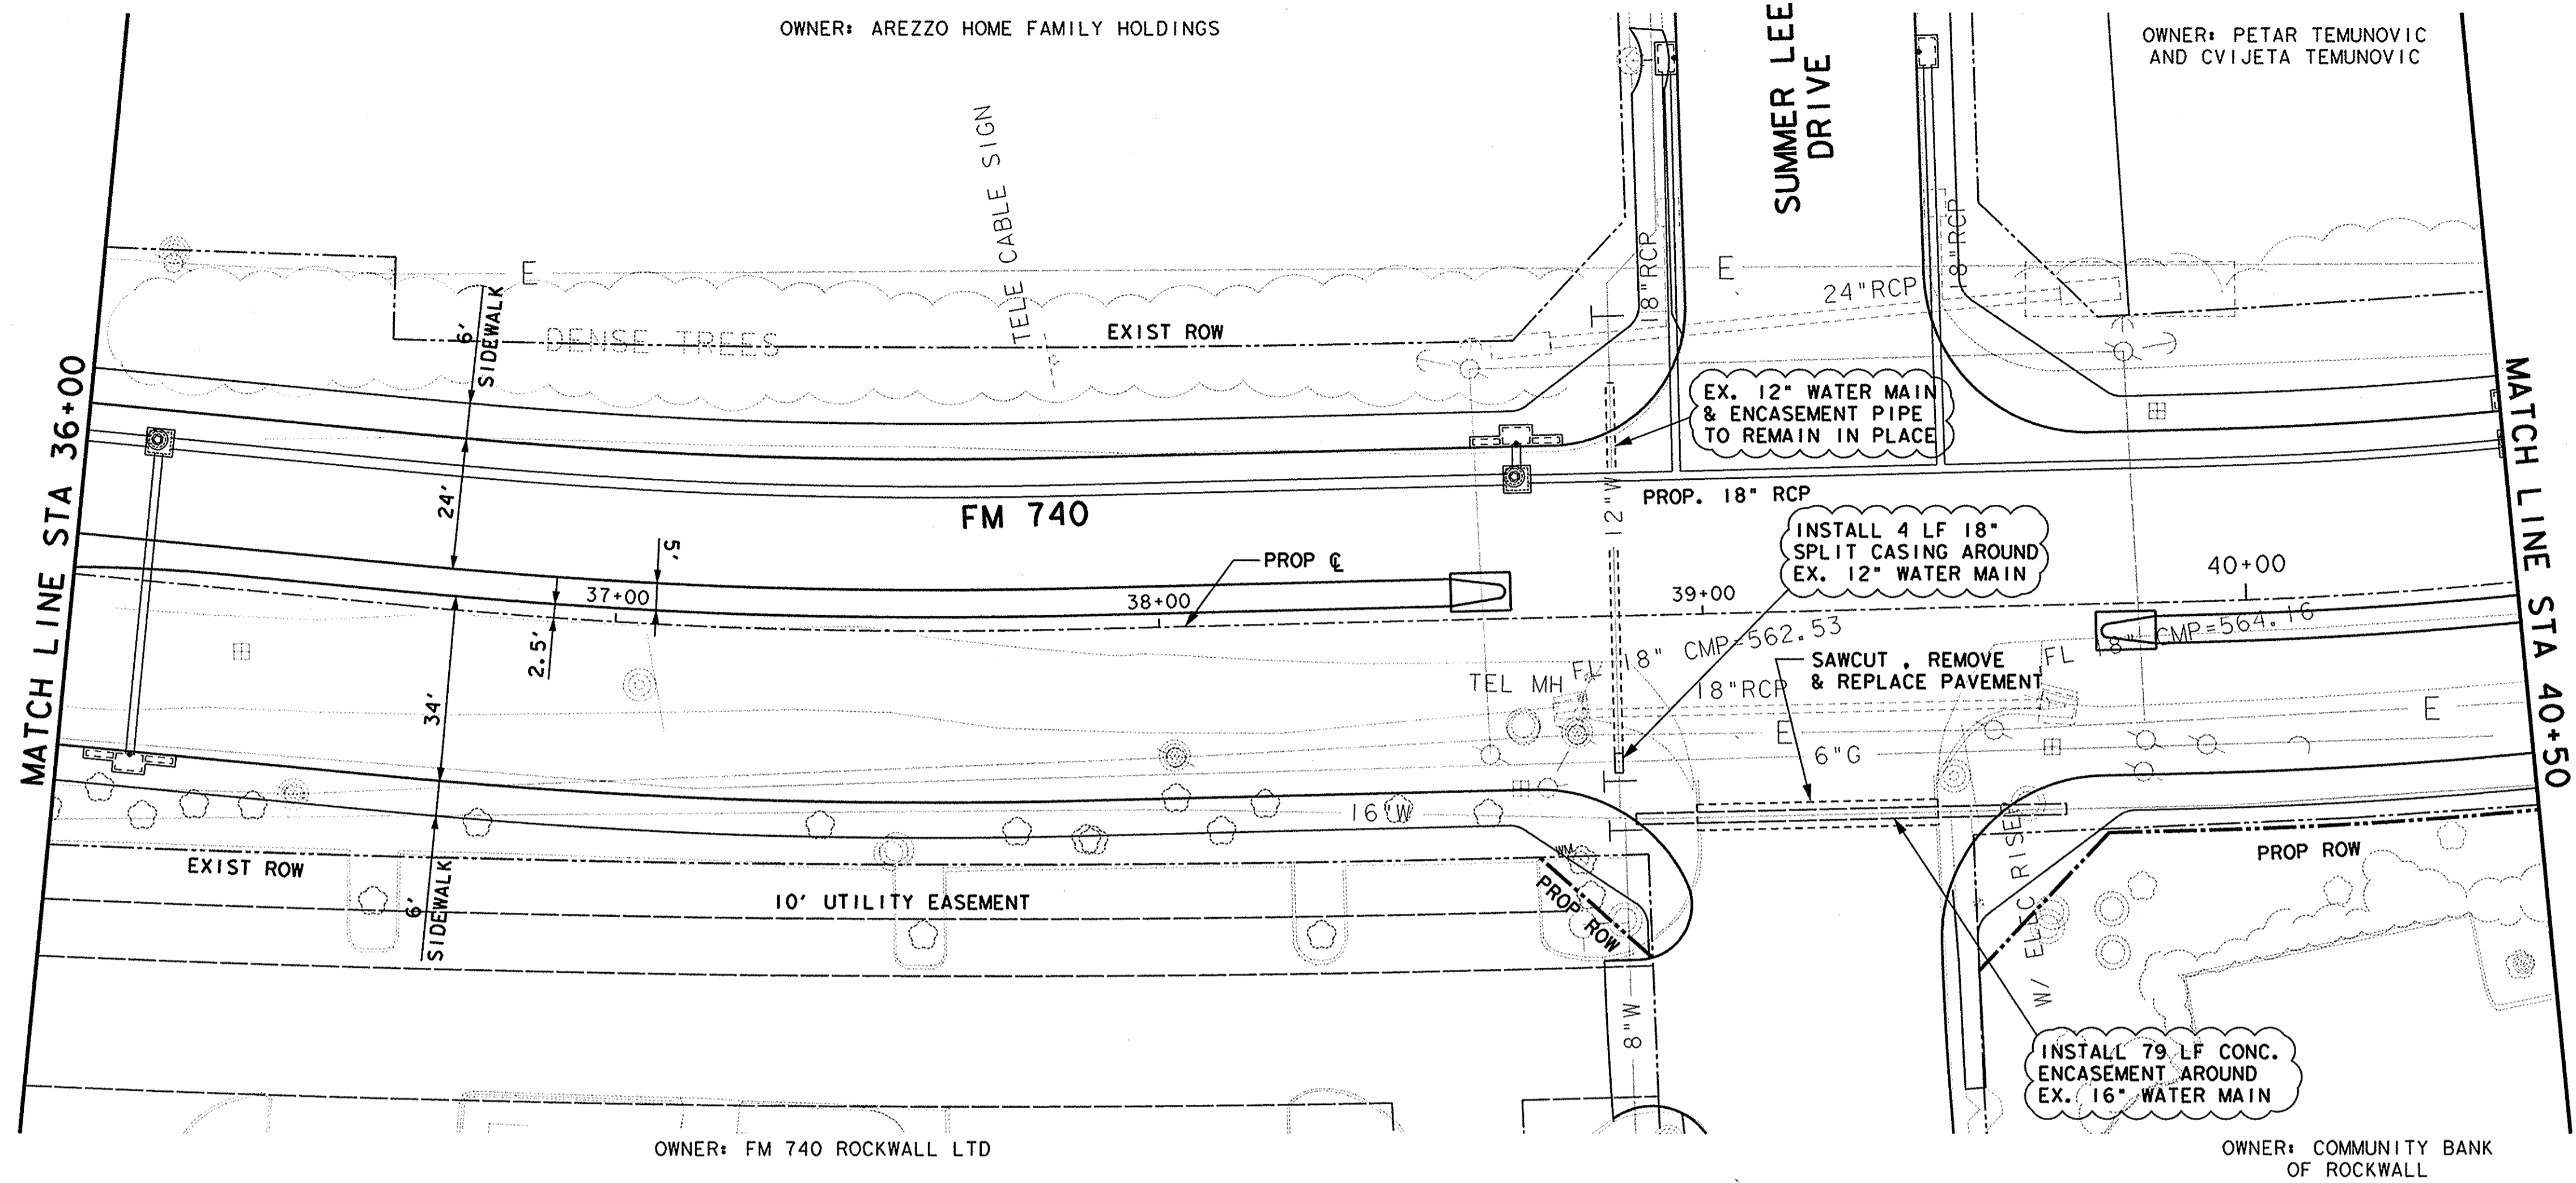


OWNER: AREZZO HOME FAMILY HOLDINGS

OWNER: PETAR TEMUNOVIC AND CVIJETA TEMUNOVIC

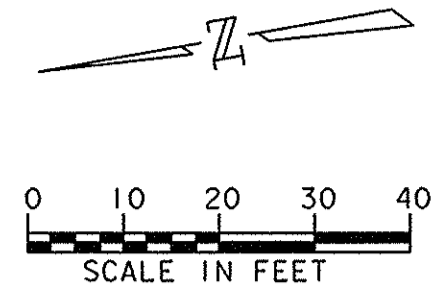

OWNER: FM 740 ROCKWALL LTD

OWNER: COMMUNITY BANK OF ROCKWALL

THE SEAL APPEARING ON THIS DOCUMENT WAS AUTHORIZED BY KENNETH A ROBERTS, P.E. 55446 ON AUGUST 24, 2009



FIRM REGISTRATION NO. F-761

RECORD DRAWINGS AUGUST 13, 2010  
THIS RECORD DOCUMENT HAS BEEN PREPARED BASED ON INFORMATION PROVIDED BY OTHERS. THE CONSULTANT HAS NOT VERIFIED THE ACCURACY AND/OR COMPLETENESS OF THIS INFORMATION AND SHALL NOT BE RESPONSIBLE FOR ANY ERRORS OR OMISSIONS THAT MAY BE INCORPORATED AS A RESULT OF ERRONEOUS INFORMATION PROVIDED BY OTHERS.

### FM 740

### WATER PLAN & PROFILE


STA 36+00 TO STA 40+50

### HORIZON ROAD TO WELLINGTON LANE

**HUITT-ZOLLARS** Huitt-Zollars, Inc. Reg. No. F-761  
3131 McKinney Avenue, Suite 600  
Dallas, Texas 75204-2489  
Phone (214) 871-3311 Fax (214) 871-0757

### CITY OF ROCKWALL, TEXAS

DESIGN	DRAWN	APPR.	SCALE	DATE	PROJECT NO.	NO.
HZI	HZI	KAR	H: 1"=20' V: 1"=2.5'	AUGUST 2009	01-3713-01	12

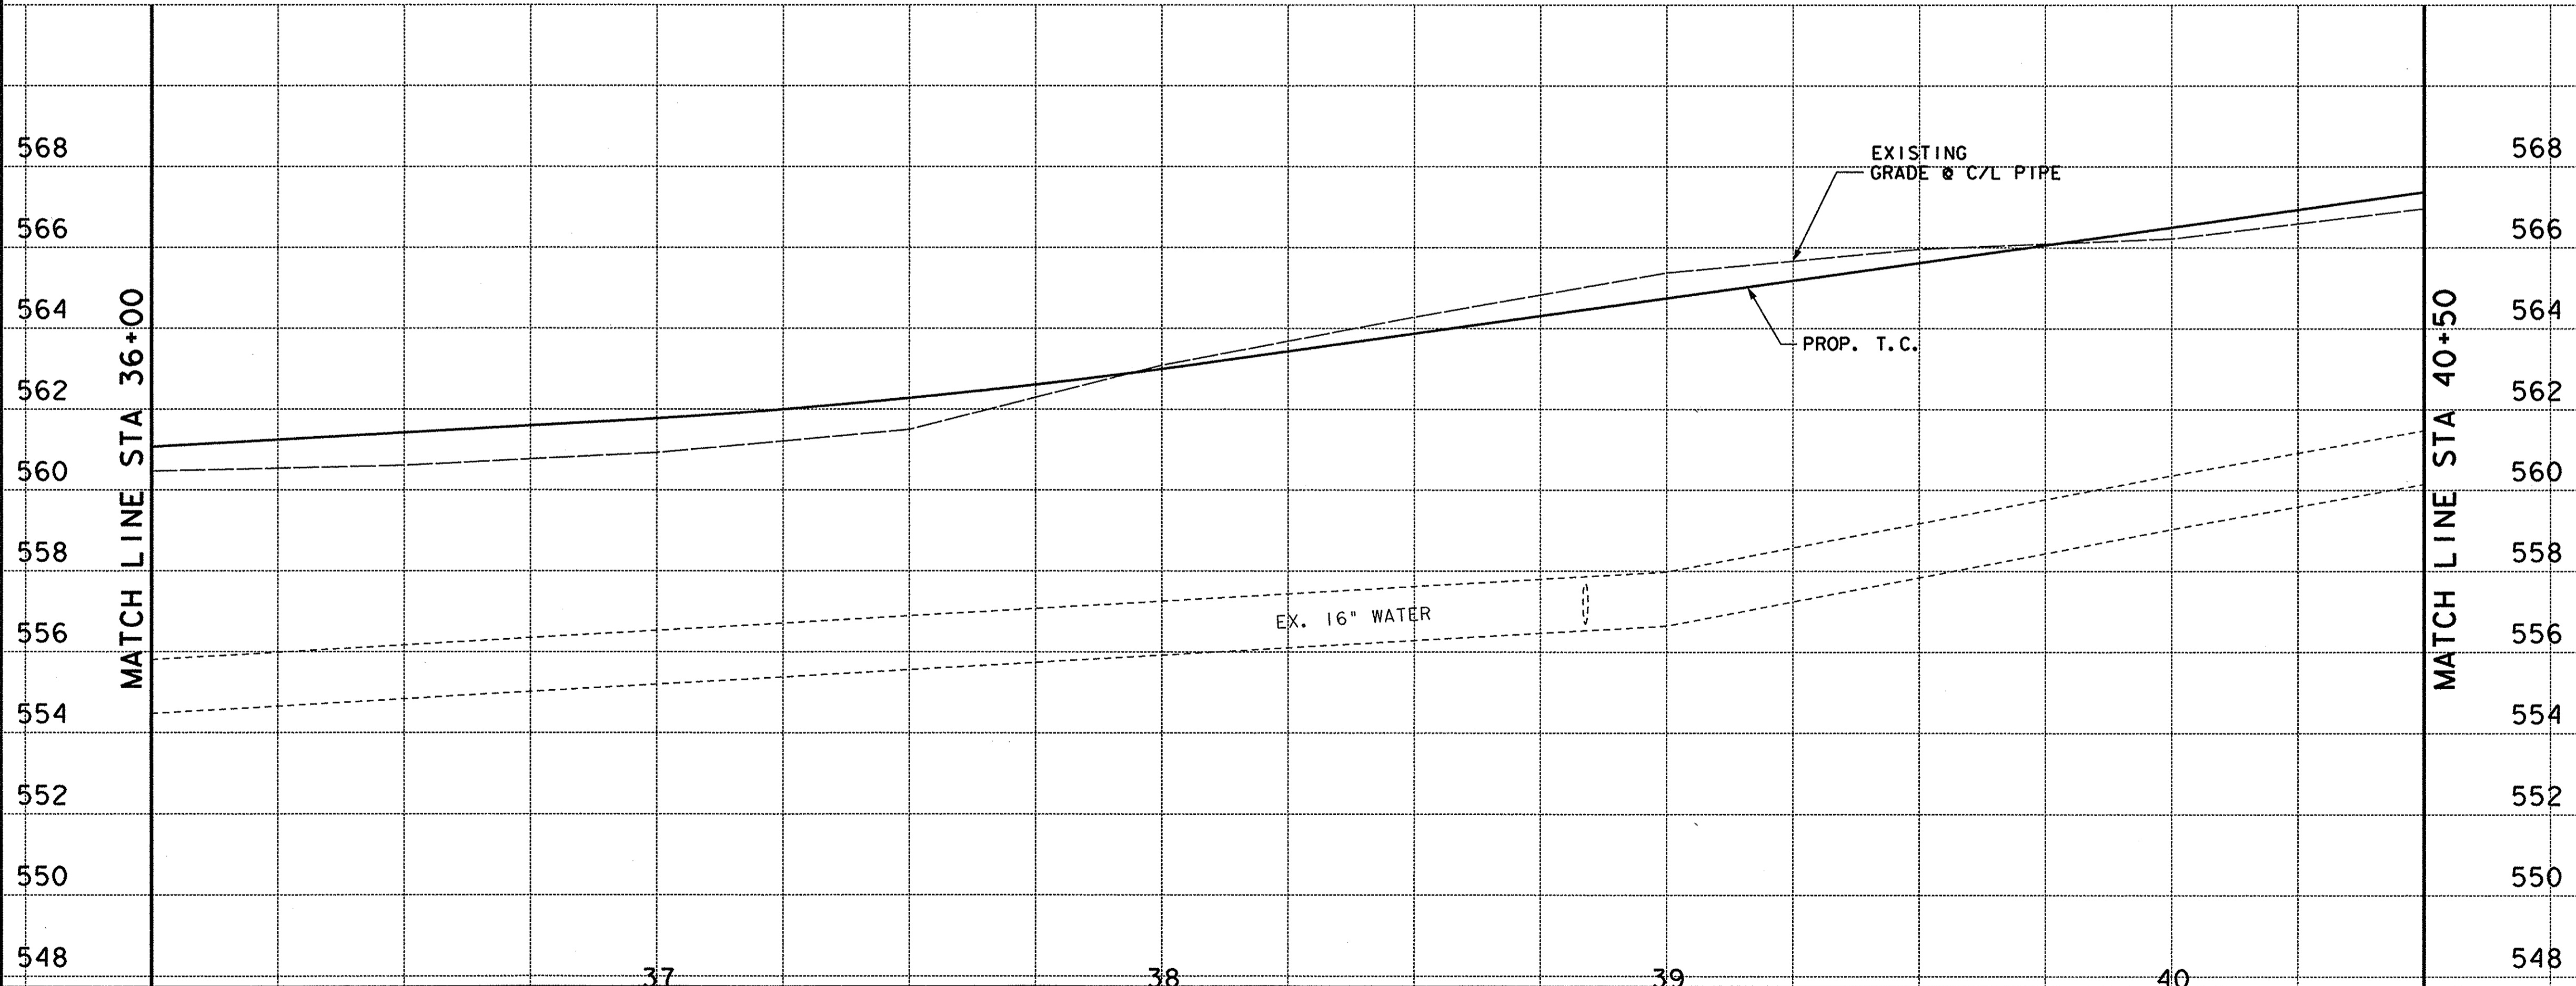

USER: THERESSA  
SCALE: SCALE=20.00000  
FILE: BLV8HITFULL.TBL

I:\APR\01\371301\dgn\371301\UWT05.DGN  
8/13/2010  
10:53:19

I:\APR\01\371301\dgn\371301\UWT05.DGN  
8/13/2010  
10:53:19