
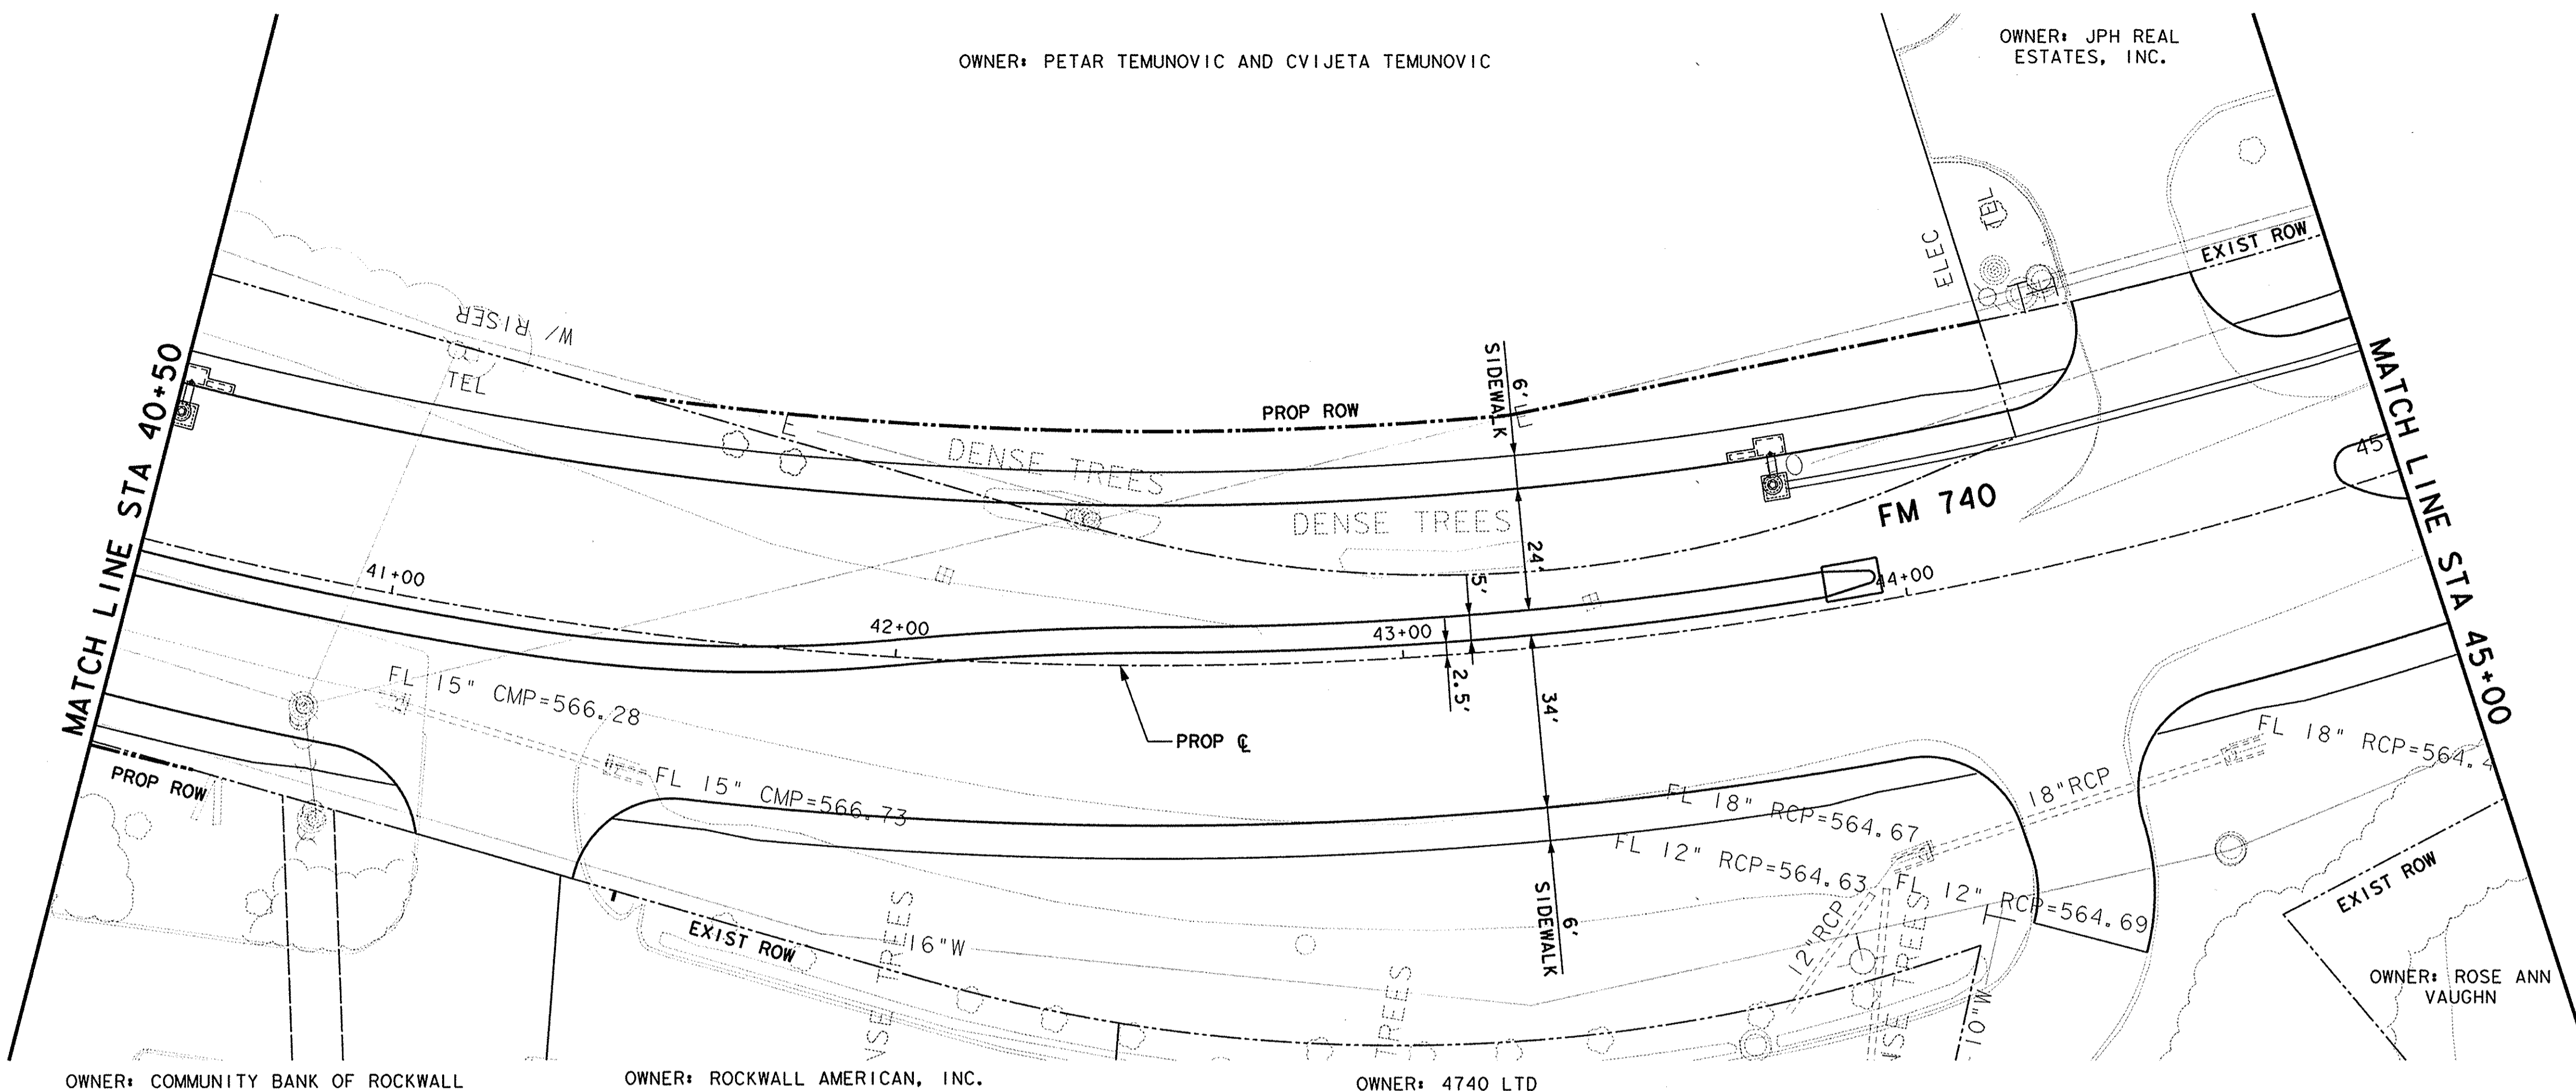


OWNER: PETAR TEMUNOVIC AND CVIJETA TEMUNOVIC

OWNER: JPH REAL ESTATES, INC.

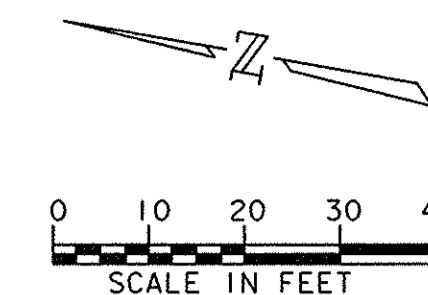

OWNER: COMMUNITY BANK OF ROCKWALL


OWNER: ROCKWALL AMERICAN, INC.

OWNER: 4740 LTD

OWNER: ROSE ANN VAUGHN

NO RELOCATIONS ON THIS SHEET FOR REFERENCE ONLY

THE SEAL APPEARING ON THIS DOCUMENT WAS AUTHORIZED BY KENNETH A ROBERTS, P.E. 55446 ON AUGUST 24, 2009

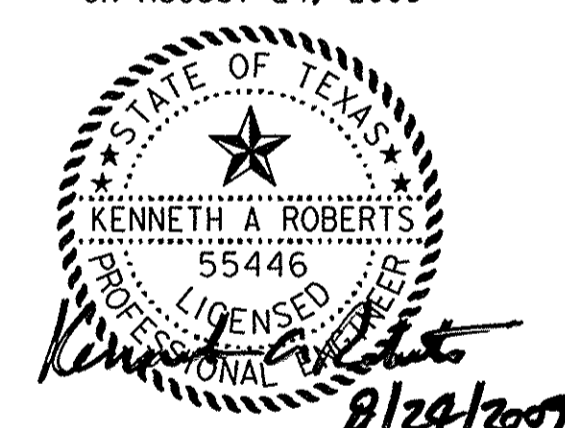

FIRM REGISTRATION NO. F-761

RECORD DRAWINGS AUGUST 13, 2010
THIS RECORD DOCUMENT HAS BEEN PREPARED BASED ON INFORMATION PROVIDED BY OTHERS. THE CONSULTANT HAS NOT VERIFIED THE ACCURACY AND/OR COMPLETENESS OF THIS INFORMATION AND SHALL NOT BE RESPONSIBLE FOR ANY ERRORS OR OMISSIONS THAT MAY BE INCORPORATED AS A RESULT OF ERRONEOUS INFORMATION PROVIDED BY OTHERS.

FM 740

WATER PLAN & PROFILE


STA 40+50 TO STA 45+00

HORIZON ROAD TO WELLINGTON LANE

HUITT-ZOLLARS Hultt-Zollars, Inc. Reg. No. F-761
3131 McKinney Avenue, Suite 600
Dallas, Texas 75204-2489
Phone (214) 871-3311 Fax (214) 871-0757

CITY OF ROCKWALL, TEXAS

DESIGN	DRAWN	APPR.	SCALE	DATE	PROJECT NO.	NO.
HZI	HZI	KAR	H: 1"=20' V: 1"=2.5'	AUGUST 2009	01-3713-01	13

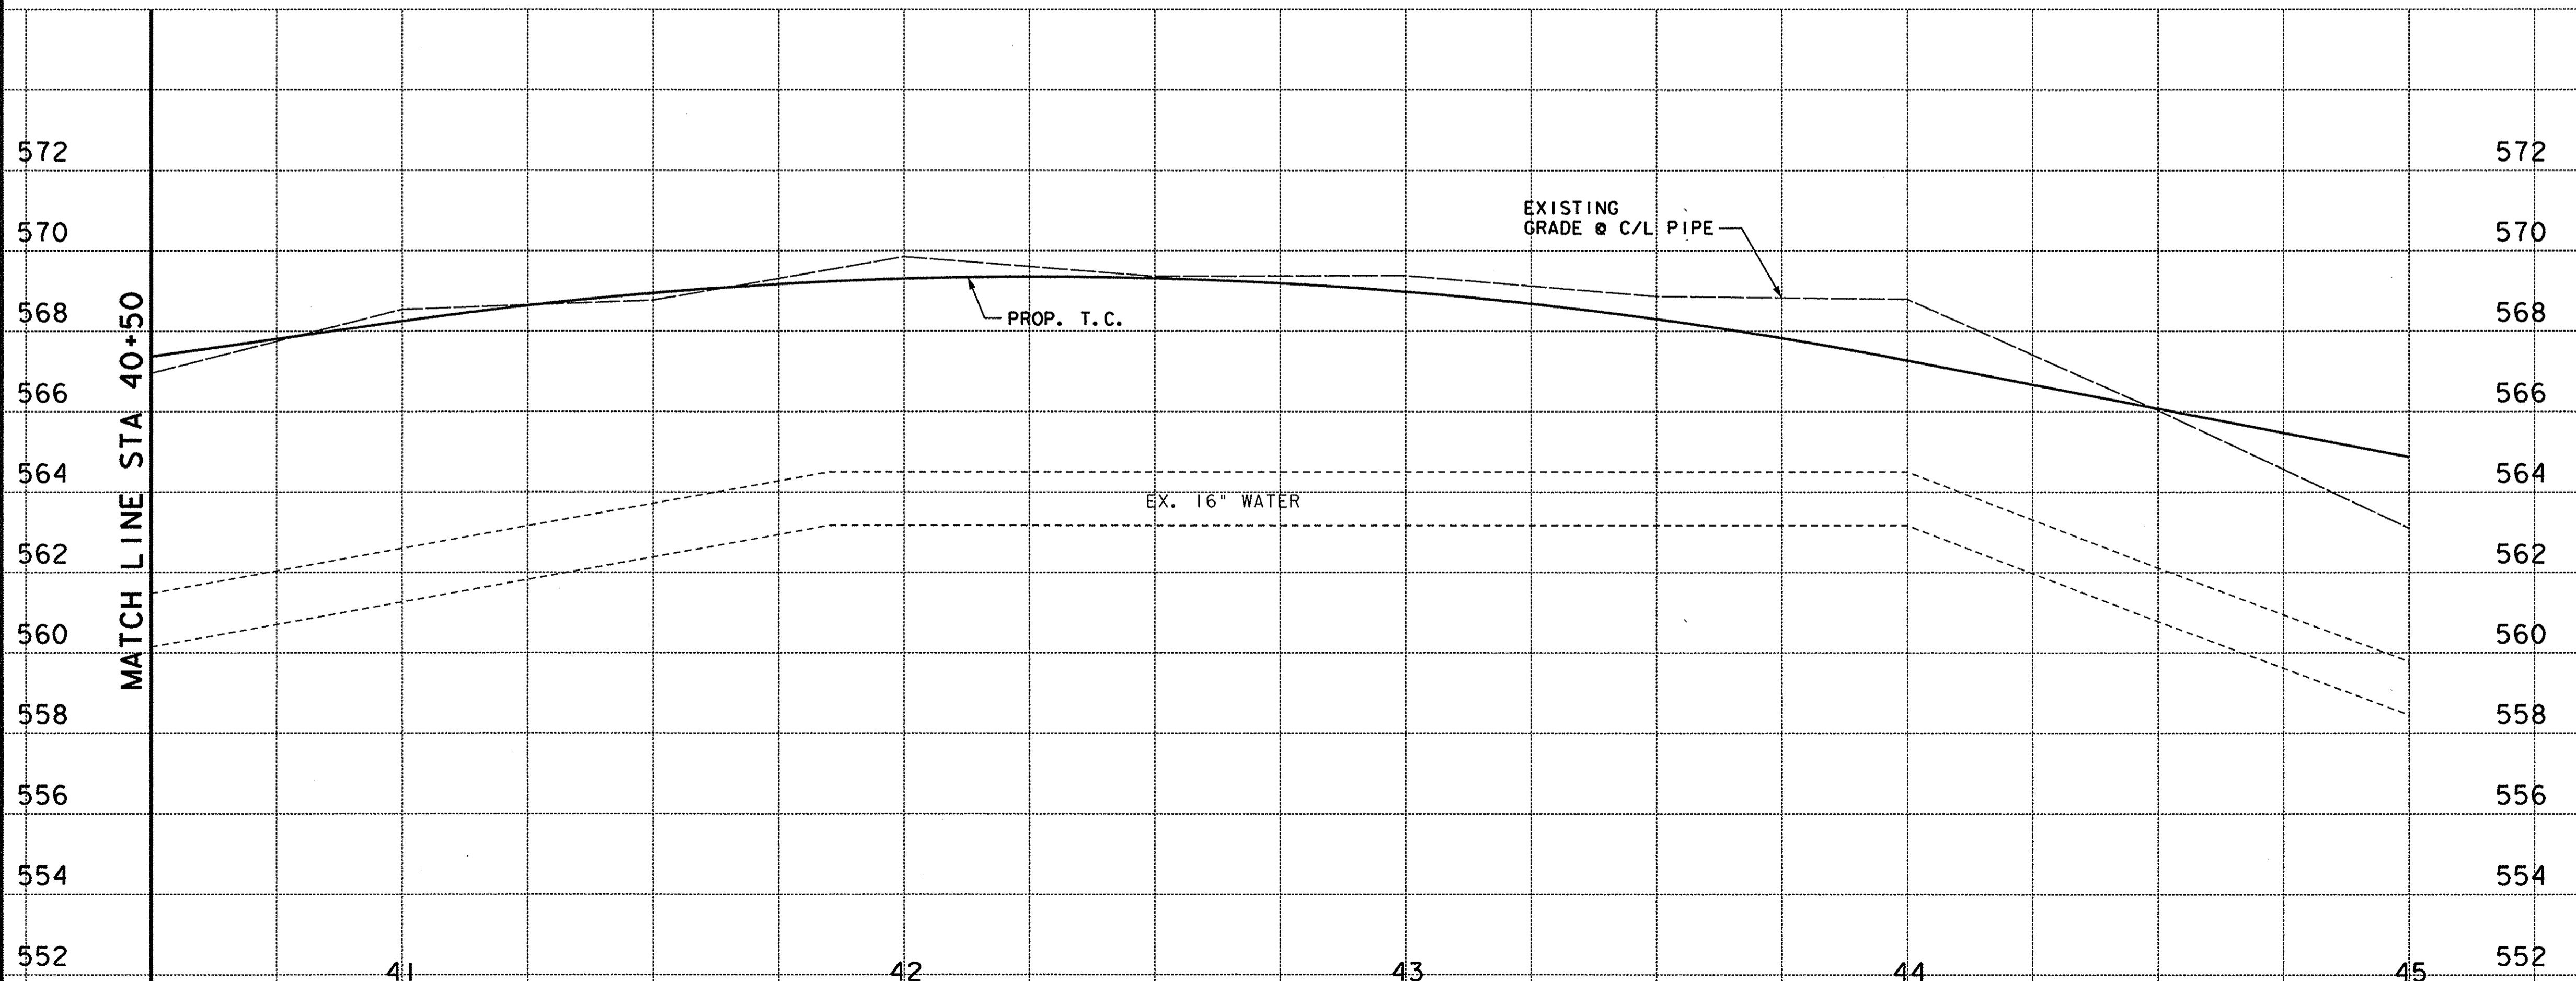

USER: THERESSA
SCALE: SCALE=20, 000000
F:\BL\W8HW\FULL.TBL

I:\APROJ\01371301\dgn\371301\UW106.DGN
8/13/2010 10:53:46

I:\APROJ\01371301\dgn\371301\UW106.DGN 8/13/2010 10:53:46