

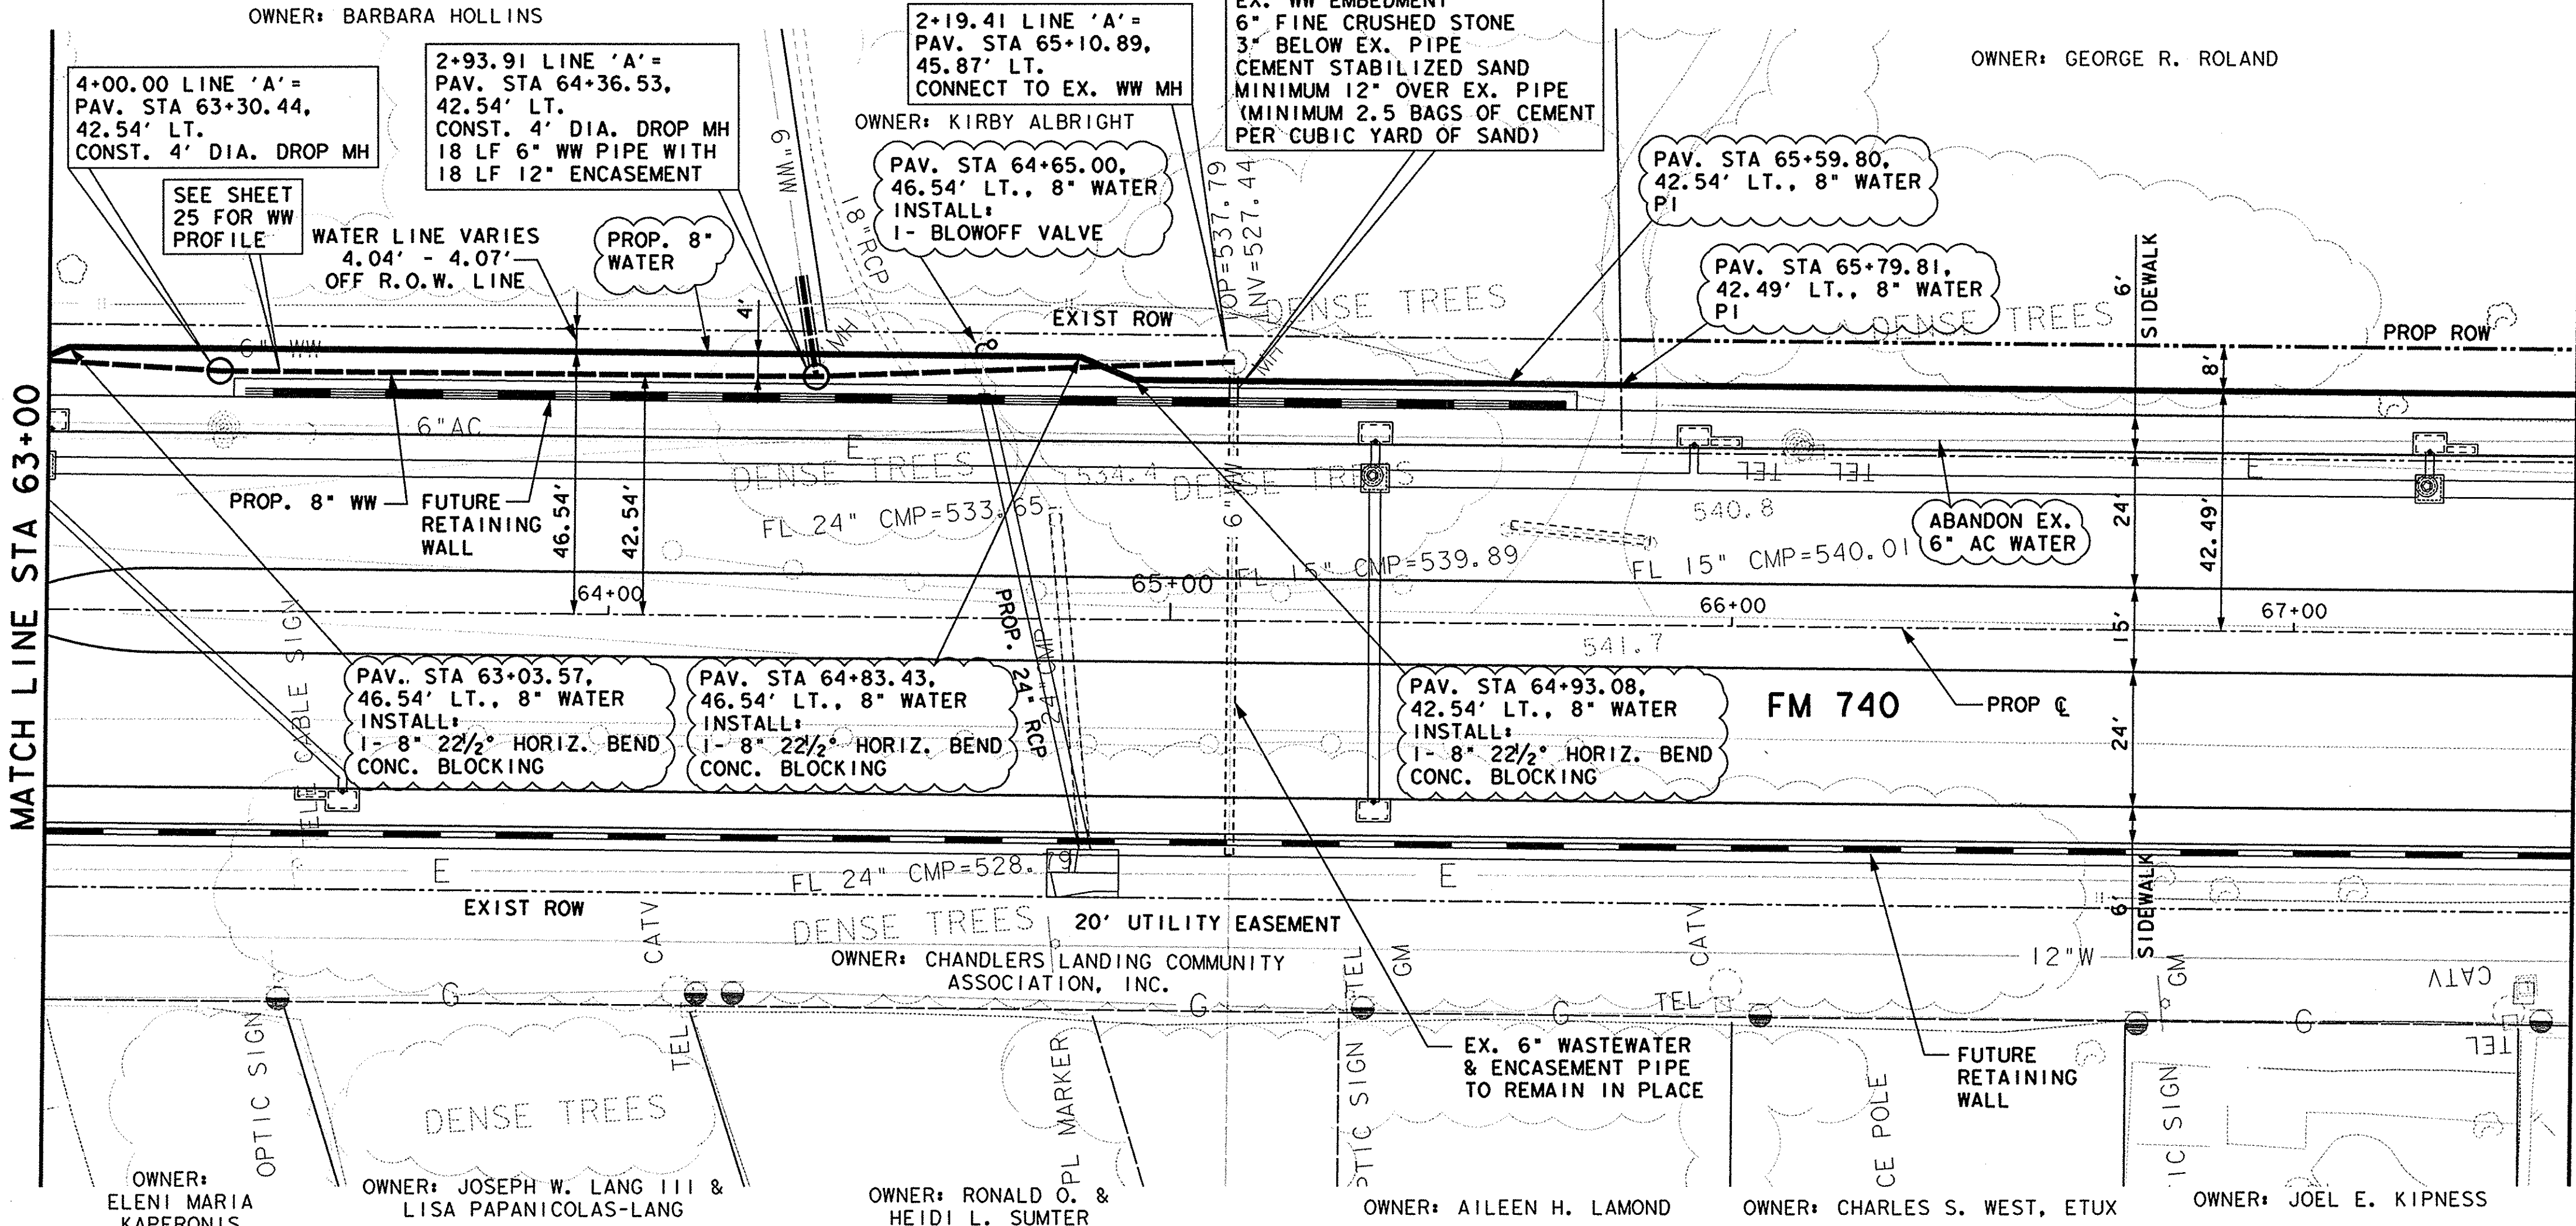


OWNER: BARBARA HOLLINS


OWNER: GEORGE R. ROLAND

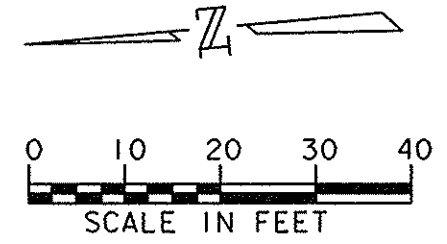

NOTE: CONTRACTOR SHALL UTILIZE BY-PASS PUMPING WHEN CONSTRUCTING WASTEWATER LINE 'A'.

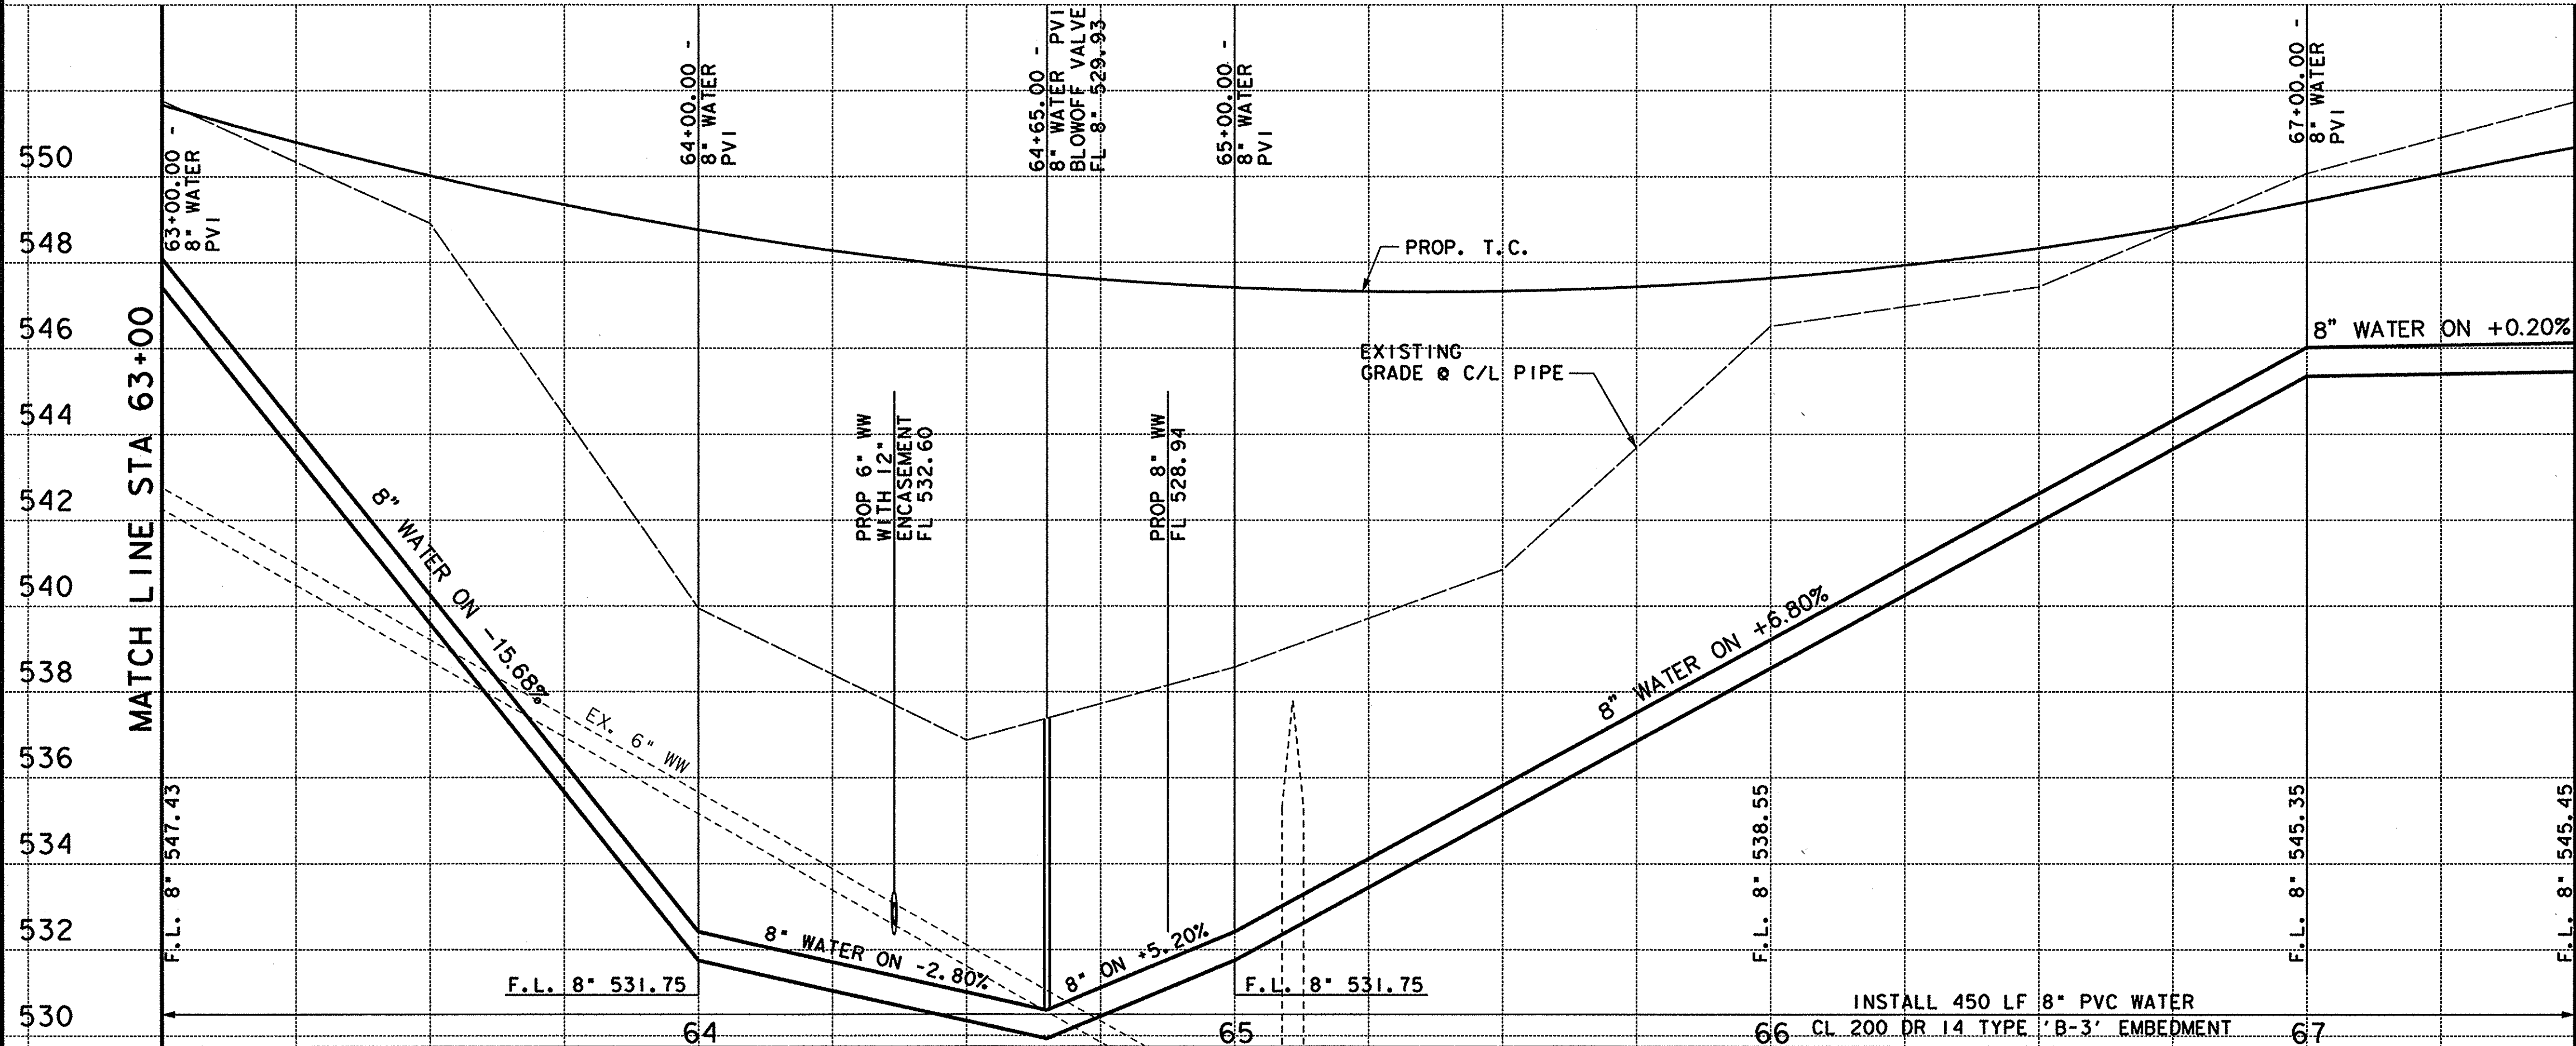

THE SEAL APPEARING ON THIS DOCUMENT WAS AUTHORIZED BY KENNETH A. ROBERTS, P.E., 55446 ON AUGUST 24, 2009

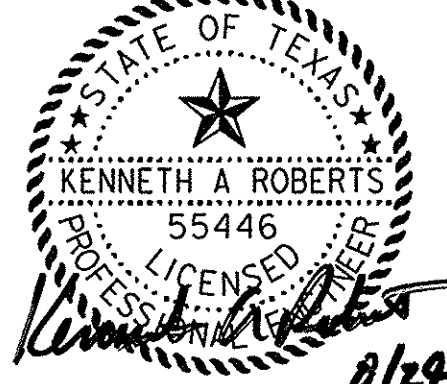

FIRM REGISTRATION NO. F-761

RECORD DRAWINGS AUGUST 13, 2010  
THIS RECORD DOCUMENT HAS BEEN PREPARED BASED ON INFORMATION PROVIDED BY OTHERS. THE CONSULTANT HAS NOT VERIFIED THE ACCURACY AND/OR COMPLETENESS OF THIS INFORMATION AND SHALL NOT BE RESPONSIBLE FOR ANY ERRORS OR OMISSIONS THAT MAY BE INCORPORATED AS A RESULT OF ERRONEOUS INFORMATION PROVIDED BY OTHERS.

**FM 740**

**WATER PLAN & PROFILE**

STA 63+00 TO STA 67+50

**HORIZON ROAD TO WELLINGTON LANE**

**HUITT-ZOLLARS** Reg. No. F-761  
3131 McKinney Avenue, Suite 600  
Dallas, Texas 75204-2489  
Phone (214) 871-3311 Fax (214) 871-0757

**CITY OF ROCKWALL, TEXAS**

DESIGN	DRAWN	APPR.	SCALE	DATE	PROJECT NO.	NO.
HZI	HZI	KAR	H: 1"=20' V: 1"=2.5'	AUGUST 2009	01-3713-01	<b>18</b>

USER: THERESSA  
SCALE: SCALE=20.000000  
F:\TBL\W8HWFULL.TBL

I:\p\proj\01371301\dgn\371301\UWT11.dgn 8/13/2010 10:35:59