


OWNER: GEORGE R. ROLAND


PAV. STA 68+00.00,
42.49' LT., 8" WATER
INSTALL:
1- 8"x6" TEE
1- 8" GATE VALVE
1- FIRE HYDRANT
ASSEMBLY, 48.49' LT.
CONC. BLOCKING

PAV. STA 68+46.69,
42.49' LT., 8" WATER
INSTALL:
1- 1" SERVICE TAP/OUTLET
1- WATER METER BOX
1- L.F. 1" SERVICE PIPE
CONNECT TO EX. SERVICE

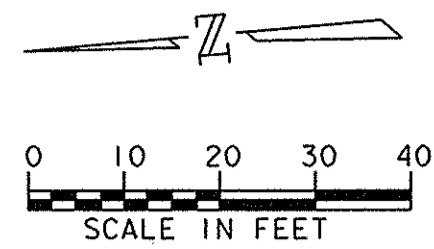

MATCH LINE STA 67+50

MATCH LINE STA 72+00

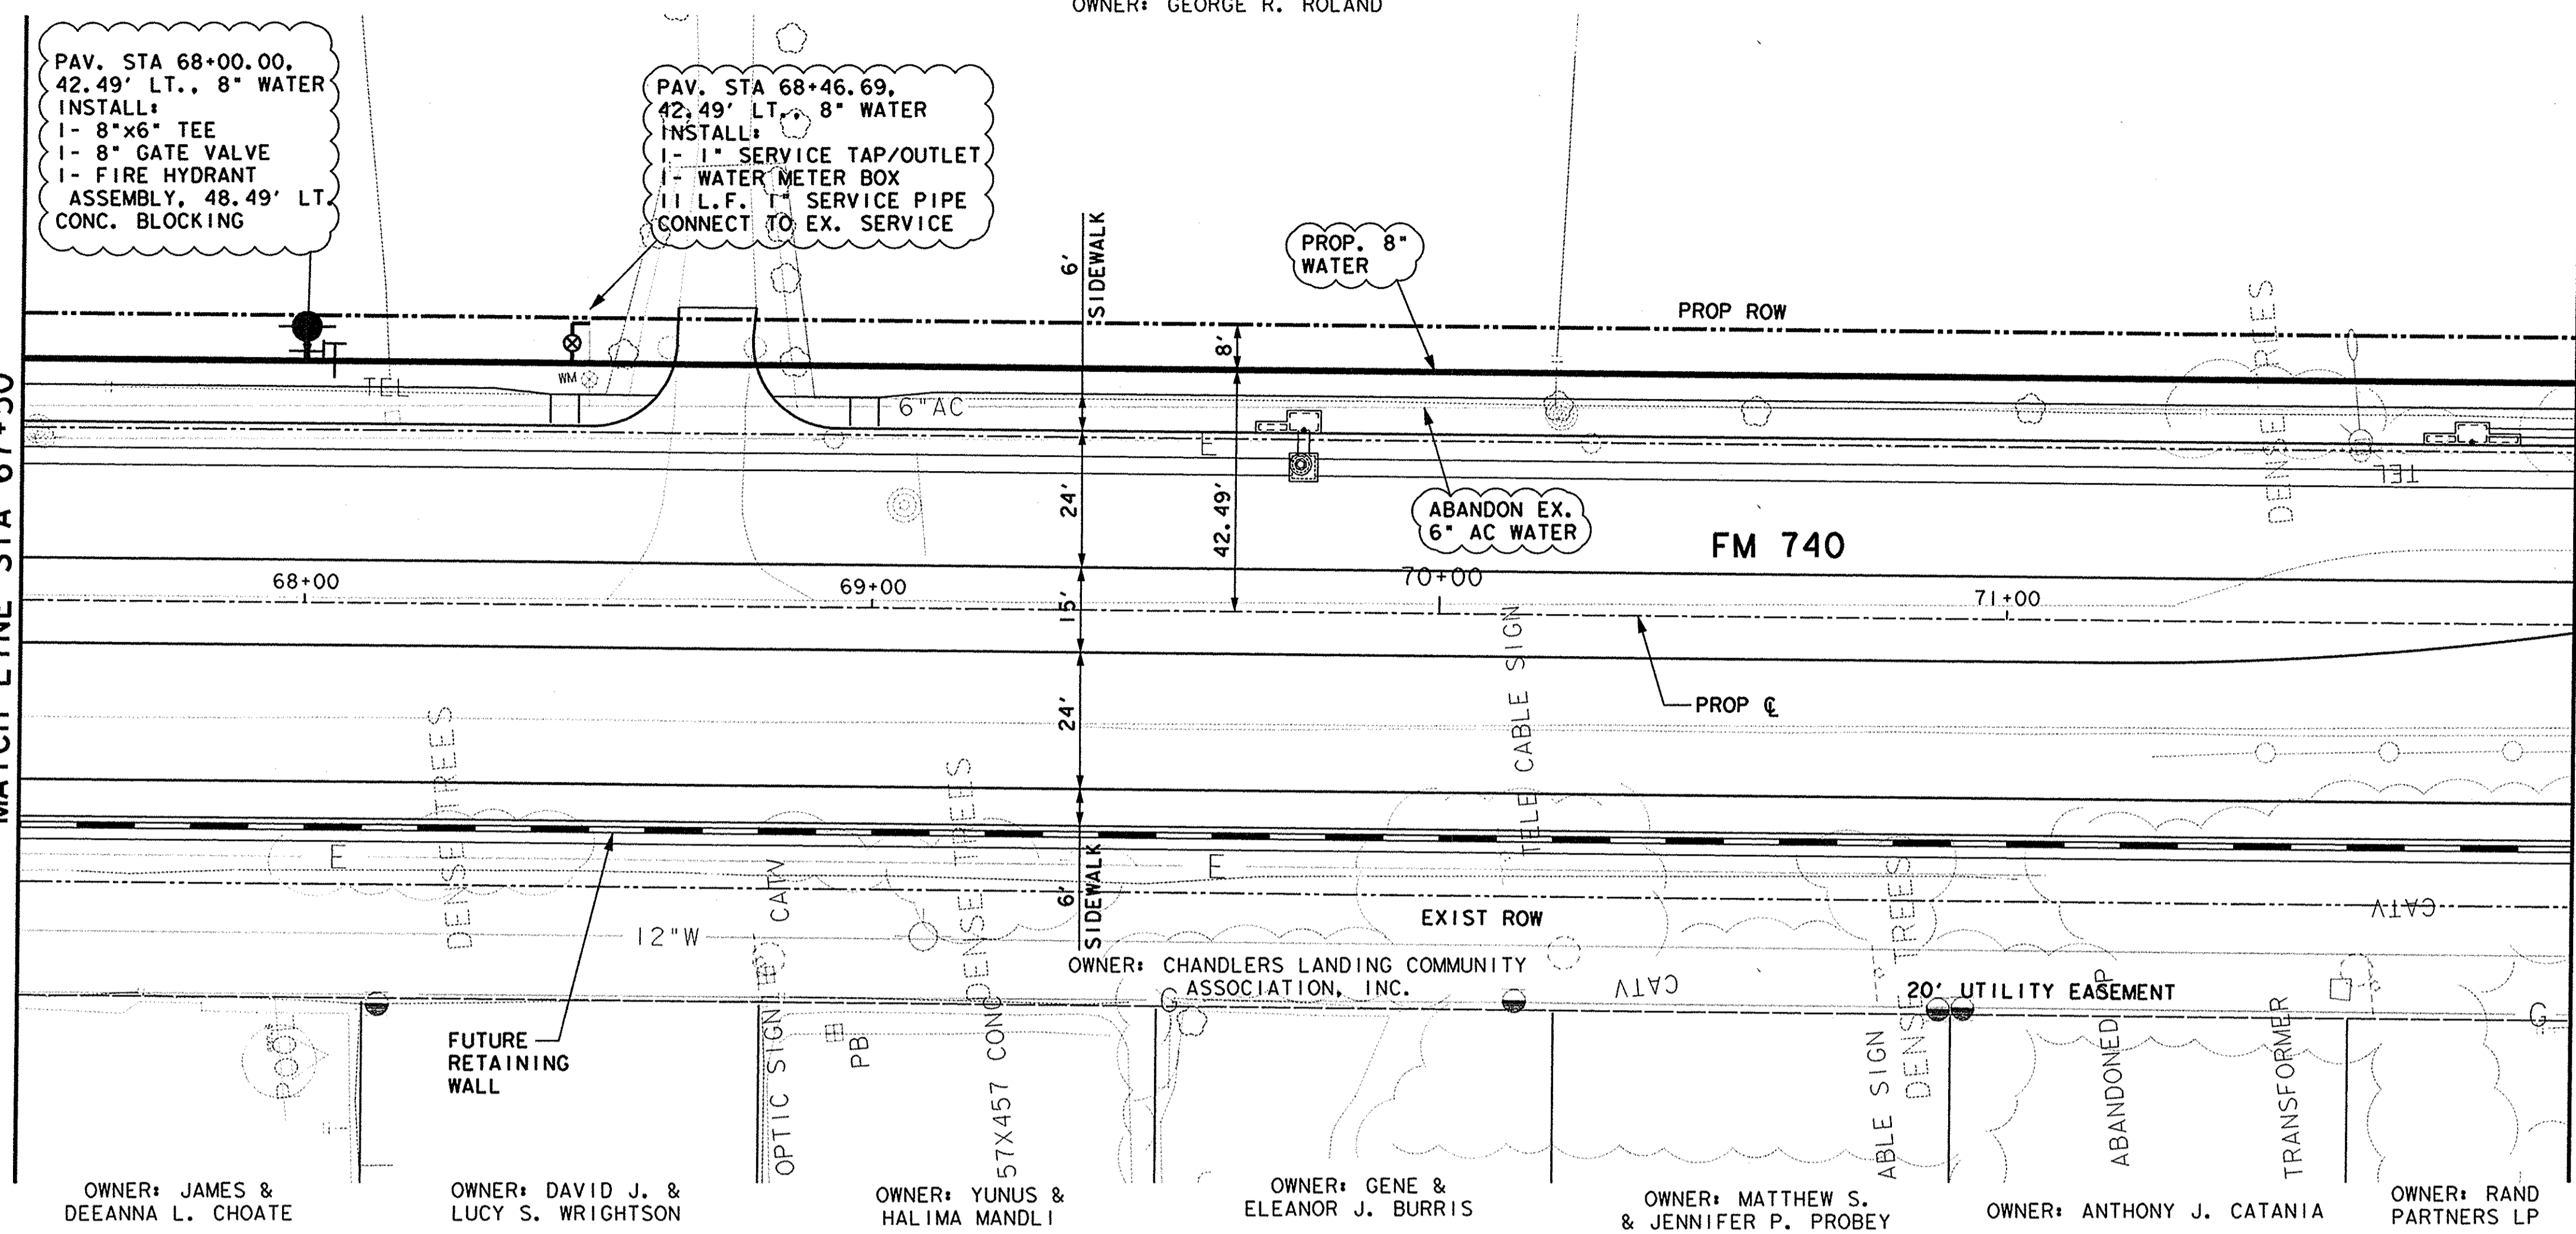

OWNER: JAMES & DEEANNA L. CHOATE

OWNER: DAVID J. & LUCY S. WRIGHTSON

OWNER: YUNUS & HALIMA MANDLI

OWNER: GENE & ELEANOR J. BURRIS

OWNER: MATTHEW S. & JENNIFER P. PROBEY

OWNER: ANTHONY J. CATANIA

OWNER: RAND PARTNERS LP

OWNER: CHANDLERS LANDING COMMUNITY ASSOCIATION, INC.

USER: THERESSA
SCALE: SCALE=20.000000
F:\1\BL\88\HW\FULL.L.TBL

I:\p\proj\101371301\dgn\1371301\UWT12.dgn
8/13/2010 10:56:26



THE SEAL APPEARING ON THIS DOCUMENT WAS AUTHORIZED BY KENNETH A. ROBERTS, P.E., 55446 ON AUGUST 24, 2009



FIRM REGISTRATION NO. F-761

RECORD DRAWINGS AUGUST 13, 2010
THIS RECORD DOCUMENT HAS BEEN PREPARED BASED ON INFORMATION PROVIDED BY OTHERS. THE CONSULTANT HAS NOT VERIFIED THE ACCURACY AND/OR COMPLETENESS OF THIS INFORMATION AND SHALL NOT BE RESPONSIBLE FOR ANY ERRORS OR OMISSIONS THAT MAY BE INCORPORATED AS A RESULT OF ERRONEOUS INFORMATION PROVIDED BY OTHERS.

FM 740

WATER PLAN & PROFILE

STA 67+50 TO STA 72+00

HORIZON ROAD TO WELLINGTON LANE

HUITT-ZOLLARS Huitt-Zollars, Inc. Reg. No. F-761
3131 McKinney Avenue, Suite 600
Dallas, Texas 75204-2489
Phone (214) 871-3311 Fax (214) 871-0757

CITY OF ROCKWALL, TEXAS

DESIGN	DRAWN	APPR.	SCALE	DATE	PROJECT NO.	NO.
HZI	HZI	KAR	H: 1"=20' V: 1"=2.5'	AUGUST 2009	01-3713-01	19

I:\p\proj\101371301\dgn\1371301\UWT12.dgn 8/13/2010 10:56:26