


THE SEAL APPEARING ON THIS DOCUMENT WAS AUTHORIZED BY KENNETH A. ROBERTS, P.E. 55446 ON AUGUST 24, 2009

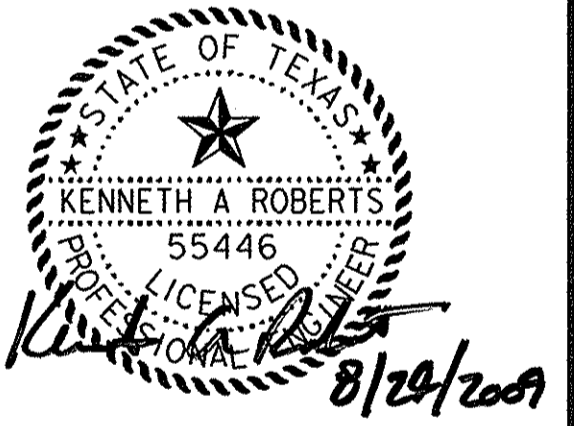

FIRM REGISTRATION NO. F-761

RECORD DRAWINGS AUGUST 13, 2010
 THIS RECORD DOCUMENT HAS BEEN PREPARED BASED ON INFORMATION PROVIDED BY OTHERS. THE CONSULTANT HAS NOT VERIFIED THE ACCURACY AND/OR COMPLETENESS OF THIS INFORMATION AND SHALL NOT BE RESPONSIBLE FOR ANY ERRORS OR OMISSIONS THAT MAY BE INCORPORATED AS A RESULT OF ERRONEOUS INFORMATION PROVIDED BY OTHERS.

FM 740
WATER PLAN & PROFILE
 STA 81+00 TO
 STA 85+50

HORIZON ROAD TO WELLINGTON LANE
HUITT-ZOLLARS
 Huitt-Zollars, Inc. Reg. No. F-761
 3131 McKinney Avenue, Suite 600
 Dallas, Texas 75204-2489
 Phone (214) 871-3311 Fax (214) 871-0757

CITY OF ROCKWALL, TEXAS

DESIGN	DRAWN	APPR.	SCALE	DATE	PROJECT NO.	NO.
HZI	HZI	KAR	H: 1"=20' V: 1"=2.5'	AUGUST 2009	01-3713-01	22

USER: THERESSA
 SCALE: SCALE=20.000000
 P:\1\BL\WBHW\FULL.LIBL

I:\p\proj\01371301\dgn\371301\UWT15.dgn
 8/13/2010 10:57:47

I:\p\proj\01371301\dgn\371301\UWT15.dgn 8/13/2010 10:57:47