
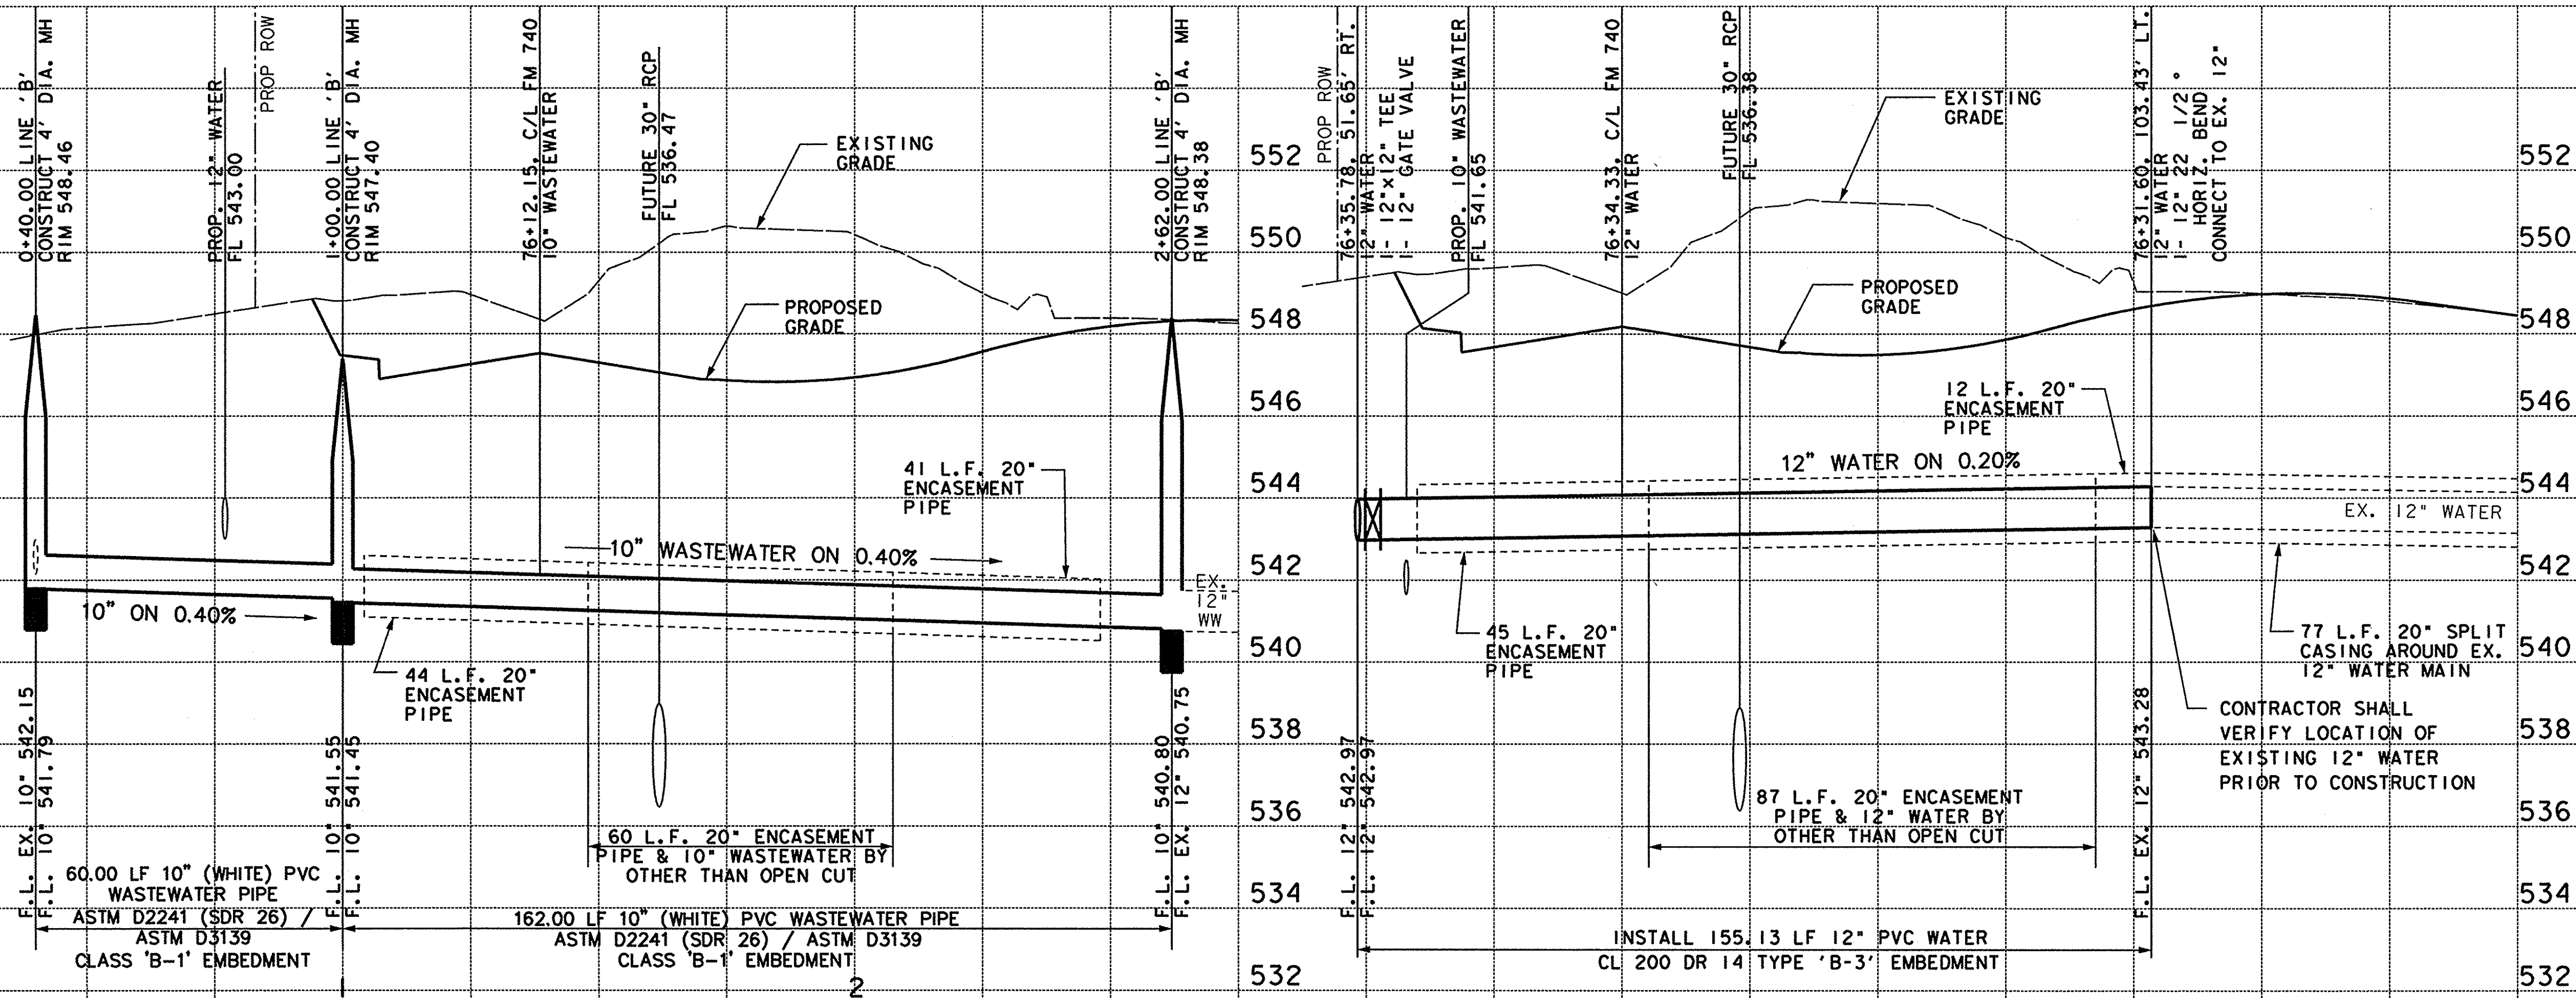
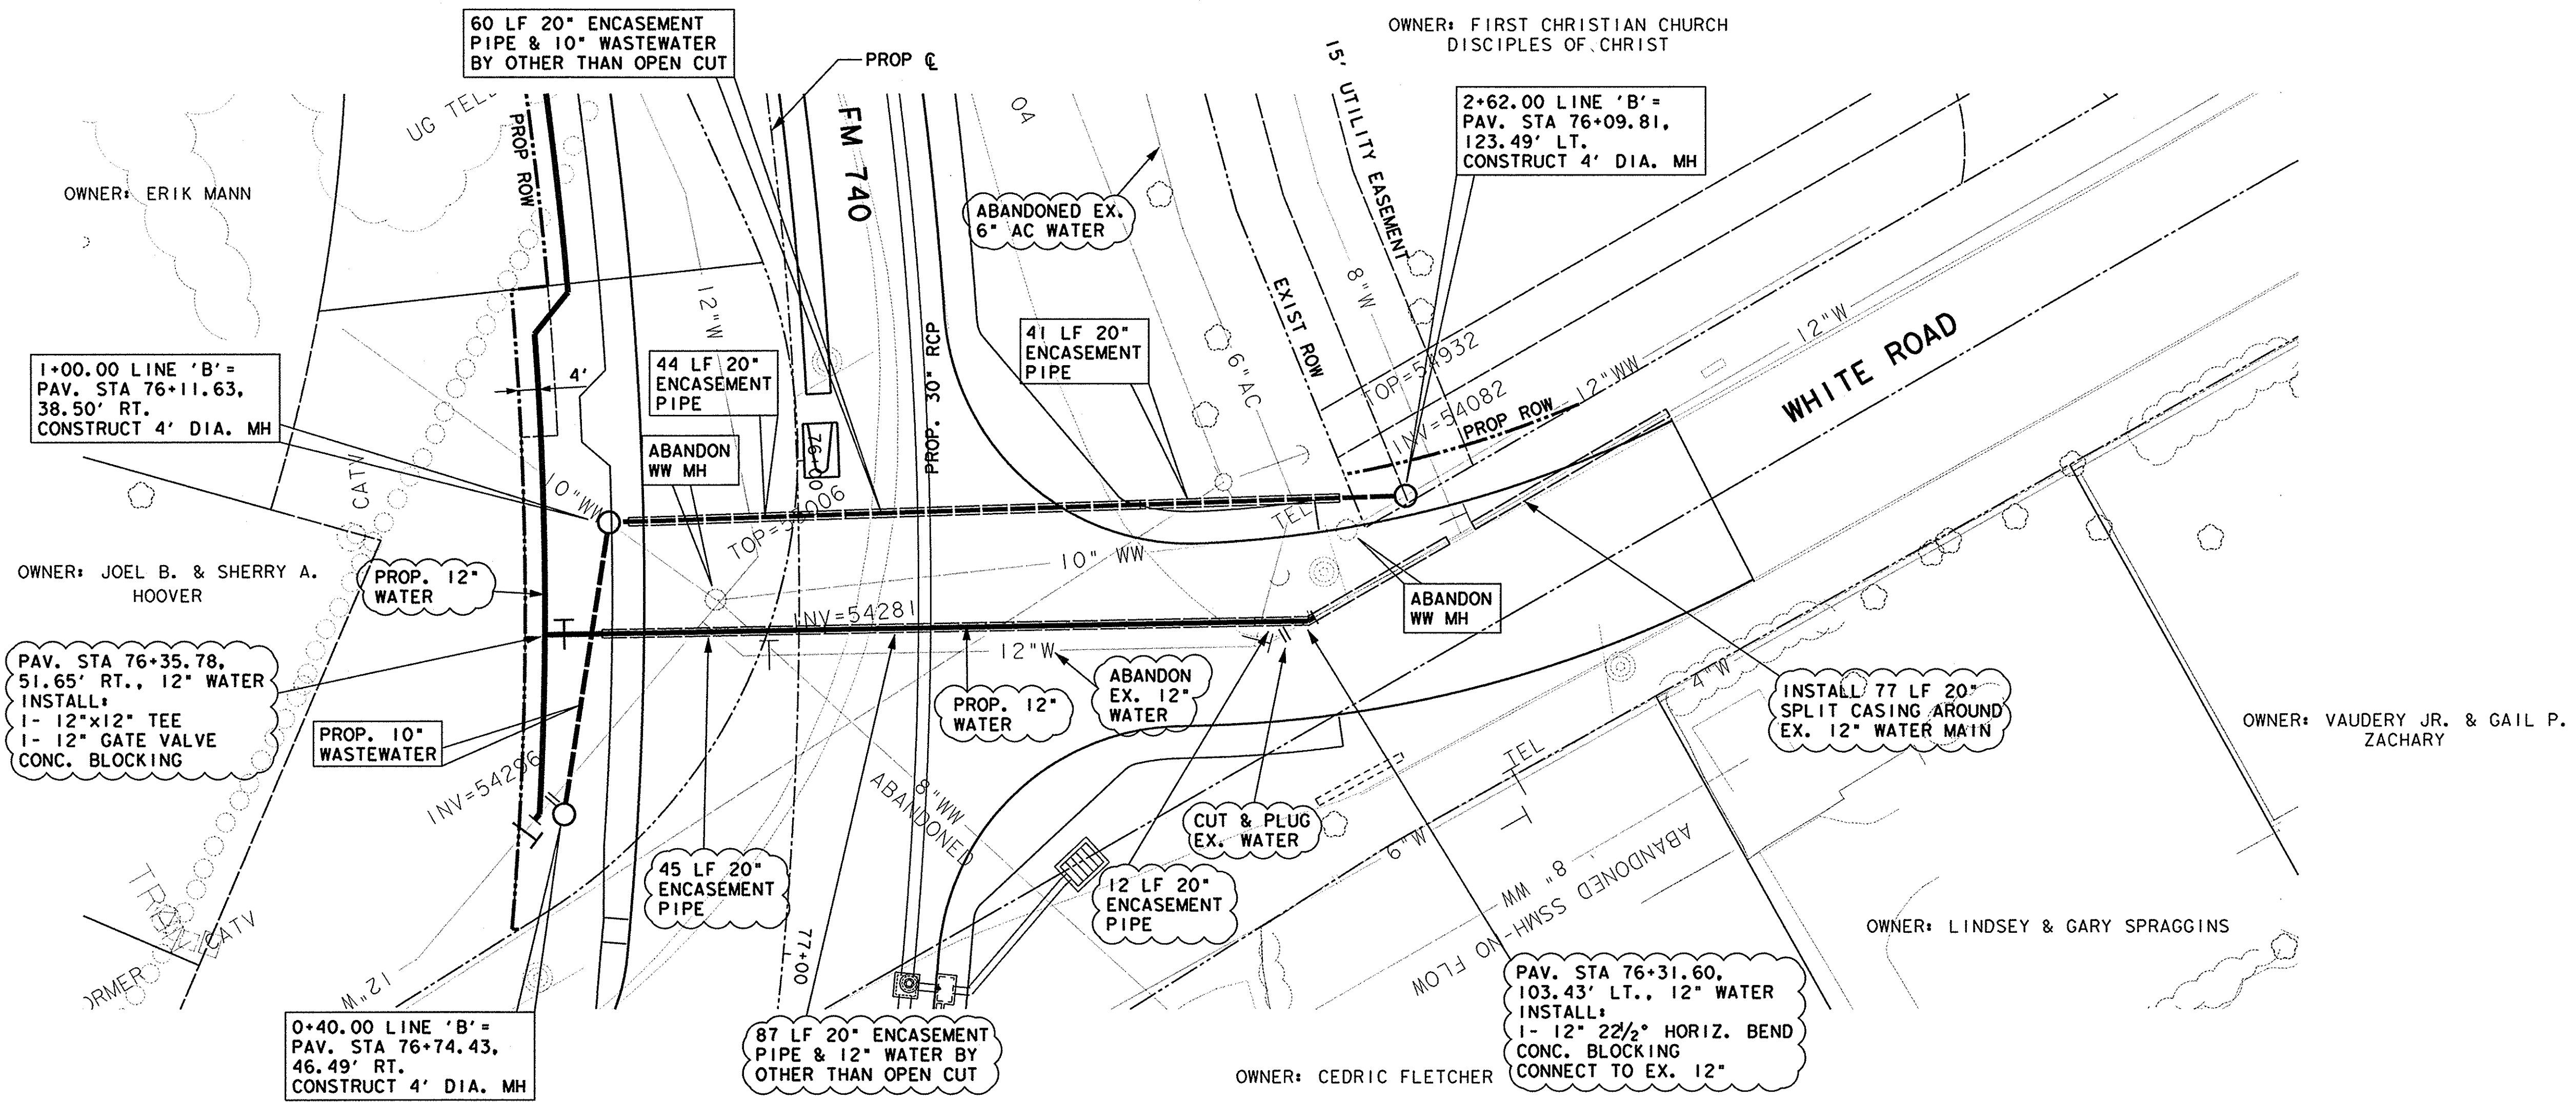


OWNER: FIRST CHRISTIAN CHURCH
DISCIPLES OF CHRIST

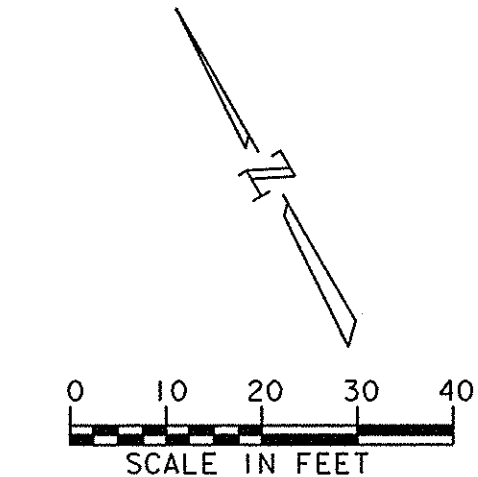

THE SEAL APPEARING ON THIS DOCUMENT WAS AUTHORIZED BY KENNETH A. ROBERTS, P.E. 55446 ON AUGUST 24, 2009

FIRM REGISTRATION NO. F-761

RECORD DRAWINGS AUGUST 13, 2010
THIS RECORD DOCUMENT HAS BEEN PREPARED BASED ON INFORMATION PROVIDED BY OTHERS. THE CONSULTANT HAS NOT VERIFIED THE ACCURACY AND/OR COMPLETENESS OF THIS INFORMATION AND SHALL NOT BE RESPONSIBLE FOR ANY ERRORS OR OMISSIONS THAT MAY BE INCORPORATED AS A RESULT OF ERRONEOUS INFORMATION PROVIDED BY OTHERS.

FM 740

WATER PLAN & PROFILE

WHITE ROAD

HORIZON ROAD TO WELLINGTON LANE

HUITT-ZOLLARS

CITY OF ROCKWALL, TEXAS

DESIGN	DRAWN	APPR.	SCALE	DATE	PROJECT NO.	NO.
HZI	HZI	KAR	H: 1"=20' V: 1"=2.5'	AUGUST 2009	01-3713-01	23

USER: THERESSA
 SCALE: SCALE=20.000000
 P:\TBL\Y8HW\FULL.TBL
 I:\NPROJ\01371301\dgn\371301\UWT16.dgn
 8/13/2010 11:18:21

I:\NPROJ\01371301\dgn\371301\UWT16.dgn
 8/13/2010 11:18:21